


28.9.93



Shell plating not reduced
in way of well.

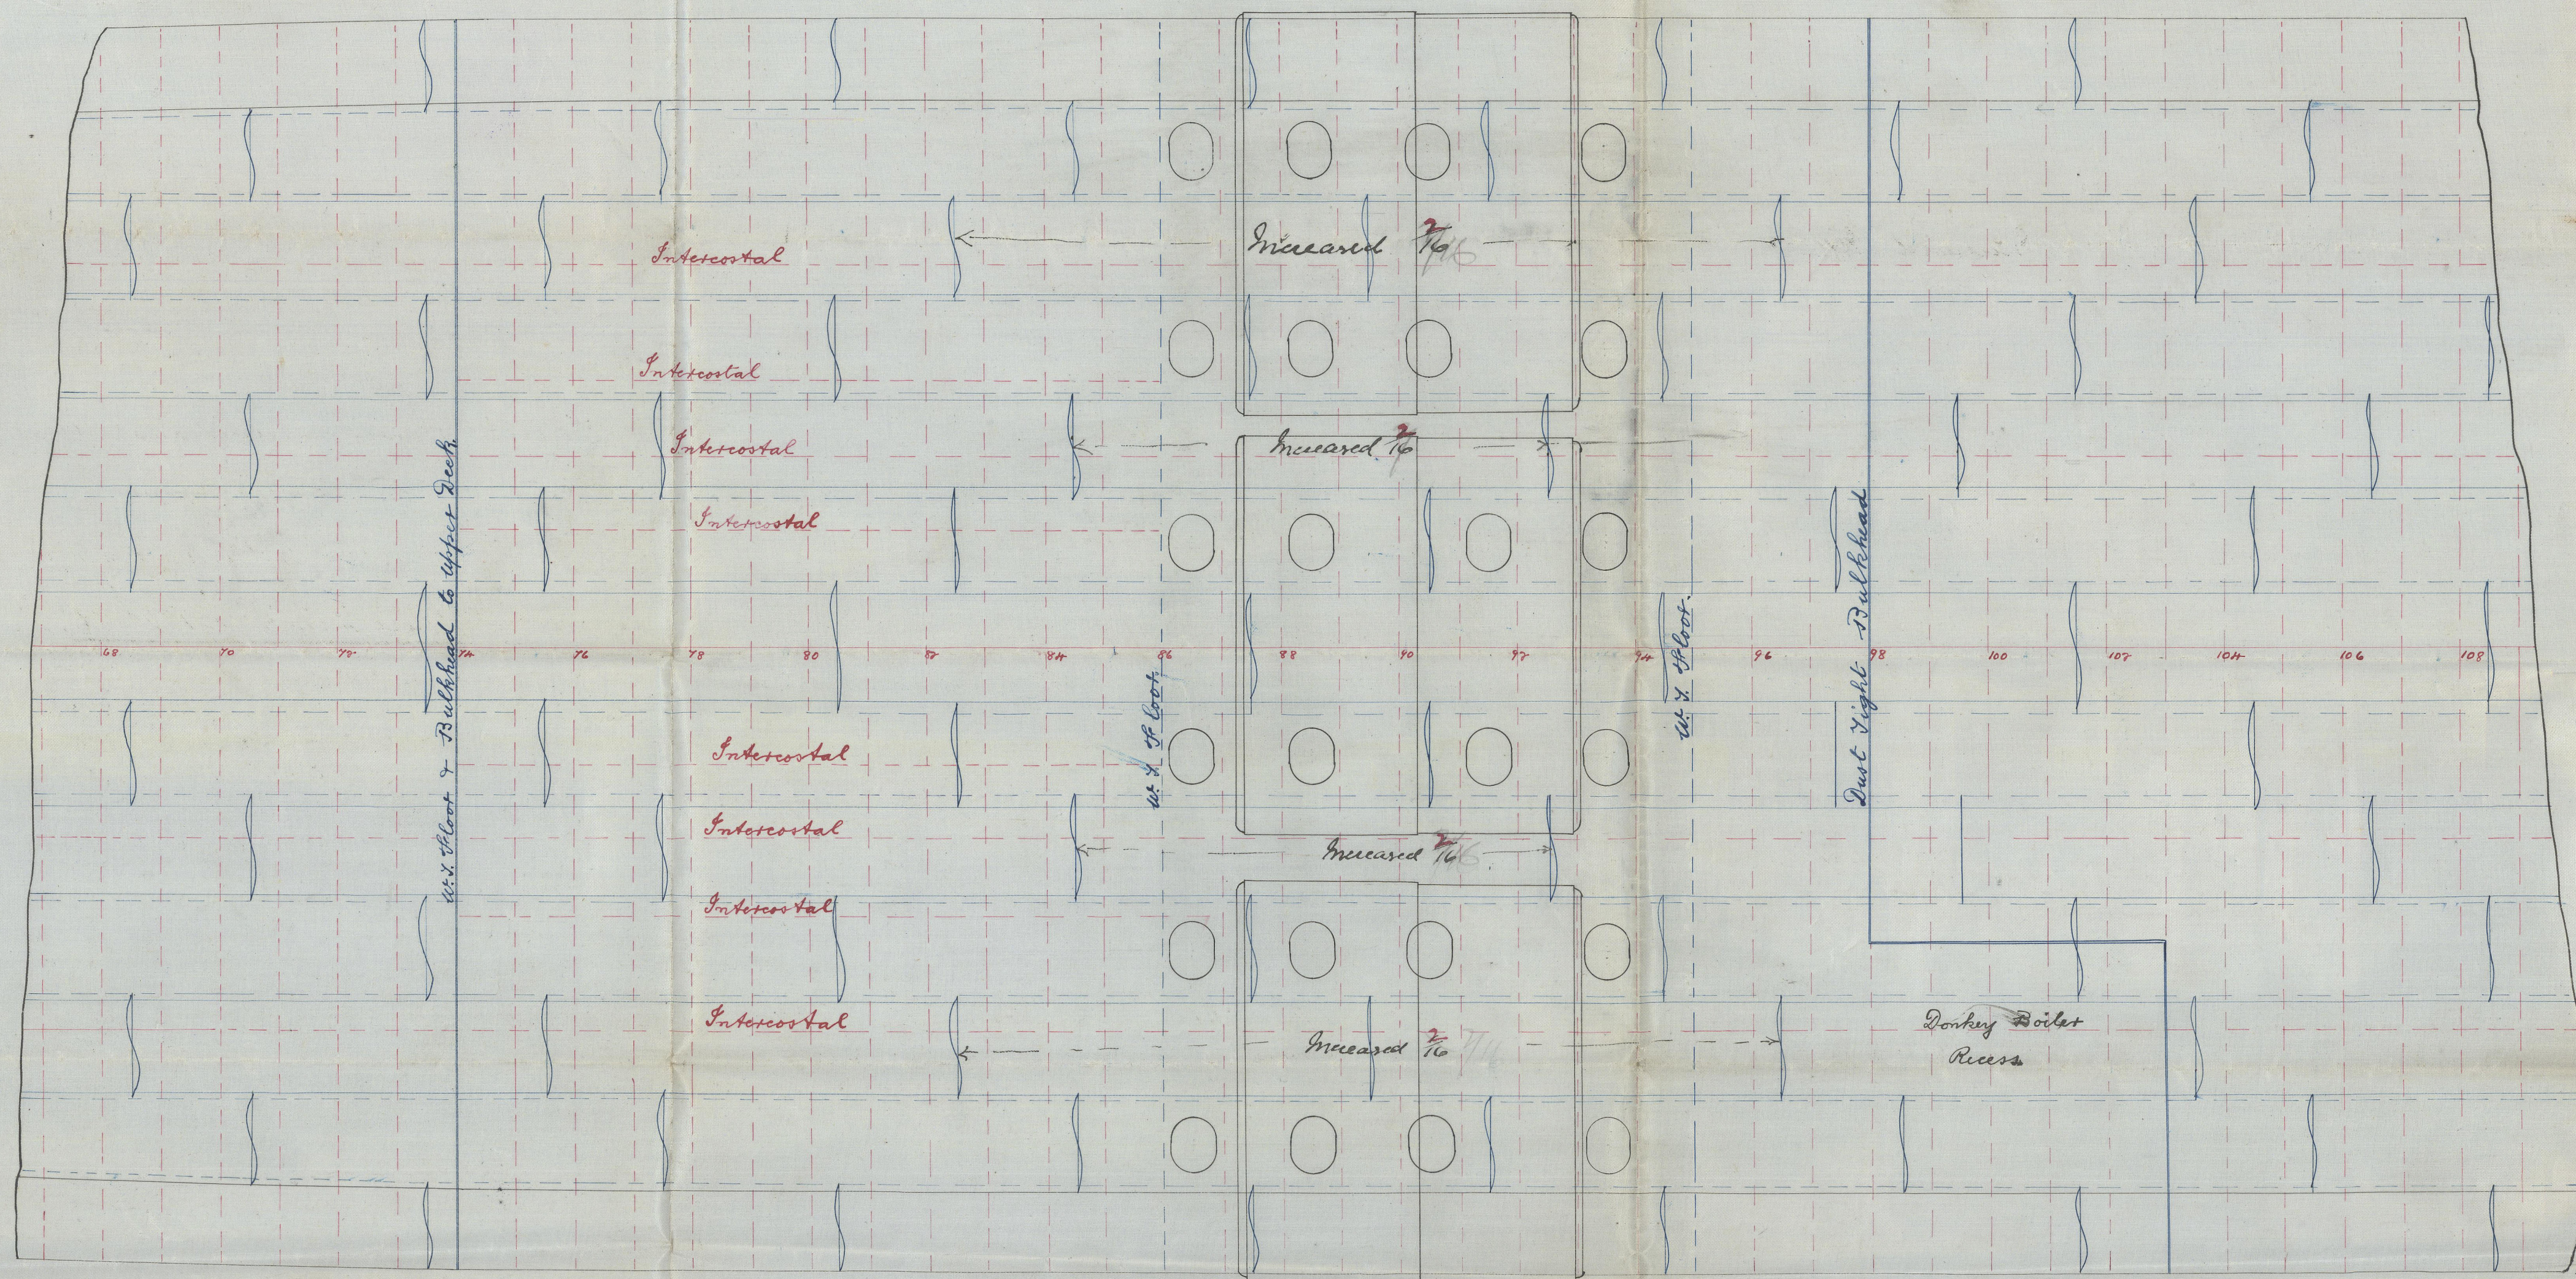

No. 343- "Strathgairn"
No. 344- "Strathairly"

Sketch shewing additional manholes —
— in Boiler Space —
— L.S. 7th 343 & 344 —
— Scale 1/4 inch = 1 Foot. —



90. Russell's
~~274~~ 343

Markholes in
Boil. space

'Sheshar'
Gk. Rpt. 11006
Sharkacly
Gk. Rpt. 11041



907 BR
GRK327-0084