

Received at



Lloyd's Register of British and Foreign Shipping.

(Report on Vessel No. _____ Port _____)

No. **4188** SHIP FORGINGS ~~OR CASTINGS~~.

The words FORGINGS or CASTINGS, IRON or STEEL, should be struck out as may be required.

I have to report that the undermentioned Iron ~~or Steel~~ Forgings ~~or Castings~~,
 manufactured by *The Portland Forge Coy*
 of *Kilmarnock* for the Vessel No. *343*, being built
 by *Messrs Russell & Coy* of *Port Glasgow*
 have been inspected by me as set forth below, and found to be, so far as can be seen,
Sound & efficient


Mark on Forgings.

Lloyd's
 No. *4188*
W. H.

William Hamilton
Glasgow
16/9/93

	STERN FRAME.	RUDDER FRAME.	STEM.
Material*	<i>Scrap iron</i>		
How made	<i>Forged</i>		
Dimensions	<i>11+7</i>		
Progress on Inspection	<i>Forging & smithing</i>		
Date when Inspected	<i>19. 22. 30/6/93. 3. 6. 11 18. 20/7/93. 14. 21. 24 29. 31/8/93. 5. 7. 11. 12/9/93</i>		

SKETCHES OF FRAMES SHOWING POSITION AND DESCRIPTION OF WELDS OF FORGINGS, OR PARTICULARS OF TESTS APPLIED TO CASTINGS.

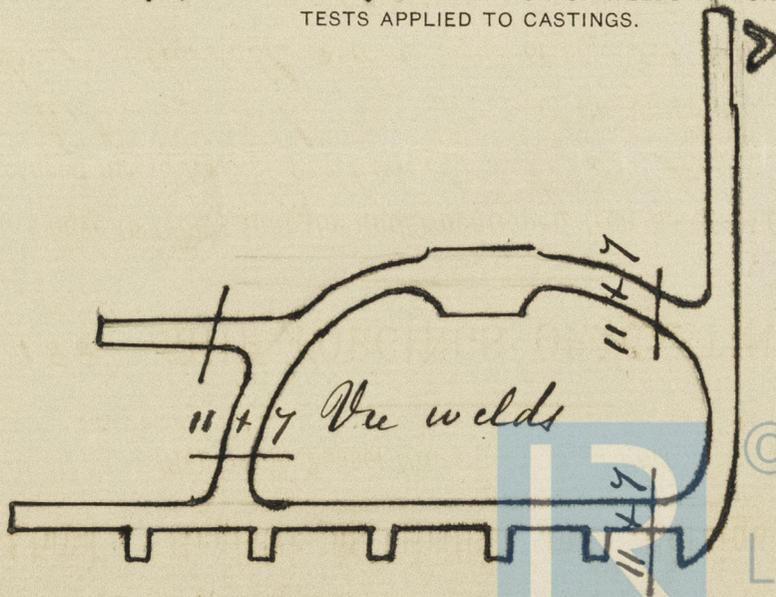

* If of Iron, state whether scrap or puddled Iron.

