

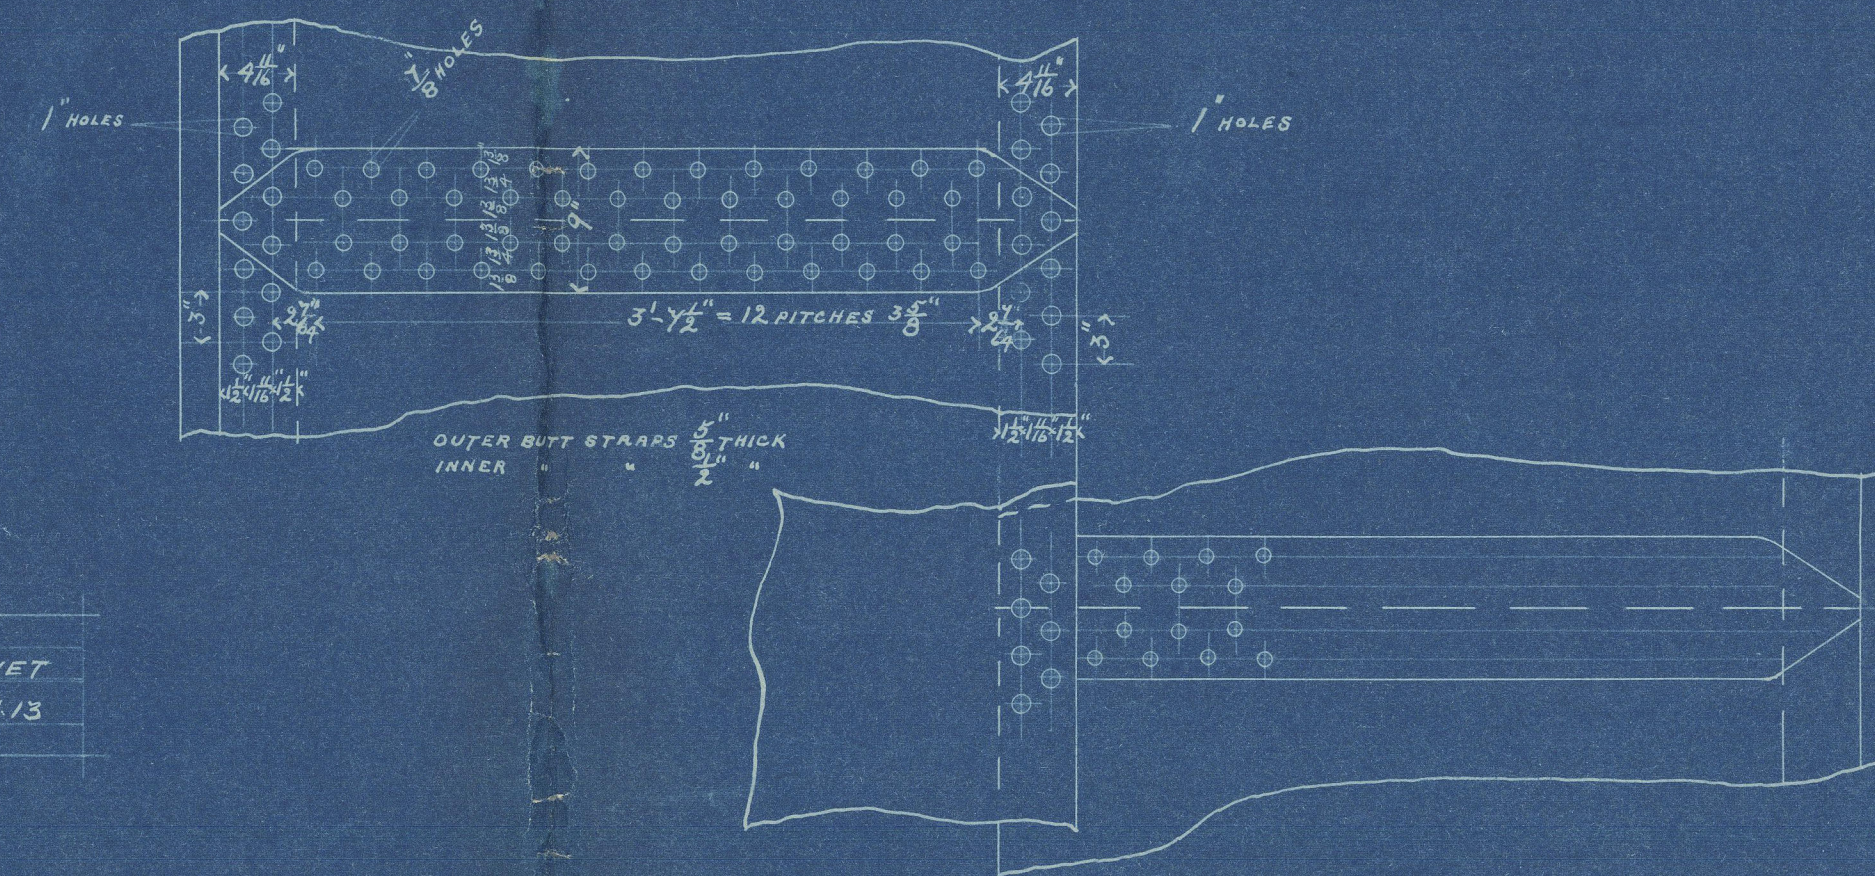


28.93

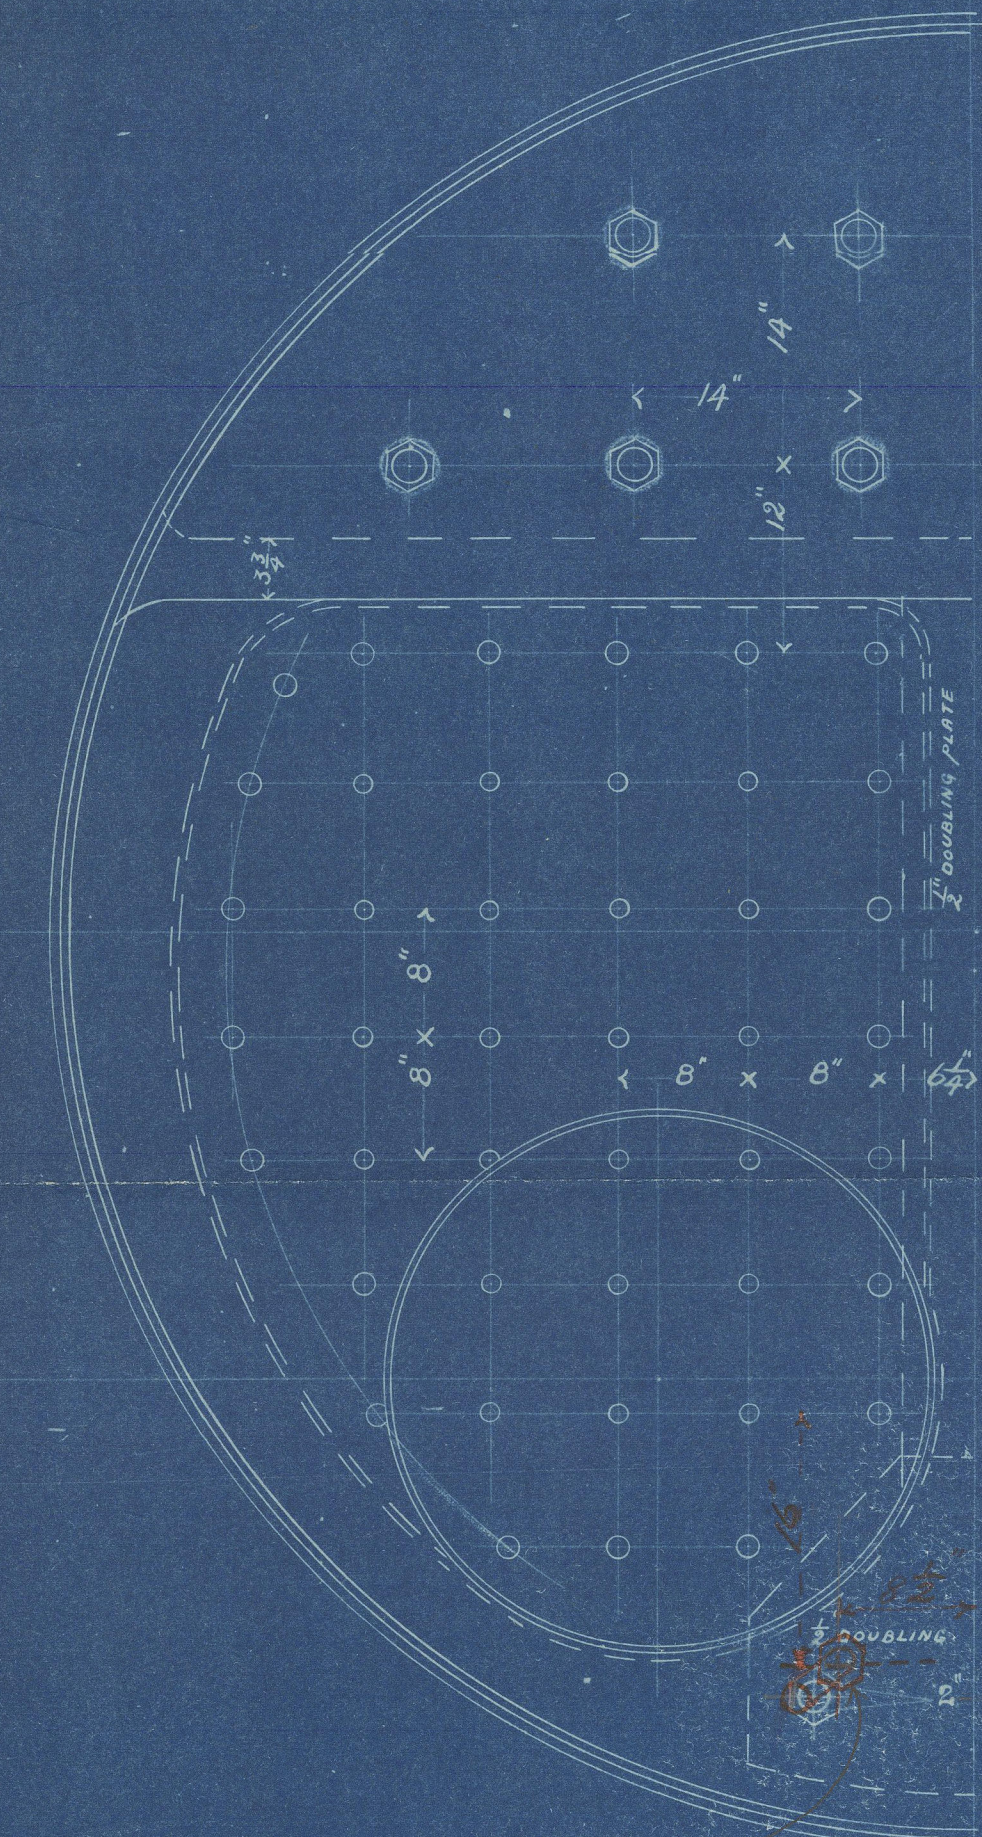

Nº312 & 313 DONKEY BOILER

SCALE 1" = 1 FOOT
TO PASS LLOYD'S SURVEY FOR A WORKING PRESSURE OF 100 LBS PER SQ INCH
ALL STEEL EXCEPT TUBES

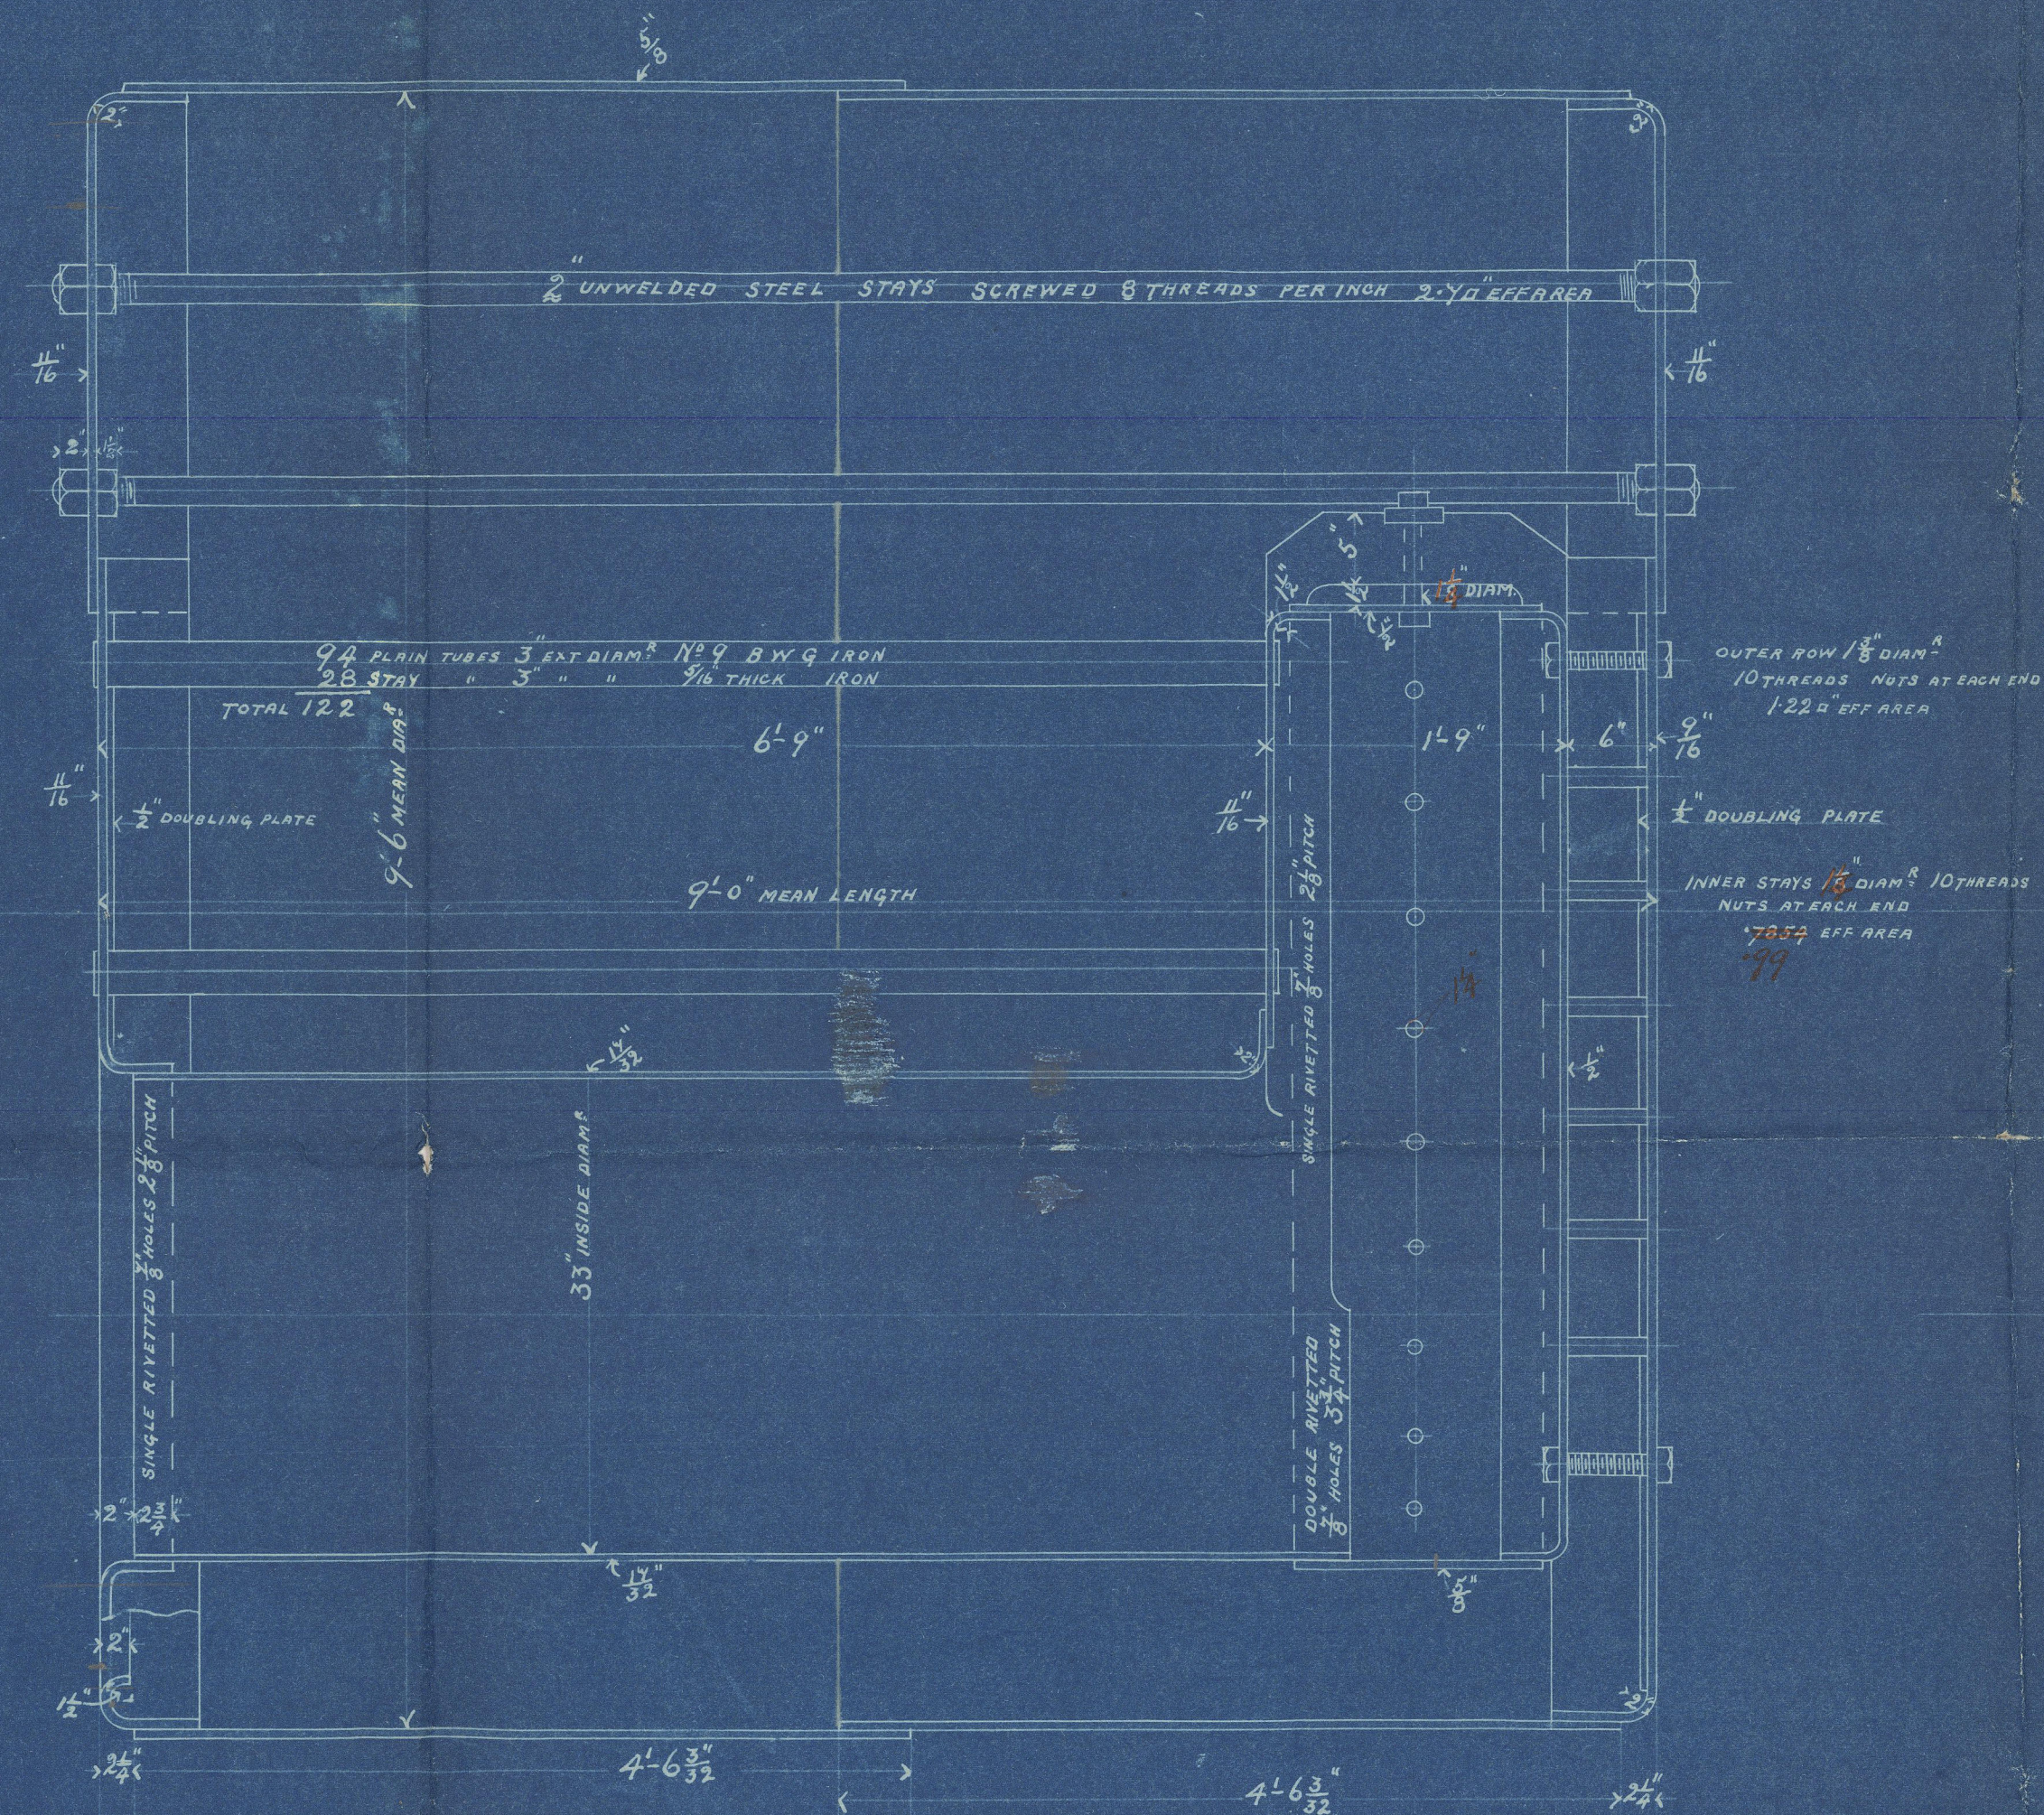

HEATING SURFACE	SQ FT
TUBES	664.7
PIPEWORK	60.5
BACK TUBE PLATE	24.0
CHAMBERS	100.0
TOTAL	851.6

PERCENTAGES	PLATE	RIVET
LLOYD'S	75.86	79.13

In Reply, please send 3434344
Exam 31/7/93
LCCN
9/1/93

Design by Mr. B. F. F.

From BLACKWOOD & GORDON,
For ENCLOSURE to


*Hoyds Surveyor
Greenock*

Blackwood & Gordon's bidens for
Russell Lloyd 3487344
Donkey Boilers



s.s. "Sharkbay"
Greenock Rpt. 11006

s.s. "Shething"
Grp. Rpt. 11041

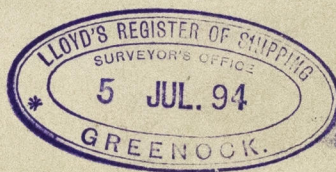

© 2021

Lloyd's Register

Foundation

GRK327-01311