



— SCALE $\frac{1}{8}$ INCH = 1 FOOT.

115 & 116
Approved
13.2.94

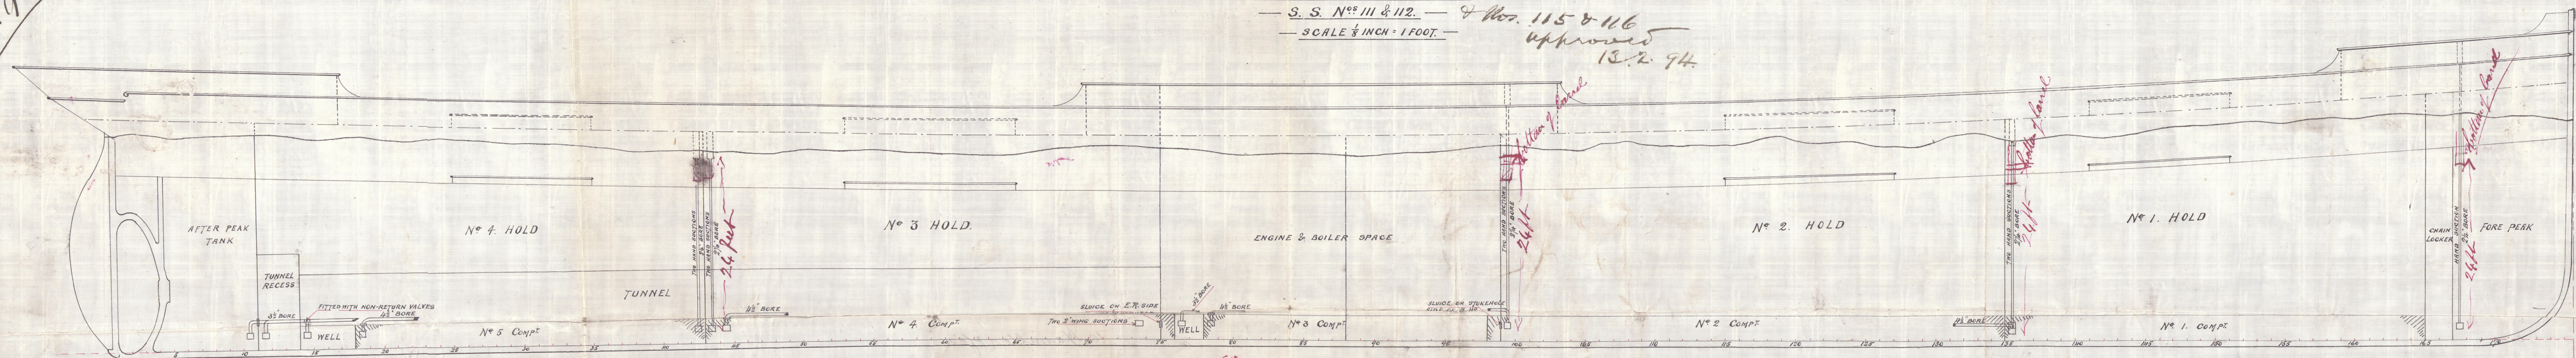


— ELEVATION —

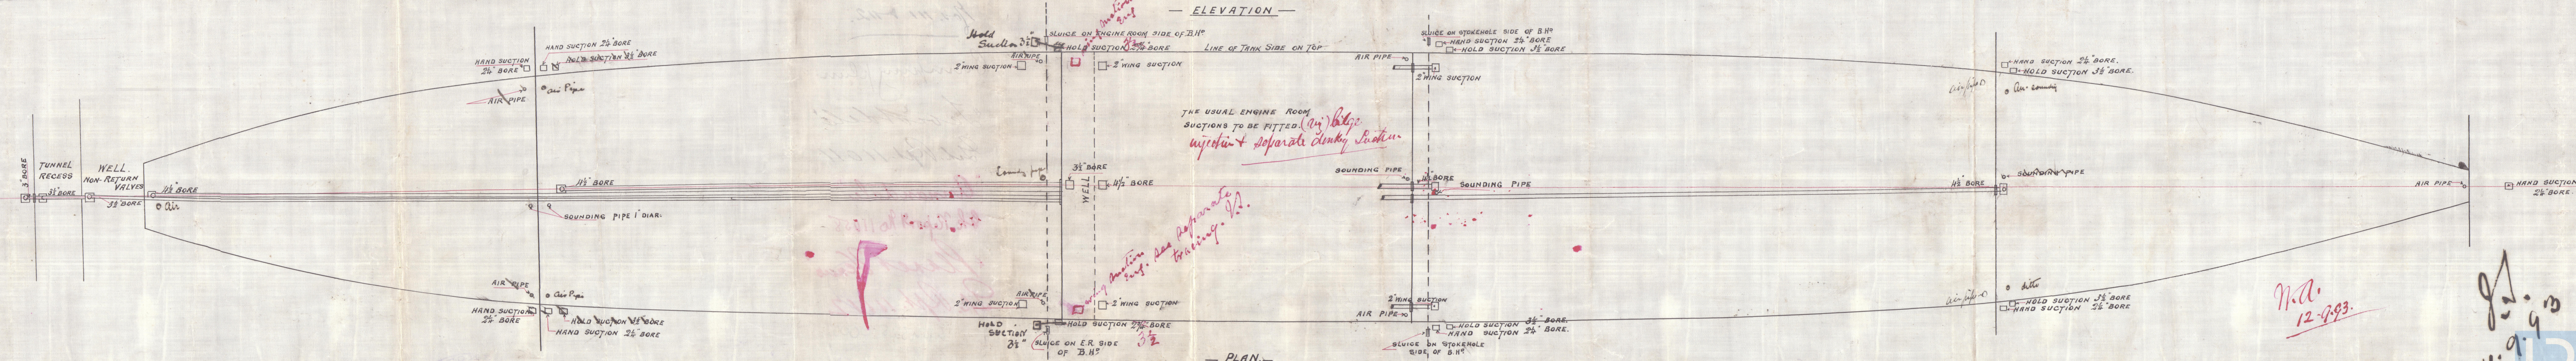

— PLAN. —

W.A.
12-9-93.

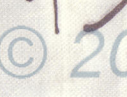

 © 2020

Lloyd's Register
Foundation

APW378-0005

W. Hamilton Esq's

Nos. 111 & 112.

Camping plan

"Levi'sdale"

Sk. Rpt. 11011

"Annandale"

Sk. Report No 11058

"Planet Venus"

Sk. Rpt. 11112

GRN 328-0000



© 2020

23 AUG. 94

Lloyd's Register
Foundation