


31.10.93.

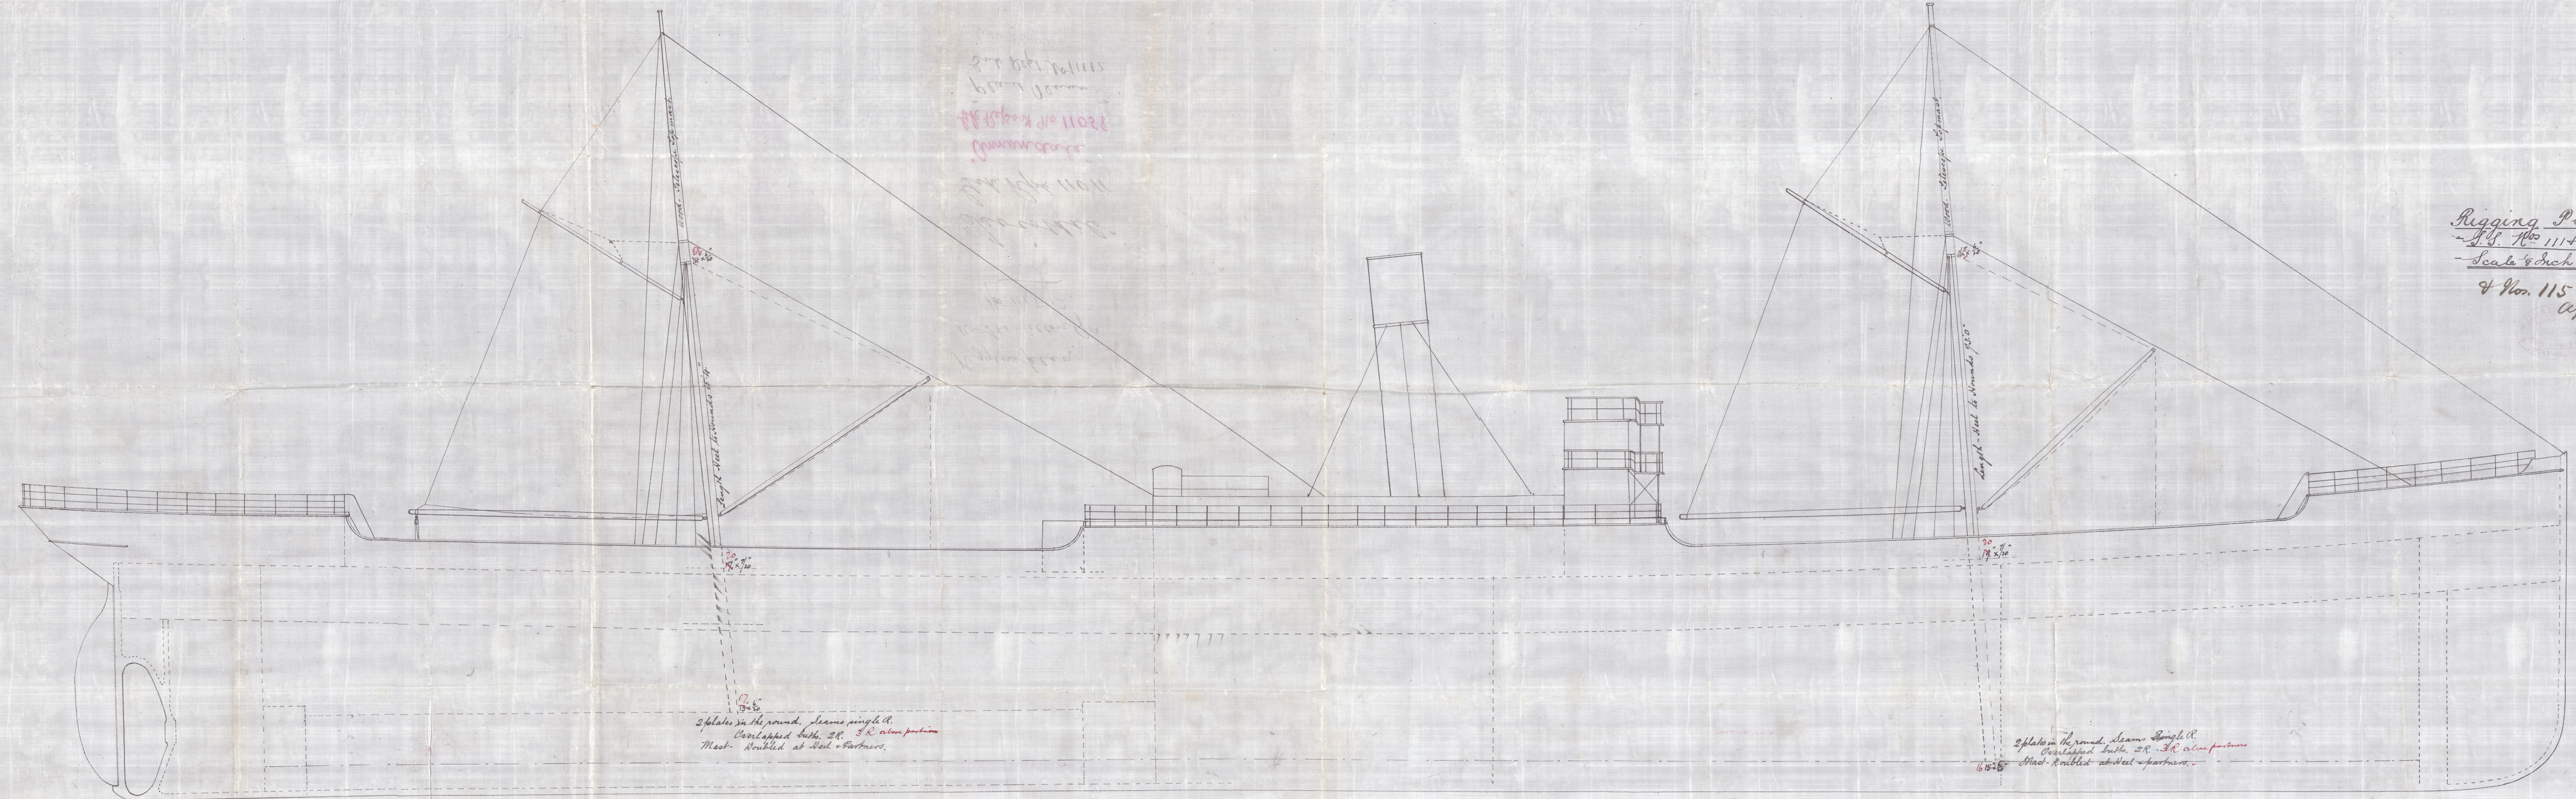

Rigging Plan

S.S. No 111 & 112

Scale 1/4 inch = one foot

& Nos 115 & 116

Approved

13.2.94.

Rigging plan.

W. Hamilton Jnr

No. 111512.

"Leviathane"

Gr. Rpt. 11011

"Annandale"

Gr. Report No 11058

"Plant Venus"

Gr. Rpt No 11112

GRN 328-0008



Lloyd's Register
Foundation