


7.12.93.
 No: 114 1/5.
 No: 31.1.94

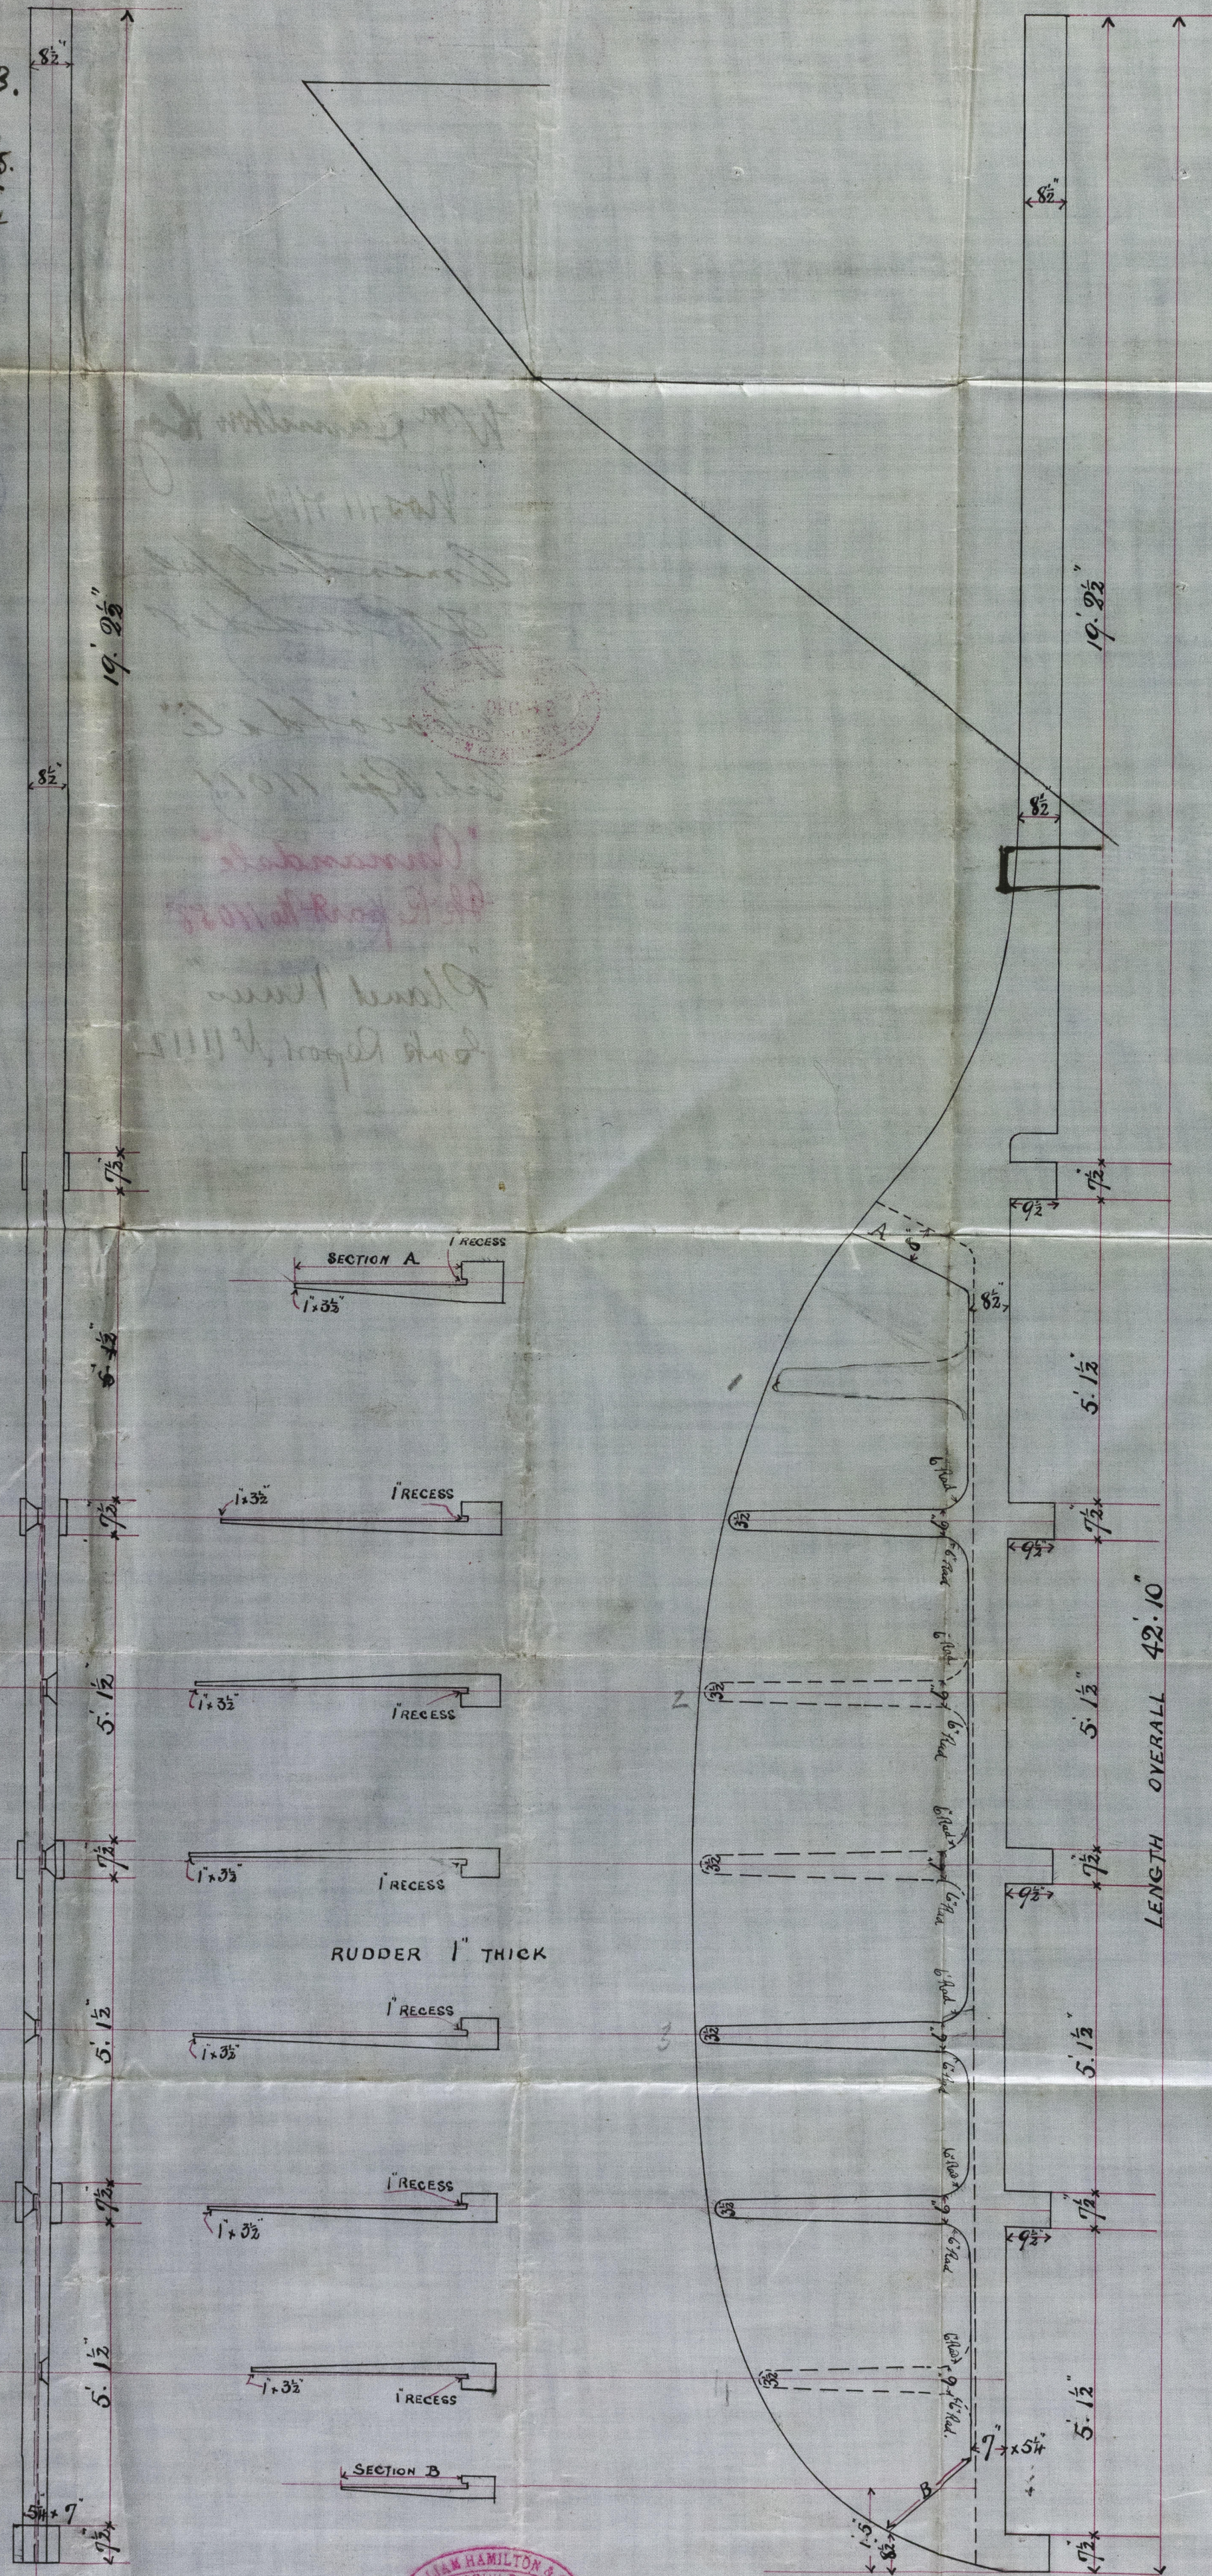

WILLIAM HAMILTON & CO.
 SHIPBUILDERS
 5-DEC.93
 NEWARK SHIPBUILDING YARD
 PORT-GLASGOW.

— AMENDED —
 — PLAN of RUDDER —
 — S. S. N^{os} III & II2 —
 — SCALE 1/2 INCH = ONE FOOT. —

WILLIAM HAMILTON & CO.
 SHIPBUILDERS
 5-DEC.93
 NEWARK SHIPBUILDING YARD
 PORT-GLASGOW.

115 & 116
 Approved
 13.2.94

WILLIAM HAMILTON & CO.
 SHIPBUILDERS
 5-DEC.93
 NEWARK SHIPBUILDING YARD
 PORT-GLASGOW.

REGISTER OF SHIP
 SURVEYORS
 OFFICE
 GREENE

Wm Hamilton Key

Nos III 412

Amended plan
of Rudder

"Torioldale"

Sub. Rpt. 11011

"Annandale"

Sub Report No 11058

"Planet Venus"

Sub Report No 11112

ARH328-0009

Lloyd's Register
Foundation