


WILLIAM HAMILTON & CO.
SHIPBUILDERS

24 August.
1893.

NEWARK SHIPBUILDING YARD
PORT-GLASGOW

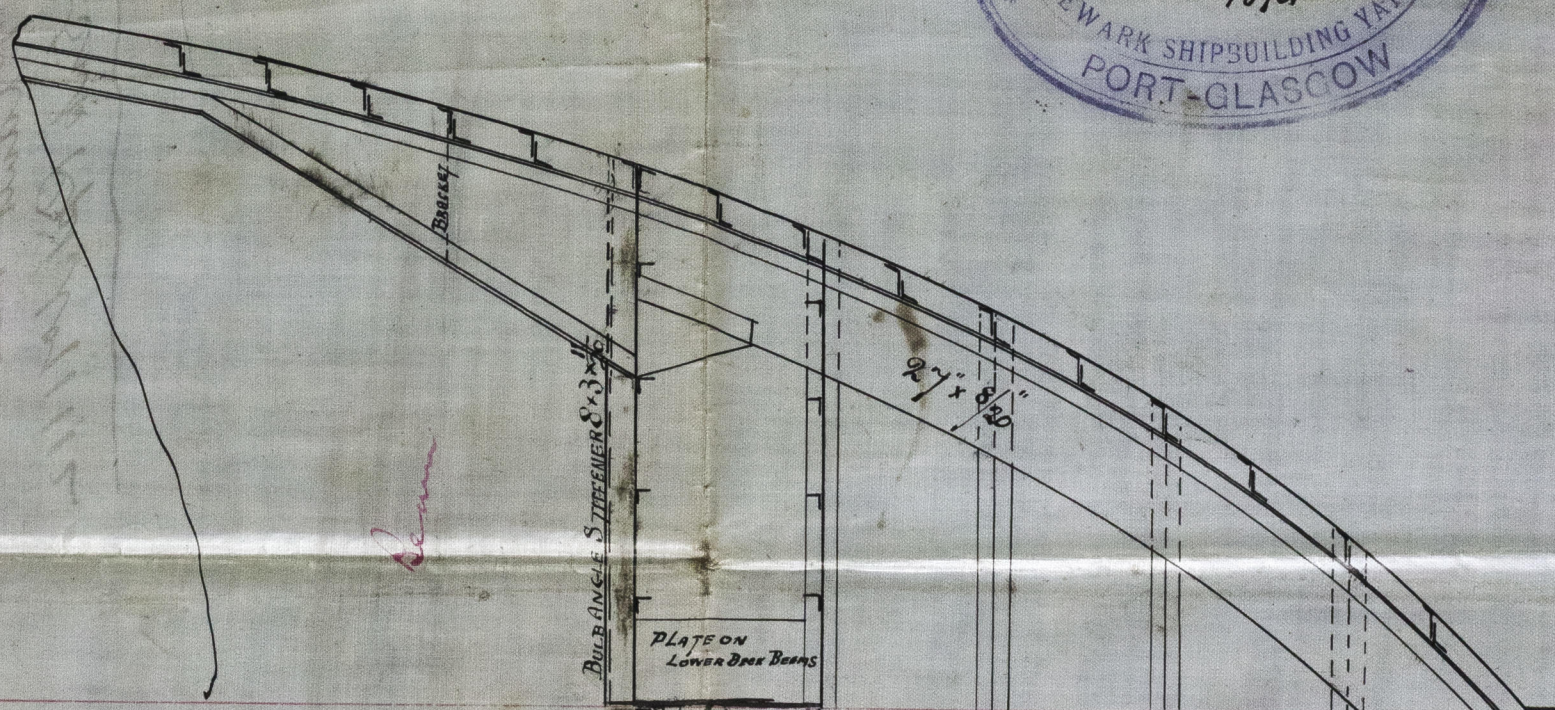


Approved
13.2.94.



W^m Hamilton & Co.

S.S. N^o 111 & 112.

-Painting arranged

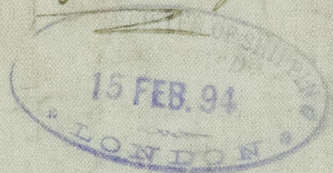

"Leviotdale"

Gen. Rpt. 11011

"Annandale"

Gen. Report No 11058

"Plant Venus"

Gen. Rpt. No 11112

GRW328-001



© 2019

Lloyd's Register
Foundation