

# Lloyd's Register of British and Foreign Shipping.

(Report on Vessel No. \_\_\_\_\_ Port \_\_\_\_\_)

No. 4257 SHIP FORGINGS ~~OR CASTINGS.~~

I have to report that the undermentioned Iron <sup>or</sup> ~~or~~ Steel Forgings ~~or Castings~~,  
 manufactured by Messrs William Beardmore & Coy  
 of Glasgow for the Vessel No. 111, being built  
 by Messrs Wm Hamilton & Coy of Port Glasgow  
 have been inspected by me as set forth below, and found to be, so far as can be seen,  
Sound & efficient

The words FORGINGS or CASTINGS, IRON or STEEL, should be struck out as may be required.

Mark on Forgings.


Lloyd's  
No. \_\_\_\_\_

William Hamilton  
Glasgow

	STERN FRAME.	RUDDER FRAME.	STEM. <u>Keel bars</u>
Material*	<u>Scrap iron</u>	<u>Siemens martin</u>	<u>Ingot Mild steel</u>
How made	<u>Forged</u>		<u>Rolled</u>
Dimensions	<u>11 x 6 1/2</u>		<u>11 x 2 3/4</u>
Progress on Inspection	<u>Forging &amp; smithing</u>		<u>Smithing &amp; machining</u>
Date when Inspected	<u>30/8/93. 4. 6. 8. 12. 104</u> <u>18. 21. 22. 25. 28/9/93</u> <u>9. 11. 13. 20. 24/10/93</u>		<u>24/8/93. 8. 18. 25. 28/9/93</u> <u>2/10/93. 24/10/93</u>

SKETCHES OF FRAMES SHOWING POSITION AND DESCRIPTION OF WELDS OF FORGINGS, OR PARTICULARS OF

TESTS APPLIED TO CASTINGS.  
2. 29/11/93 1-4 5/12/93

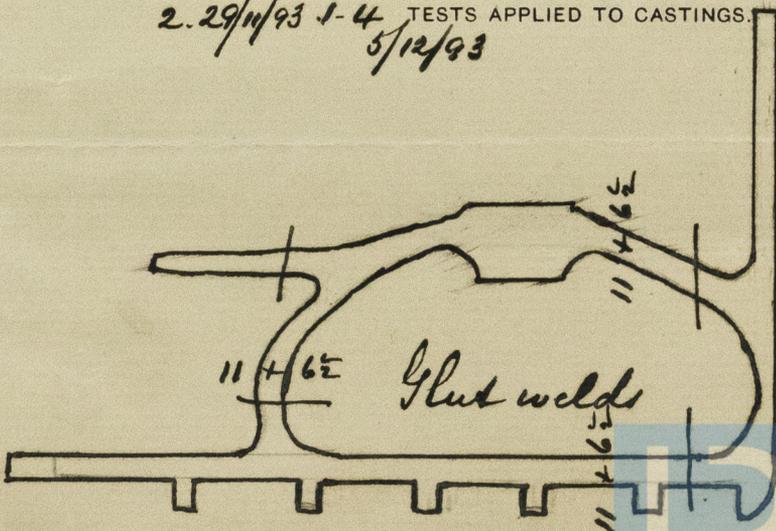

© 2019  
Lloyd's Register  
Foundation  
ARW328-0013