

Lloyd's Register of British and Foreign Shipping.

(Report on Vessel No. _____ Port _____)

No. 4257 SHIP FORGINGS ~~OR CASTINGS~~.

I have to report that the undermentioned Iron or Steel Forgings or Castings, manufactured by The Portland Forge Coy of Kilmarnock for the Vessel No. 111, being built by Messrs William Hamilton & Coy of Port Glasgow have been inspected by me as set forth below, and found to be, so far as can be seen, Sound & efficient

The words FORGINGS or CASTINGS, IRON or STEEL, should be struck out as may be required.



Mark on Forgings.

Lloyd's
No. 4257
WHE

William Hamilton
Glasgow

	STERN FRAME.	RUDDER FRAME.	STEM.
Material* ...	/	Scrap iron	/
How made ...		Forged	
Dimensions ...		8 1/2 to 4 1/4	
Progress on Inspection		Forging & smithing	
Date when Inspected		18. 21. 126/12/93. 19. 23. 13/1/94. 13. 21. 23. 27/2/94. 1. 5. 21. 28/3/94 3. 6/4/94	

SKETCHES OF FRAMES SHOWING POSITION AND DESCRIPTION OF WELDS OF FORGINGS, OR PARTICULARS OF TESTS APPLIED TO CASTINGS.

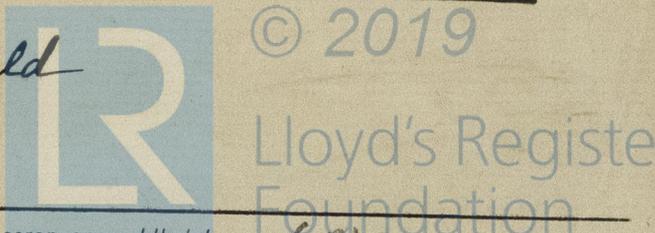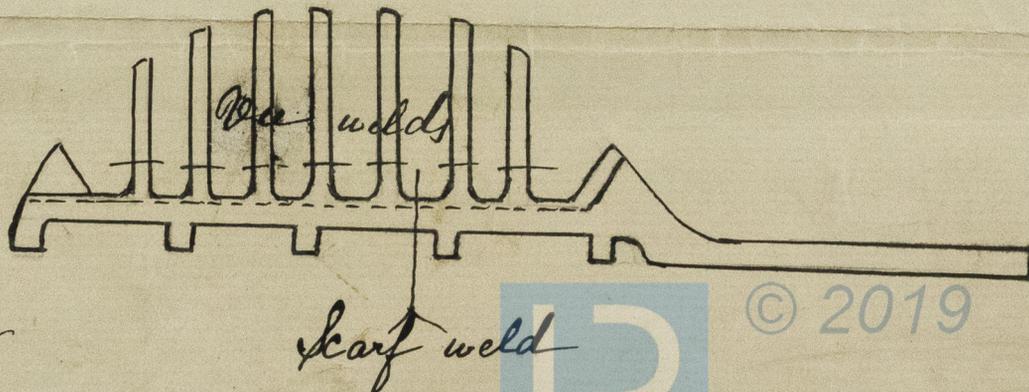

W. Hamilton & Co
Foreign Certificates etc
No 111

"Levi's" etc
Arch. Rpt. 11011



© 2019

Lloyd's Register
Foundation