




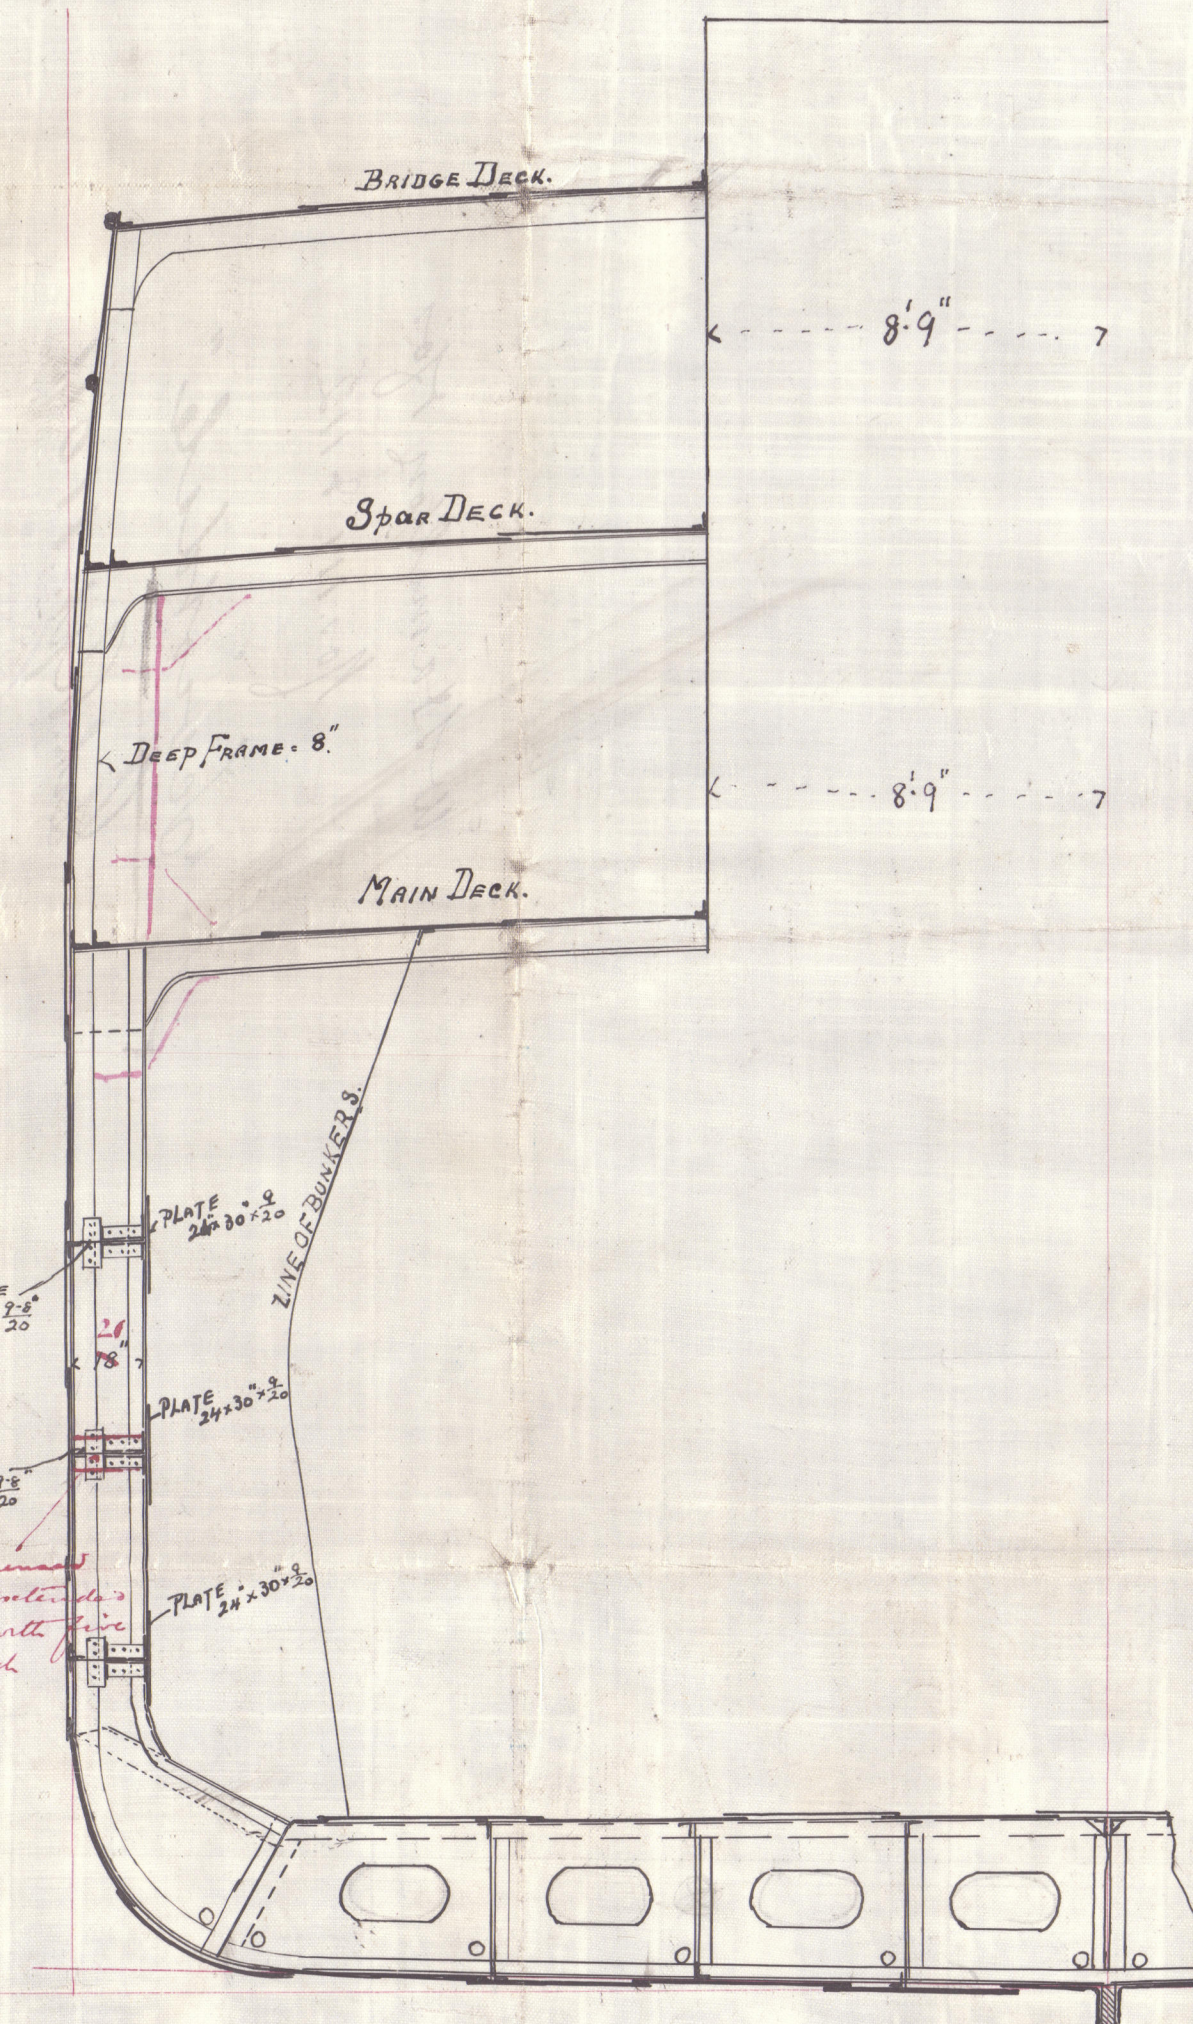

SECTION. THRO
EY B. SPACE.

—SS" Nos 111 & 112— & Nos. 115 & 116

SCALE = $\frac{1}{4}$ INCH = ONE FOOT

Approved
13. 2. 94



© 2020

Lloyd's Register
Foundation

GRN 328-000

W. Hamilton 1701
Nos. 111 & 112.

"Sciothdale"

Sub. Rpt. 11011

Web frames

"Planet Venus"

Sub. Rpt. No 11112

ARH328-0021



© 2020

Lloyd's Register
Foundation