

Handwritten notes in the top left corner, including "P&S" and "Midship section".

"King David"


MIDSHIP SECTION

No 359

SCALE 1/2 INCH-ONE FOOT

REGISTERED DIMENSIONS 27' 0" x 42' 0" x 24' 3"

Handwritten notes on the left side, including "Midship section" and "P&S".

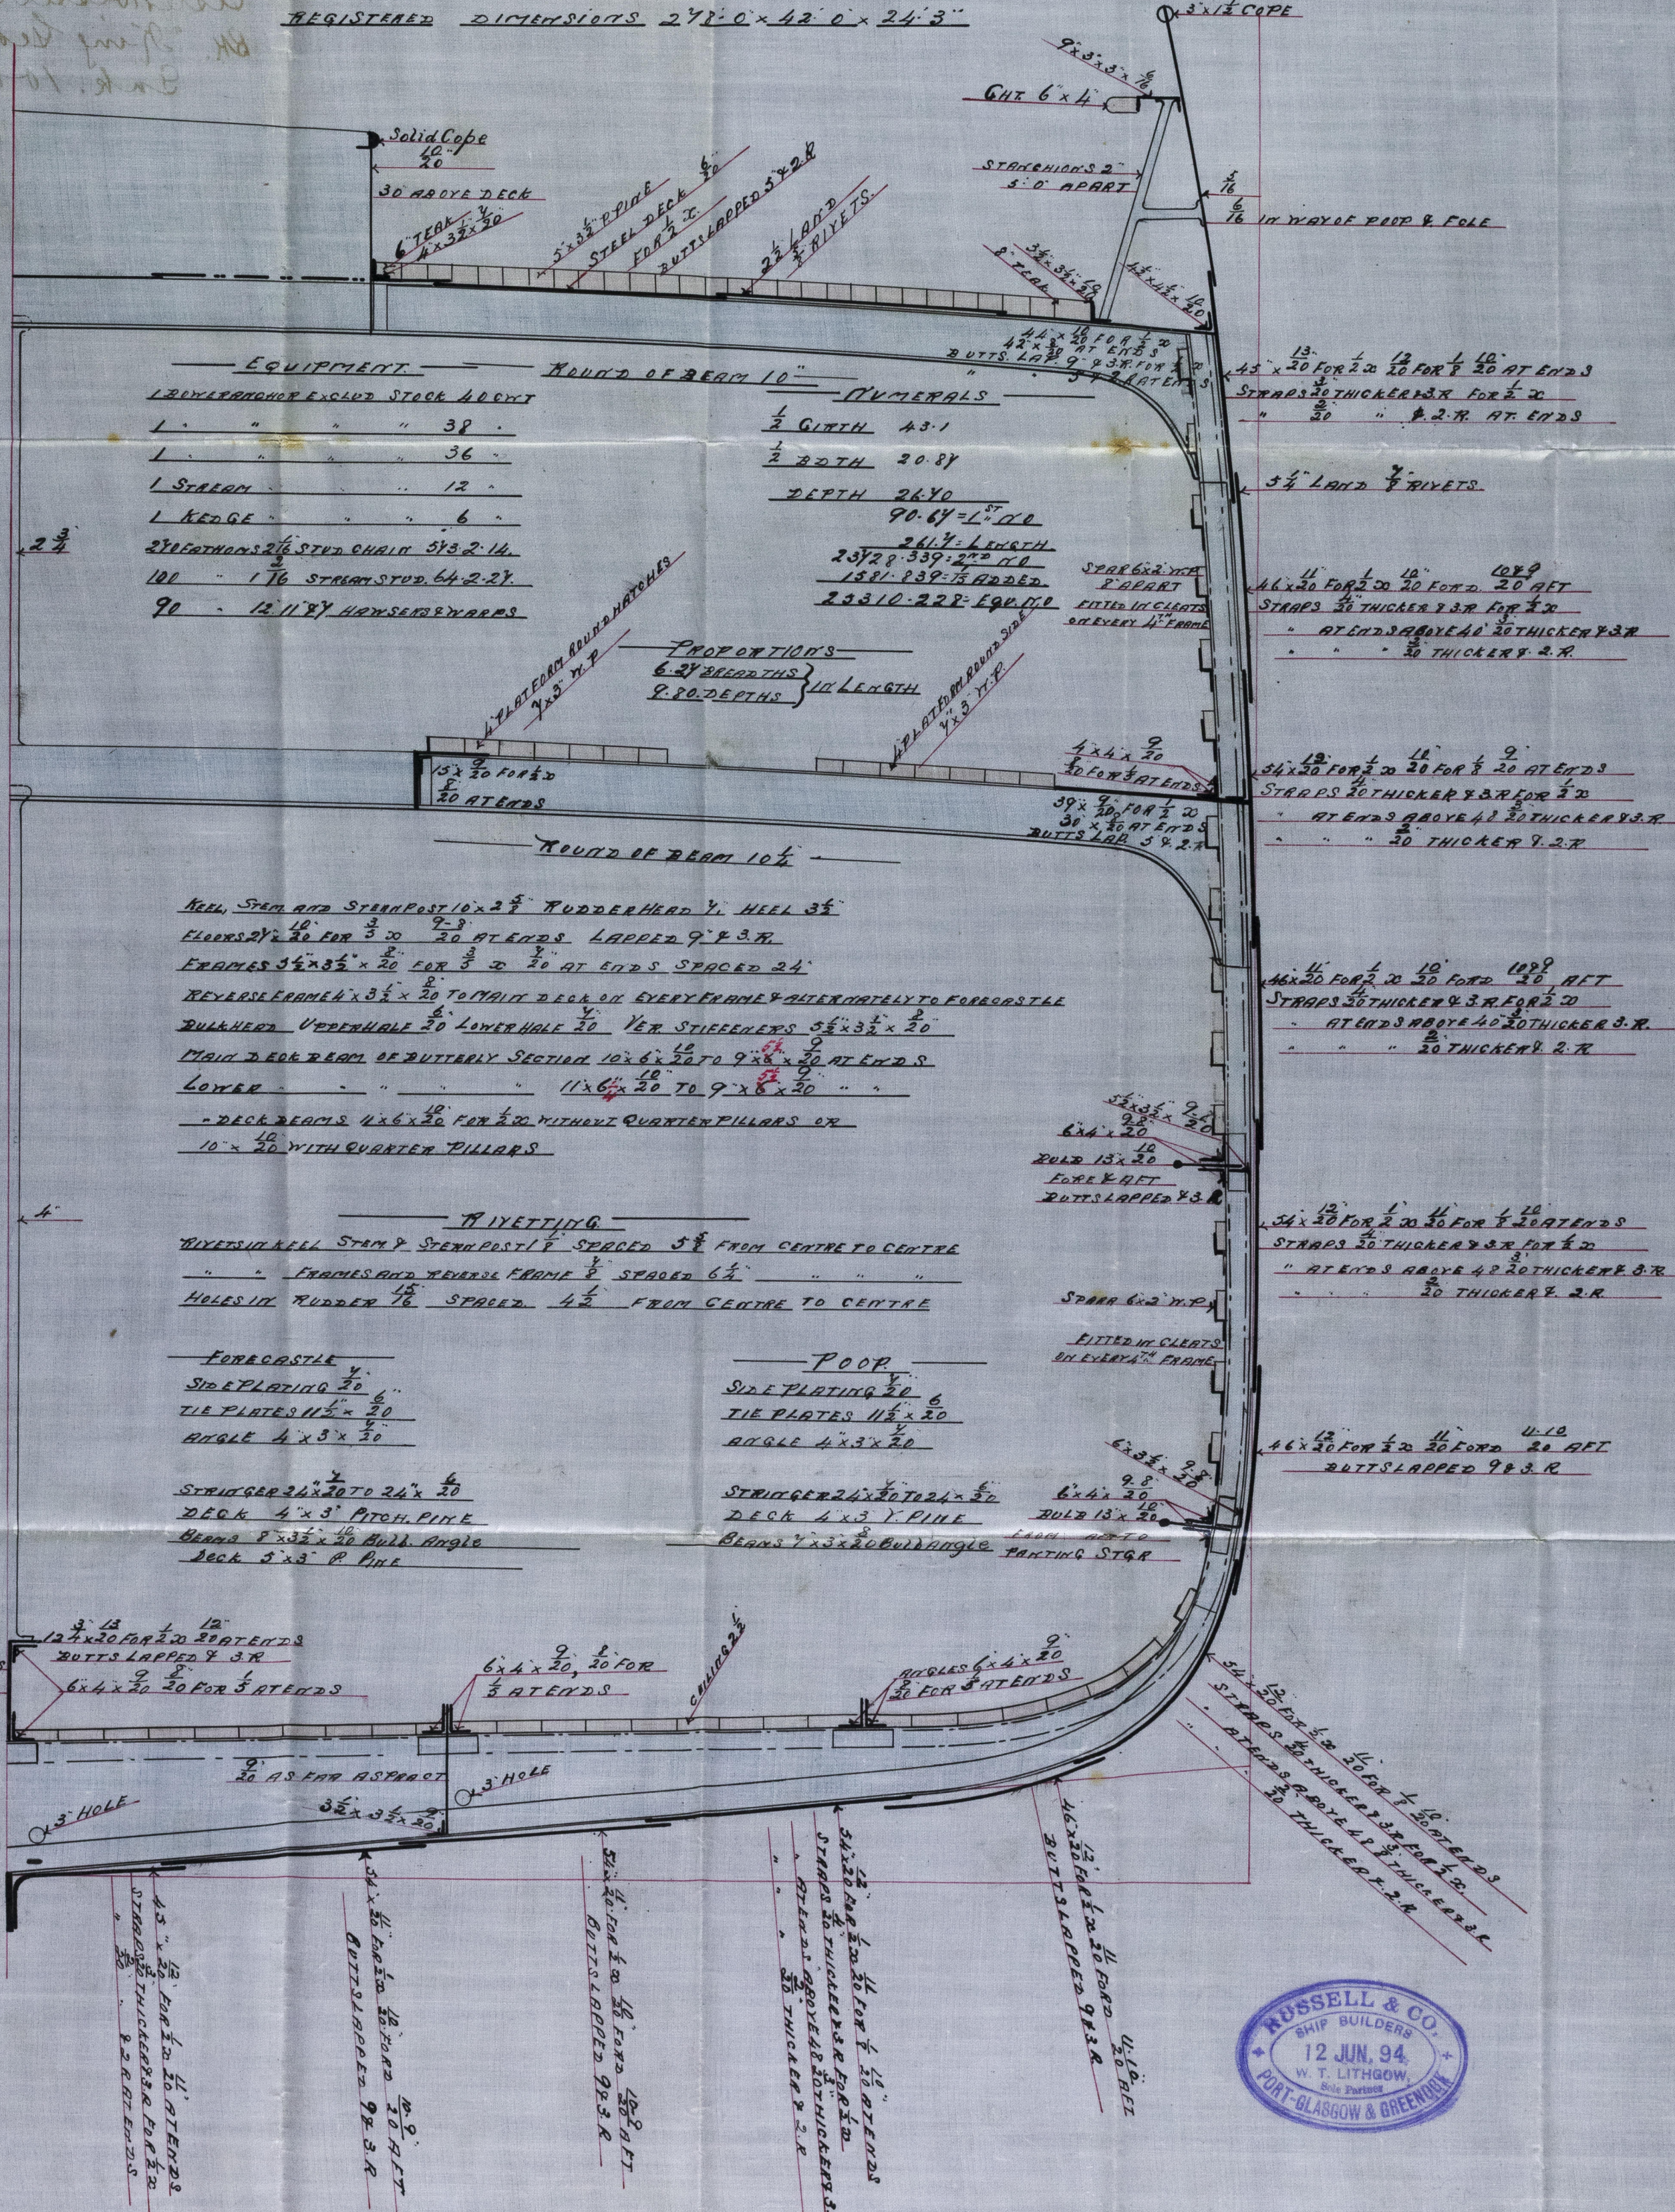

EQUIPMENT

DESCRIPTION	QUANTITY	REMARKS

NUMERALS

DESCRIPTION	VALUE
1/2\"	43.1
1/2\"	20.87
DEPTH	26.40
90.67	1.00

PROPORTIONS
6.25\"

REEL, STERN AND STERNPOST 10 x 2 1/2\"

FLORS 2 1/2\" FOR 3\" TO 20\" AT ENDS LAPPED 9\" 3\" R.

FRAMES 3 1/2\" x 3 1/2\" FOR 3\" TO 20\" AT ENDS SPACED 24\"

REVERSE FRAMES 3 1/2\" x 20\" TO MAIN DECK ON EVERY FRAME & ALTERNATELY TO FORECASTLE

RUDDER UPPER HALF 20\" LOWER HALF 20\" YER STIFFENERS 3 1/2\" x 3 1/2\" x 20\"

MAIN DECK BEAM OF BUTTERFLY SECTION 10 x 6 1/2\" TO 9 x 3 1/2\" x 20\" AT ENDS

LOWER 11 x 6 1/2\" TO 9 x 3 1/2\" x 20\"

DECK BEAMS 4 x 6 1/2\" FOR 3\" TO 20\" WITHOUT QUARTER PILLARS OR 10 x 20\" WITH QUARTER PILLARS

PIVETTING

PIVETS IN REEL STERNPOST SPACED 5\" FROM CENTRE TO CENTRE

FRAMES AND REVERSE FRAMES 1/2\" SPACED 6 1/2\"

HOLES IN RUDDER 1/2\" SPACED 4 1/2\" FROM CENTRE TO CENTRE

FORECASTLE

SIDE PLATING 1/2\"

TIE PLATES 1 1/2\" x 20\"

ANGLE 4 x 3 x 20\"

STRONGER 3 1/2\" x 20\" TO 2 1/2\" x 20\"

DECK 4 x 3\" PITCH PINE

BEAMS 3 1/2\" x 20\" BUILD ANGLE

DECK 5 x 3\" PINE

POOP

SIDE PLATING 1/2\"

TIE PLATES 1 1/2\" x 20\"

ANGLE 4 x 3 x 20\"

STRONGER 2 1/2\" x 20\" TO 2 1/2\" x 20\"

DECK 4 x 3\" PINE

BEAMS 3 1/2\" x 20\" BUILD ANGLE



12.6.94

Russell & Co

No 359

Midship Section



"King David"

Enk. 11029

Sister vessel to the
BK. "King George"
Enk. 10915.

ARK328-0044

© 2019

Lloyd's Register
Foundation