

## Lloyd's Register of British and Foreign Shipping.

(Report on Vessel No. \_\_\_\_\_ Port \_\_\_\_\_)

No. 1958

## SHIP FORGINGS OR CASTINGS.

I have to report that the undermentioned Iron ~~or Steel~~ Forgings ~~or Castings~~,  
 manufactured by *The Jarrow Forge & Co*  
 of *Jarrow* for the Vessel No. *359*, being built  
 by *Messrs Russell & Co* of *Greenock*  
 have been inspected by me as set forth below, and found to be, so far as can be seen,  
*Sound*

Mark on Forgings.

Lloyd's

No. 3103B




JG

John C Craig

Newcastle

	STERN FRAME.	RUDDER FRAME.	STEM.
Material* ...	<i>Scrap Iron</i>	<i>Scrap Iron</i>	<i>Scrap Iron</i>
How made ...	<i>Forged</i>	<i>Forged</i>	<i>Forged</i>
Dimensions ...	<i>10 - 2 5/8</i>	<i>7 - 3 1/2</i>	<i>10 - 2 5/8</i>
Progress on Inspection	<i>Smithed &amp; Finished</i>	<i>Forged &amp; Smithed</i>	<i>Smithed</i>
Date when Inspected	<i>November 8-15-16/23</i>	<i>November 27 Dec 2/23</i> <i>January 10 Feb 5-28/24</i>	<i>November 16/23</i>

SKETCHES OF FRAMES SHOWING POSITION AND DESCRIPTION OF WELDS OF FORGINGS, OR PARTICULARS OF TESTS APPLIED TO CASTINGS.

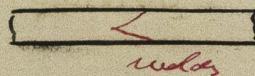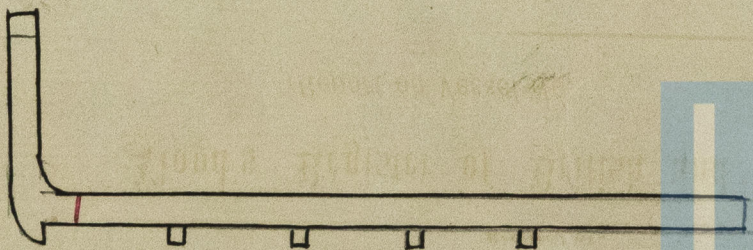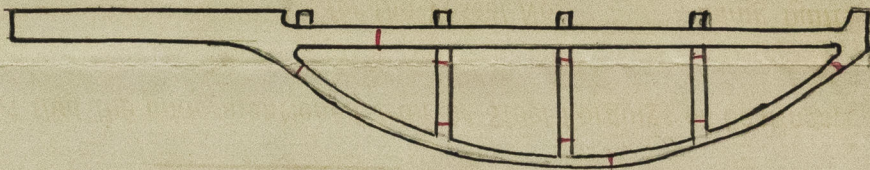

© 2019

Lloyd's Register  
Foundation