

Lloyd's Register of British and Foreign Shipping.

(Report on Vessel No. 11041 Port Greenock)

No. 4189 SHIP FORGINGS OR CASTINGS.

I have to report that the undermentioned Iron or Steel Forgings or Castings,

of the Portland Forge Coy
Kilmarnock for the Vessel No. 344, being built
by Mess Russell & Coy of Port Glasgow
have been inspected by me as set forth below, and found to be, so far as can be seen,

The words FORGINGS or CASTINGS, IRON or STEEL, should be struck out as made required.

Mark on Forgings.

Lloyd's


No. 4189
W. H.

William Hamilton

Glasgow
12/4/94

	STERN FRAME.	RUDDER FRAME.	STEM.
Material*		<i>Scrap iron</i>	<i>Scrap iron</i>
How made		<i>Forged</i>	<i>Forged</i>
Dimensions		<i>9 1/2 to 4 3/4 dia</i>	<i>11 x 3</i>
Progress on Inspection		<i>Forging & smithing</i>	<i>Forging & smithing</i>
Date when Inspected		<i>21/12/93. 2. 15 29/1/94. 6 10. 4. 16 21. 30/1/93</i> <i>23. 27/2/94. 9. 14. 21</i> <i>28/3/94. 3. 6. 7/4/94</i>	<i>1. 6. 8. 14. 18. 2/12/93</i>

SKETCHES OF FRAMES SHOWING POSITION AND DESCRIPTION OF WELDS OF FORGINGS, OR PARTICULARS OF TESTS APPLIED TO CASTINGS.

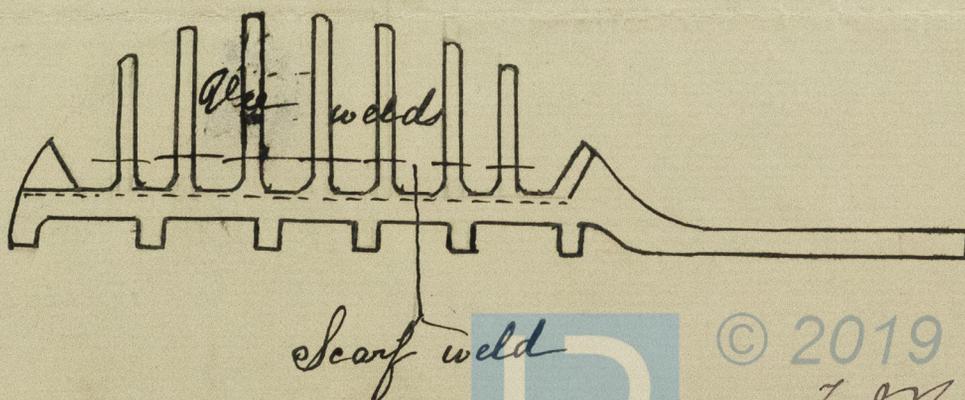

© 2019
J. J. M.
 Lloyd's Register
 Foundation