

15. 10. 44


Steel W 305.

306

Scale  $\frac{1}{2}$  Inch = One Foot.

appd.

17.10.93.

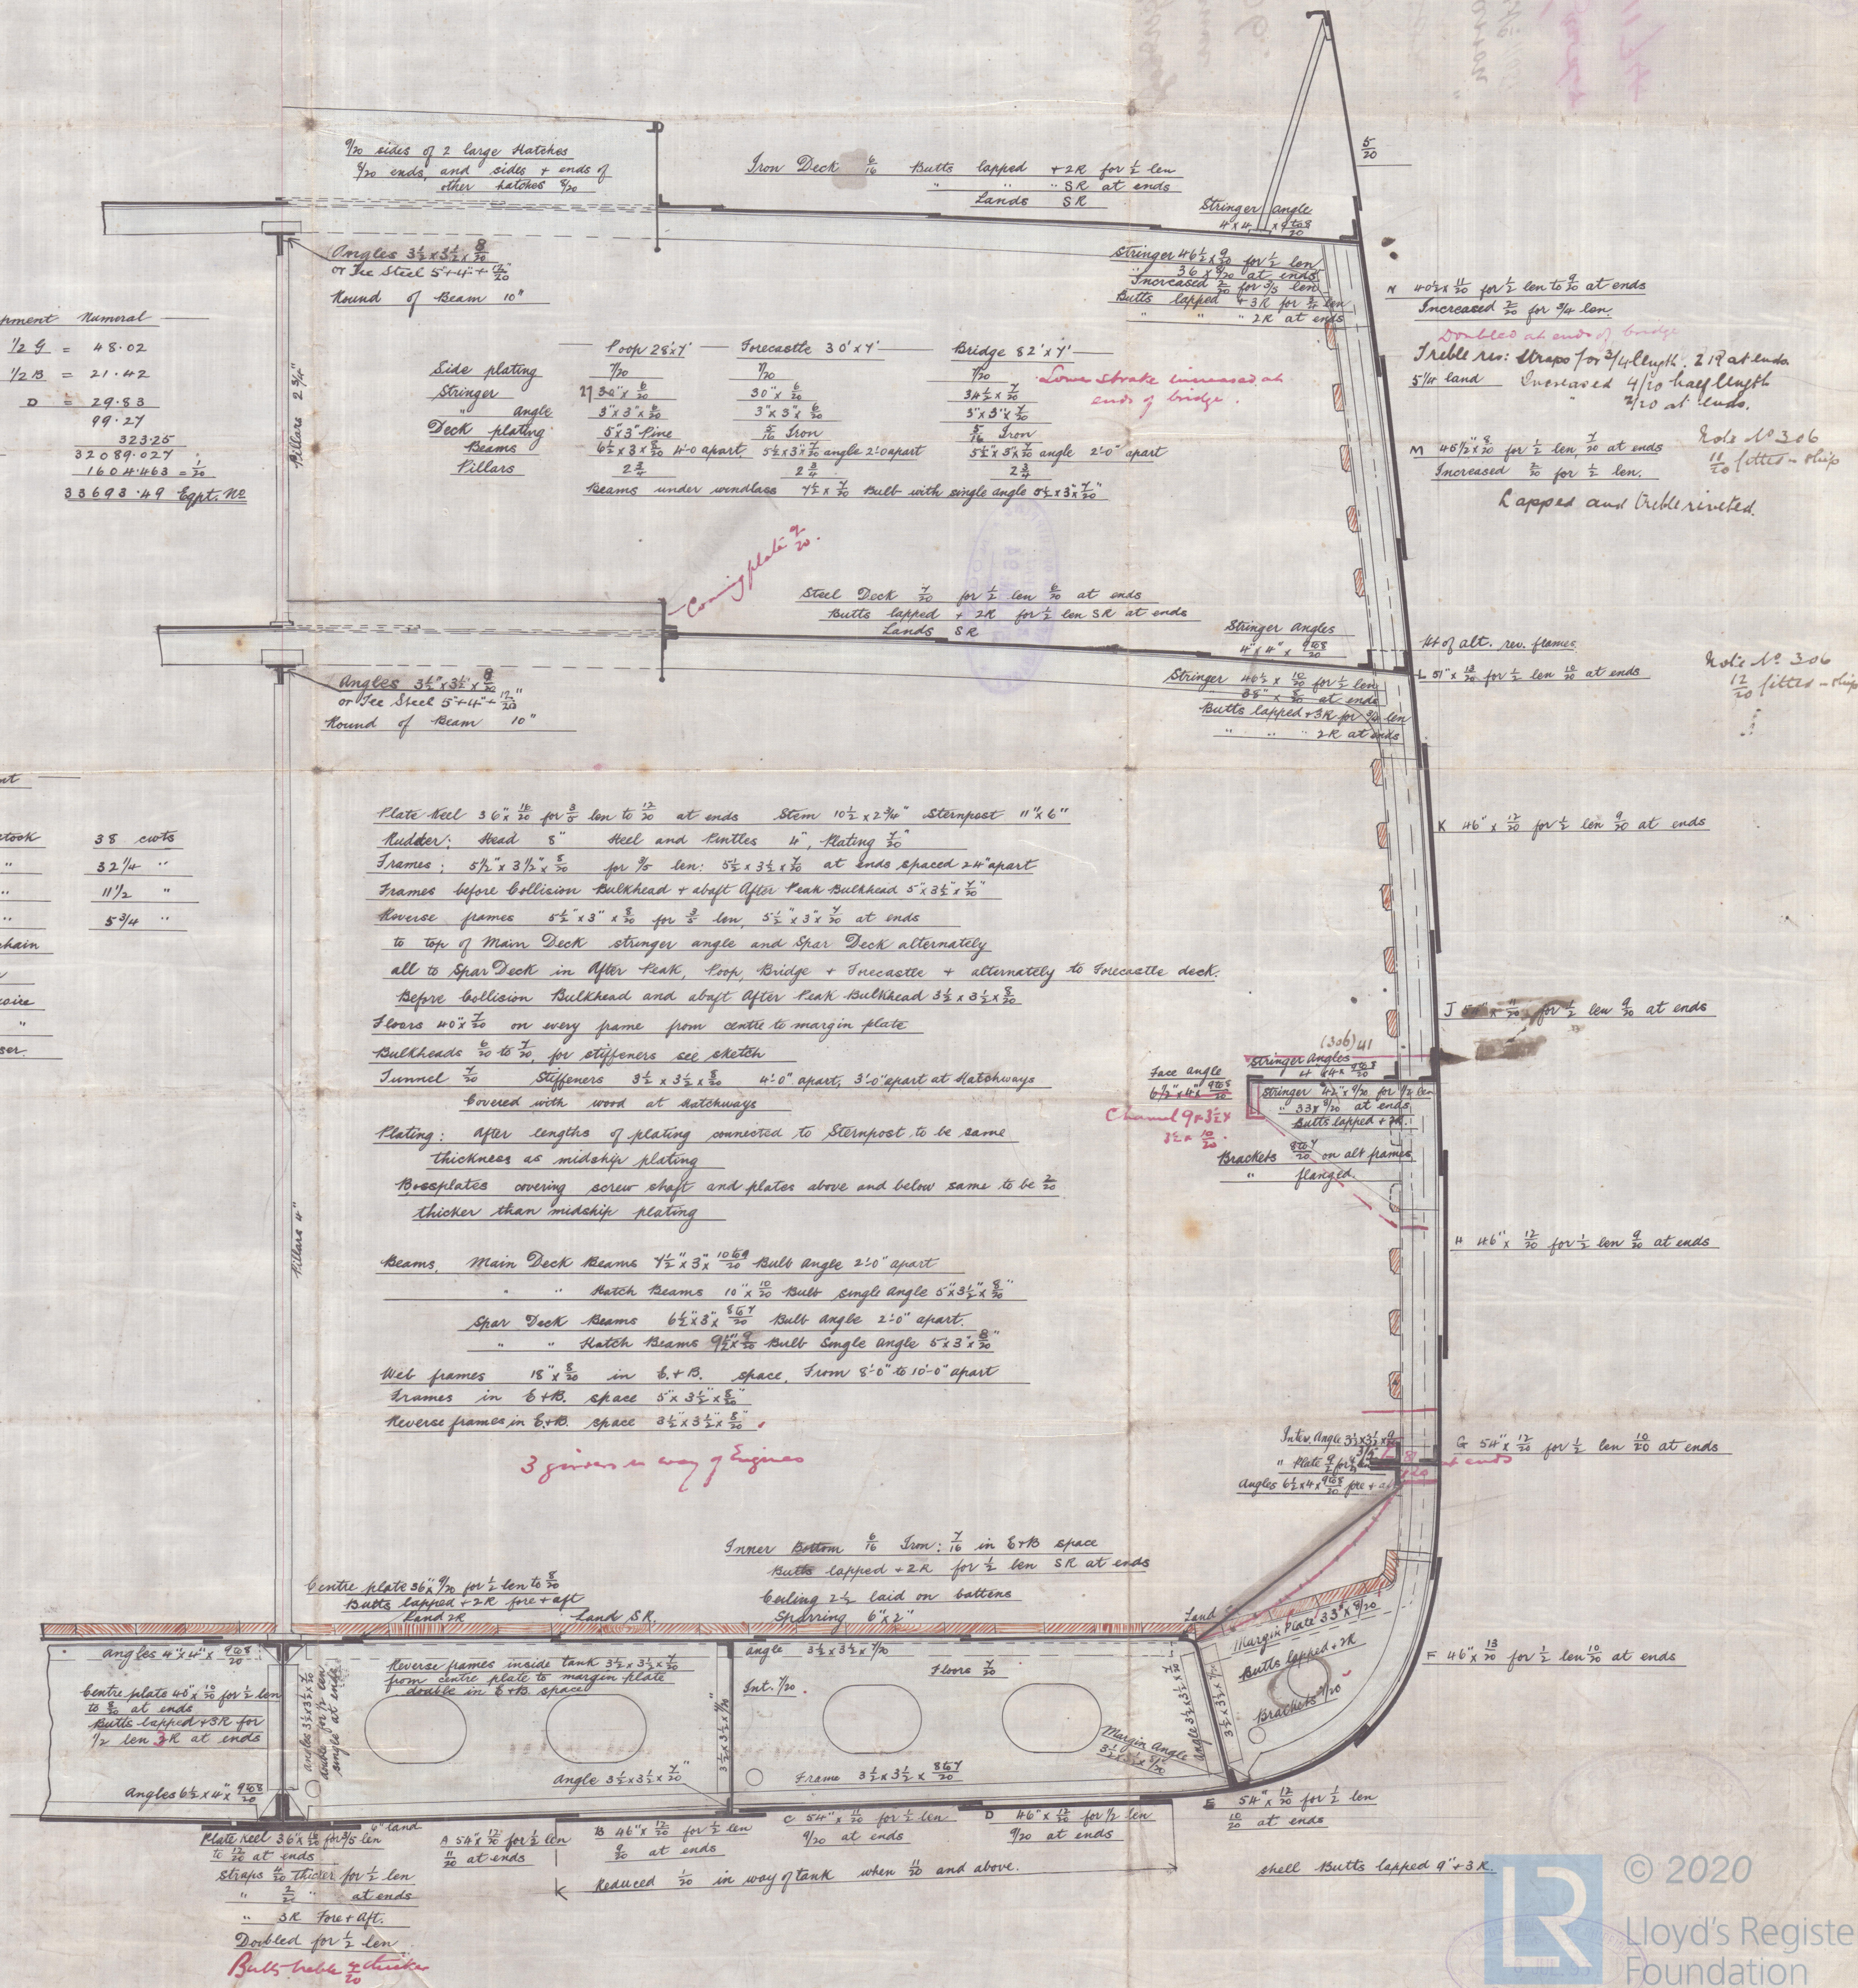

GRH328-0409



Thos A. Rodgers Esq  
Proposed steamer

305 & 306.


Midship  
Section

305 "Strathcarron"

Report No. 11051

Burn Larder  
G.R. Rpt. 11174

GRH322-0109

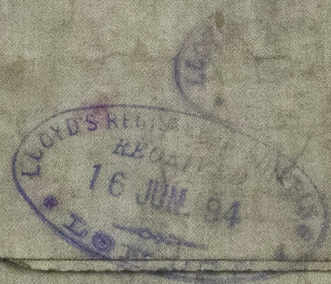

© 2020

Lloyd's Register  
Foundation