


— Sketch showing beams in Engine Room Space —


— S.S. No 305 + 6 —

— Scale $\frac{1}{2}$ Inch = One Foot. —


12. 3. 94

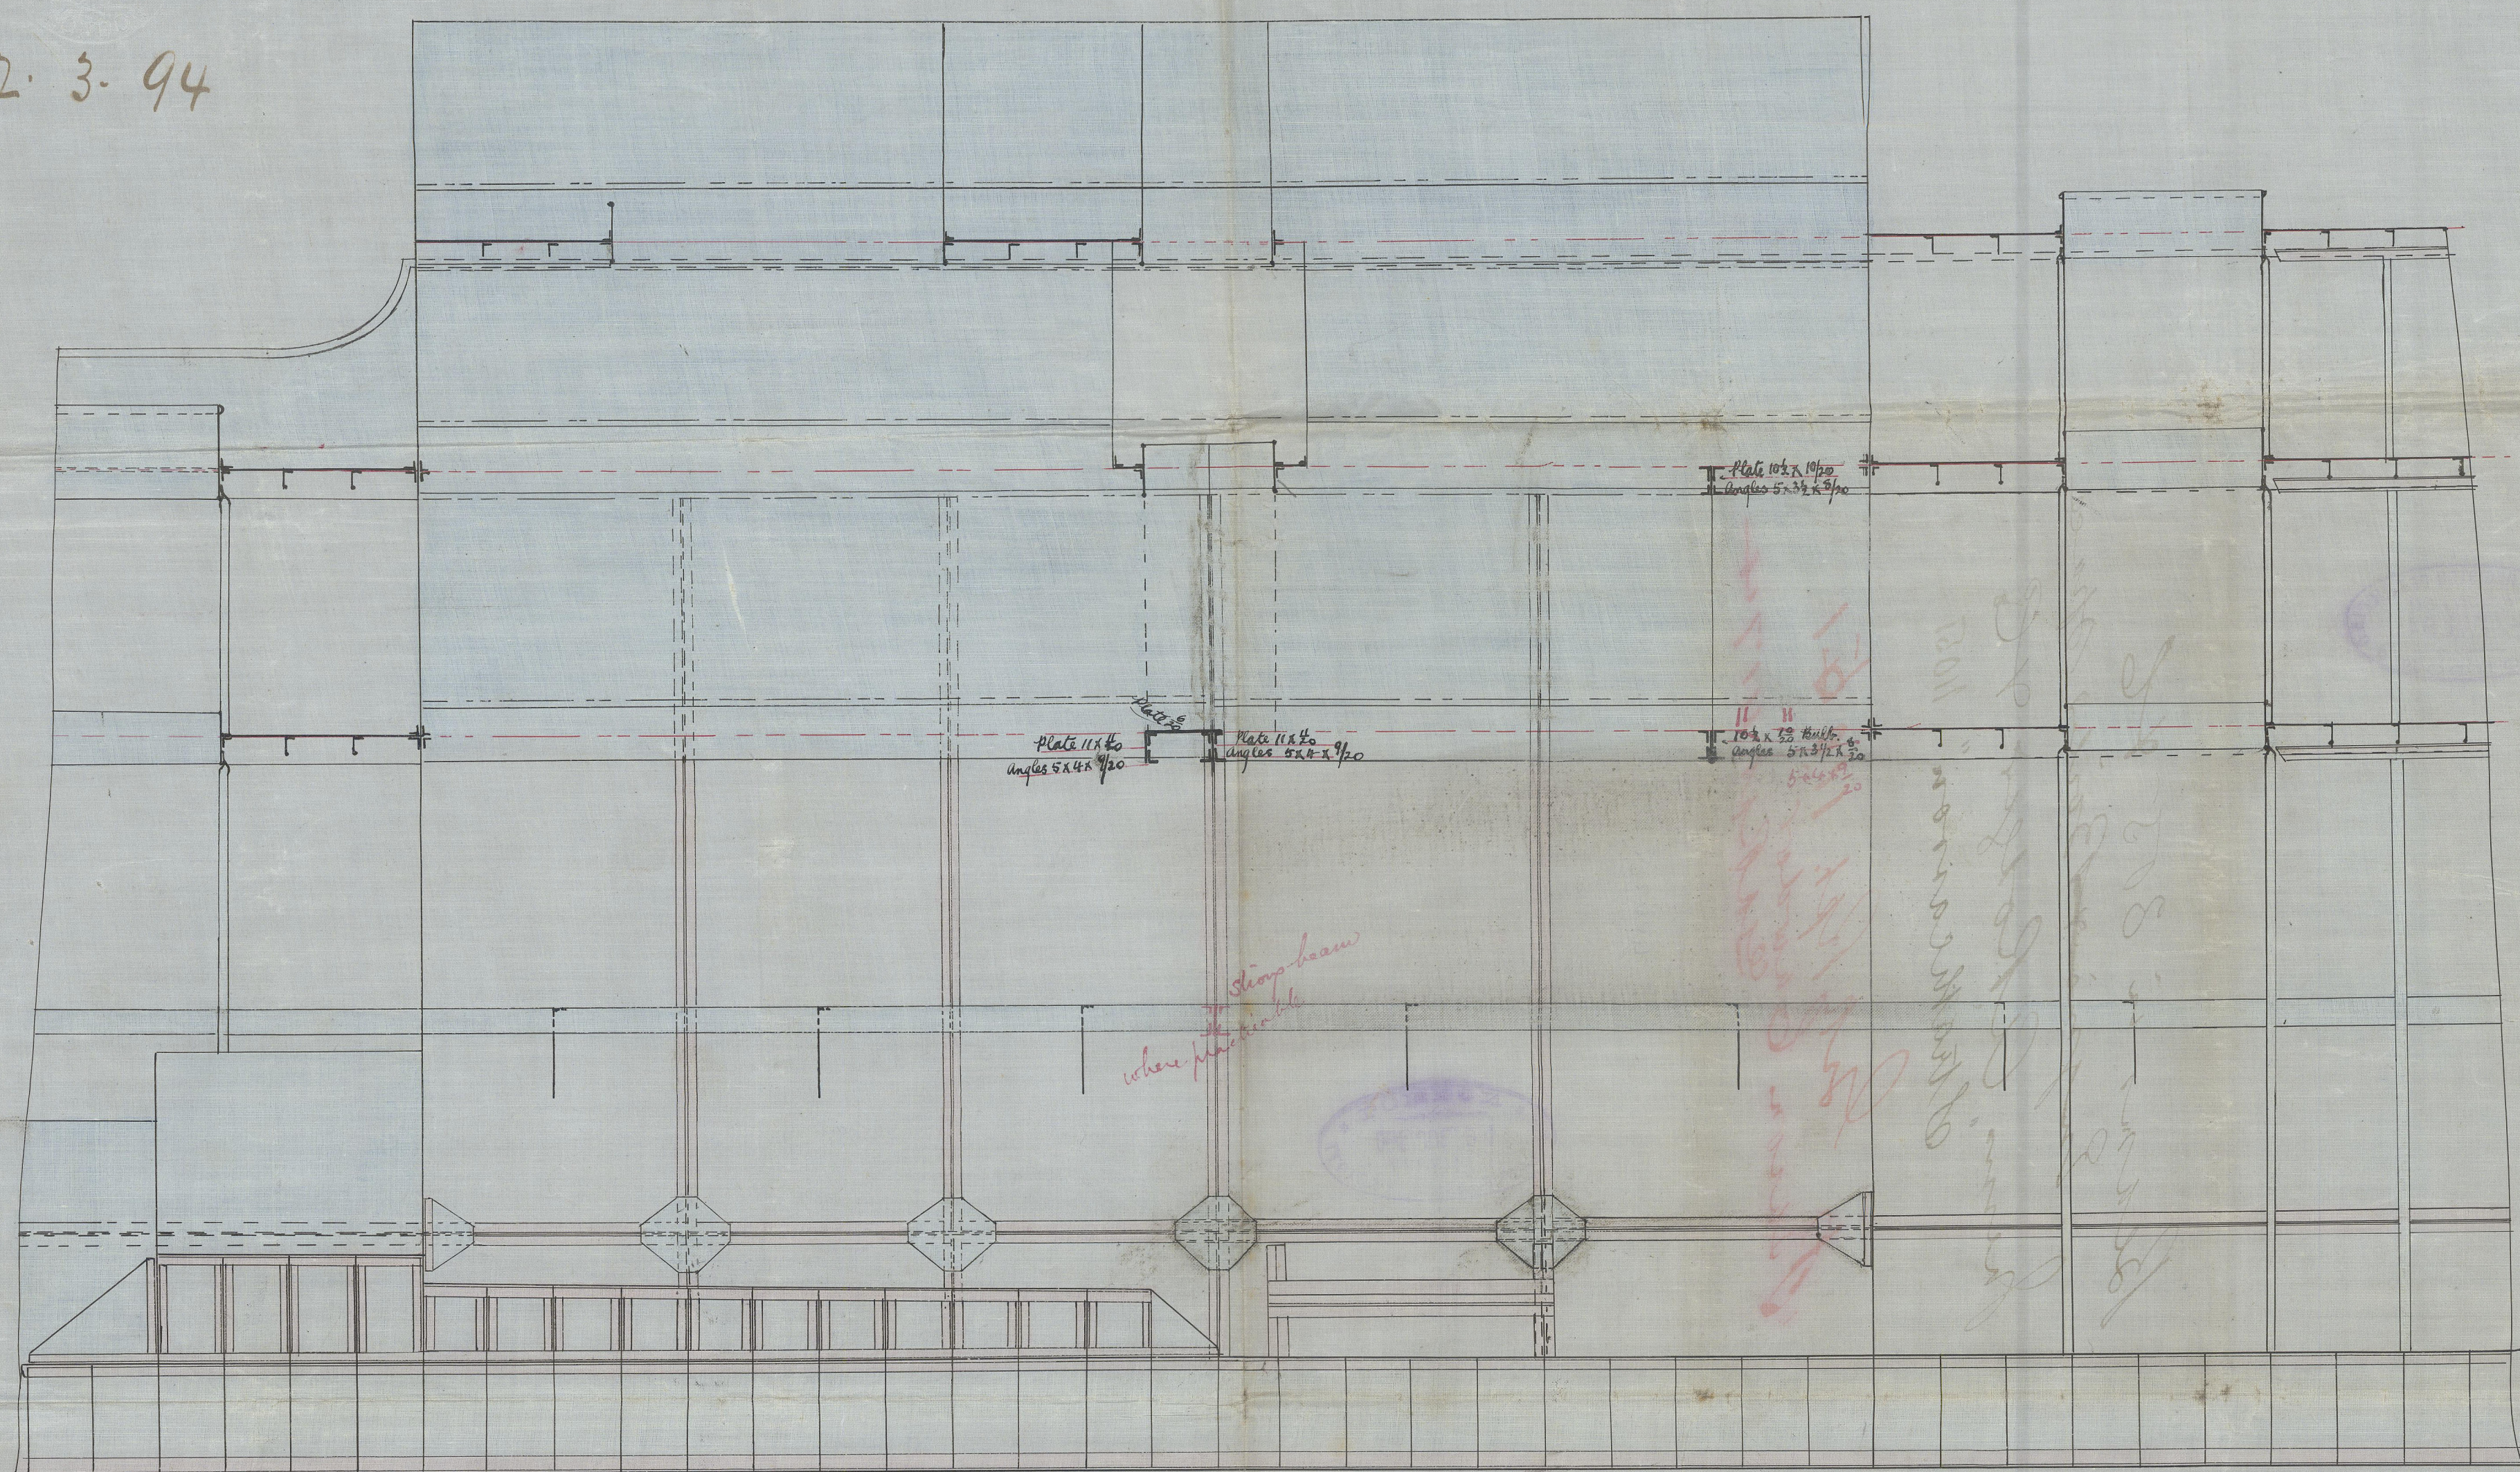

Elevation

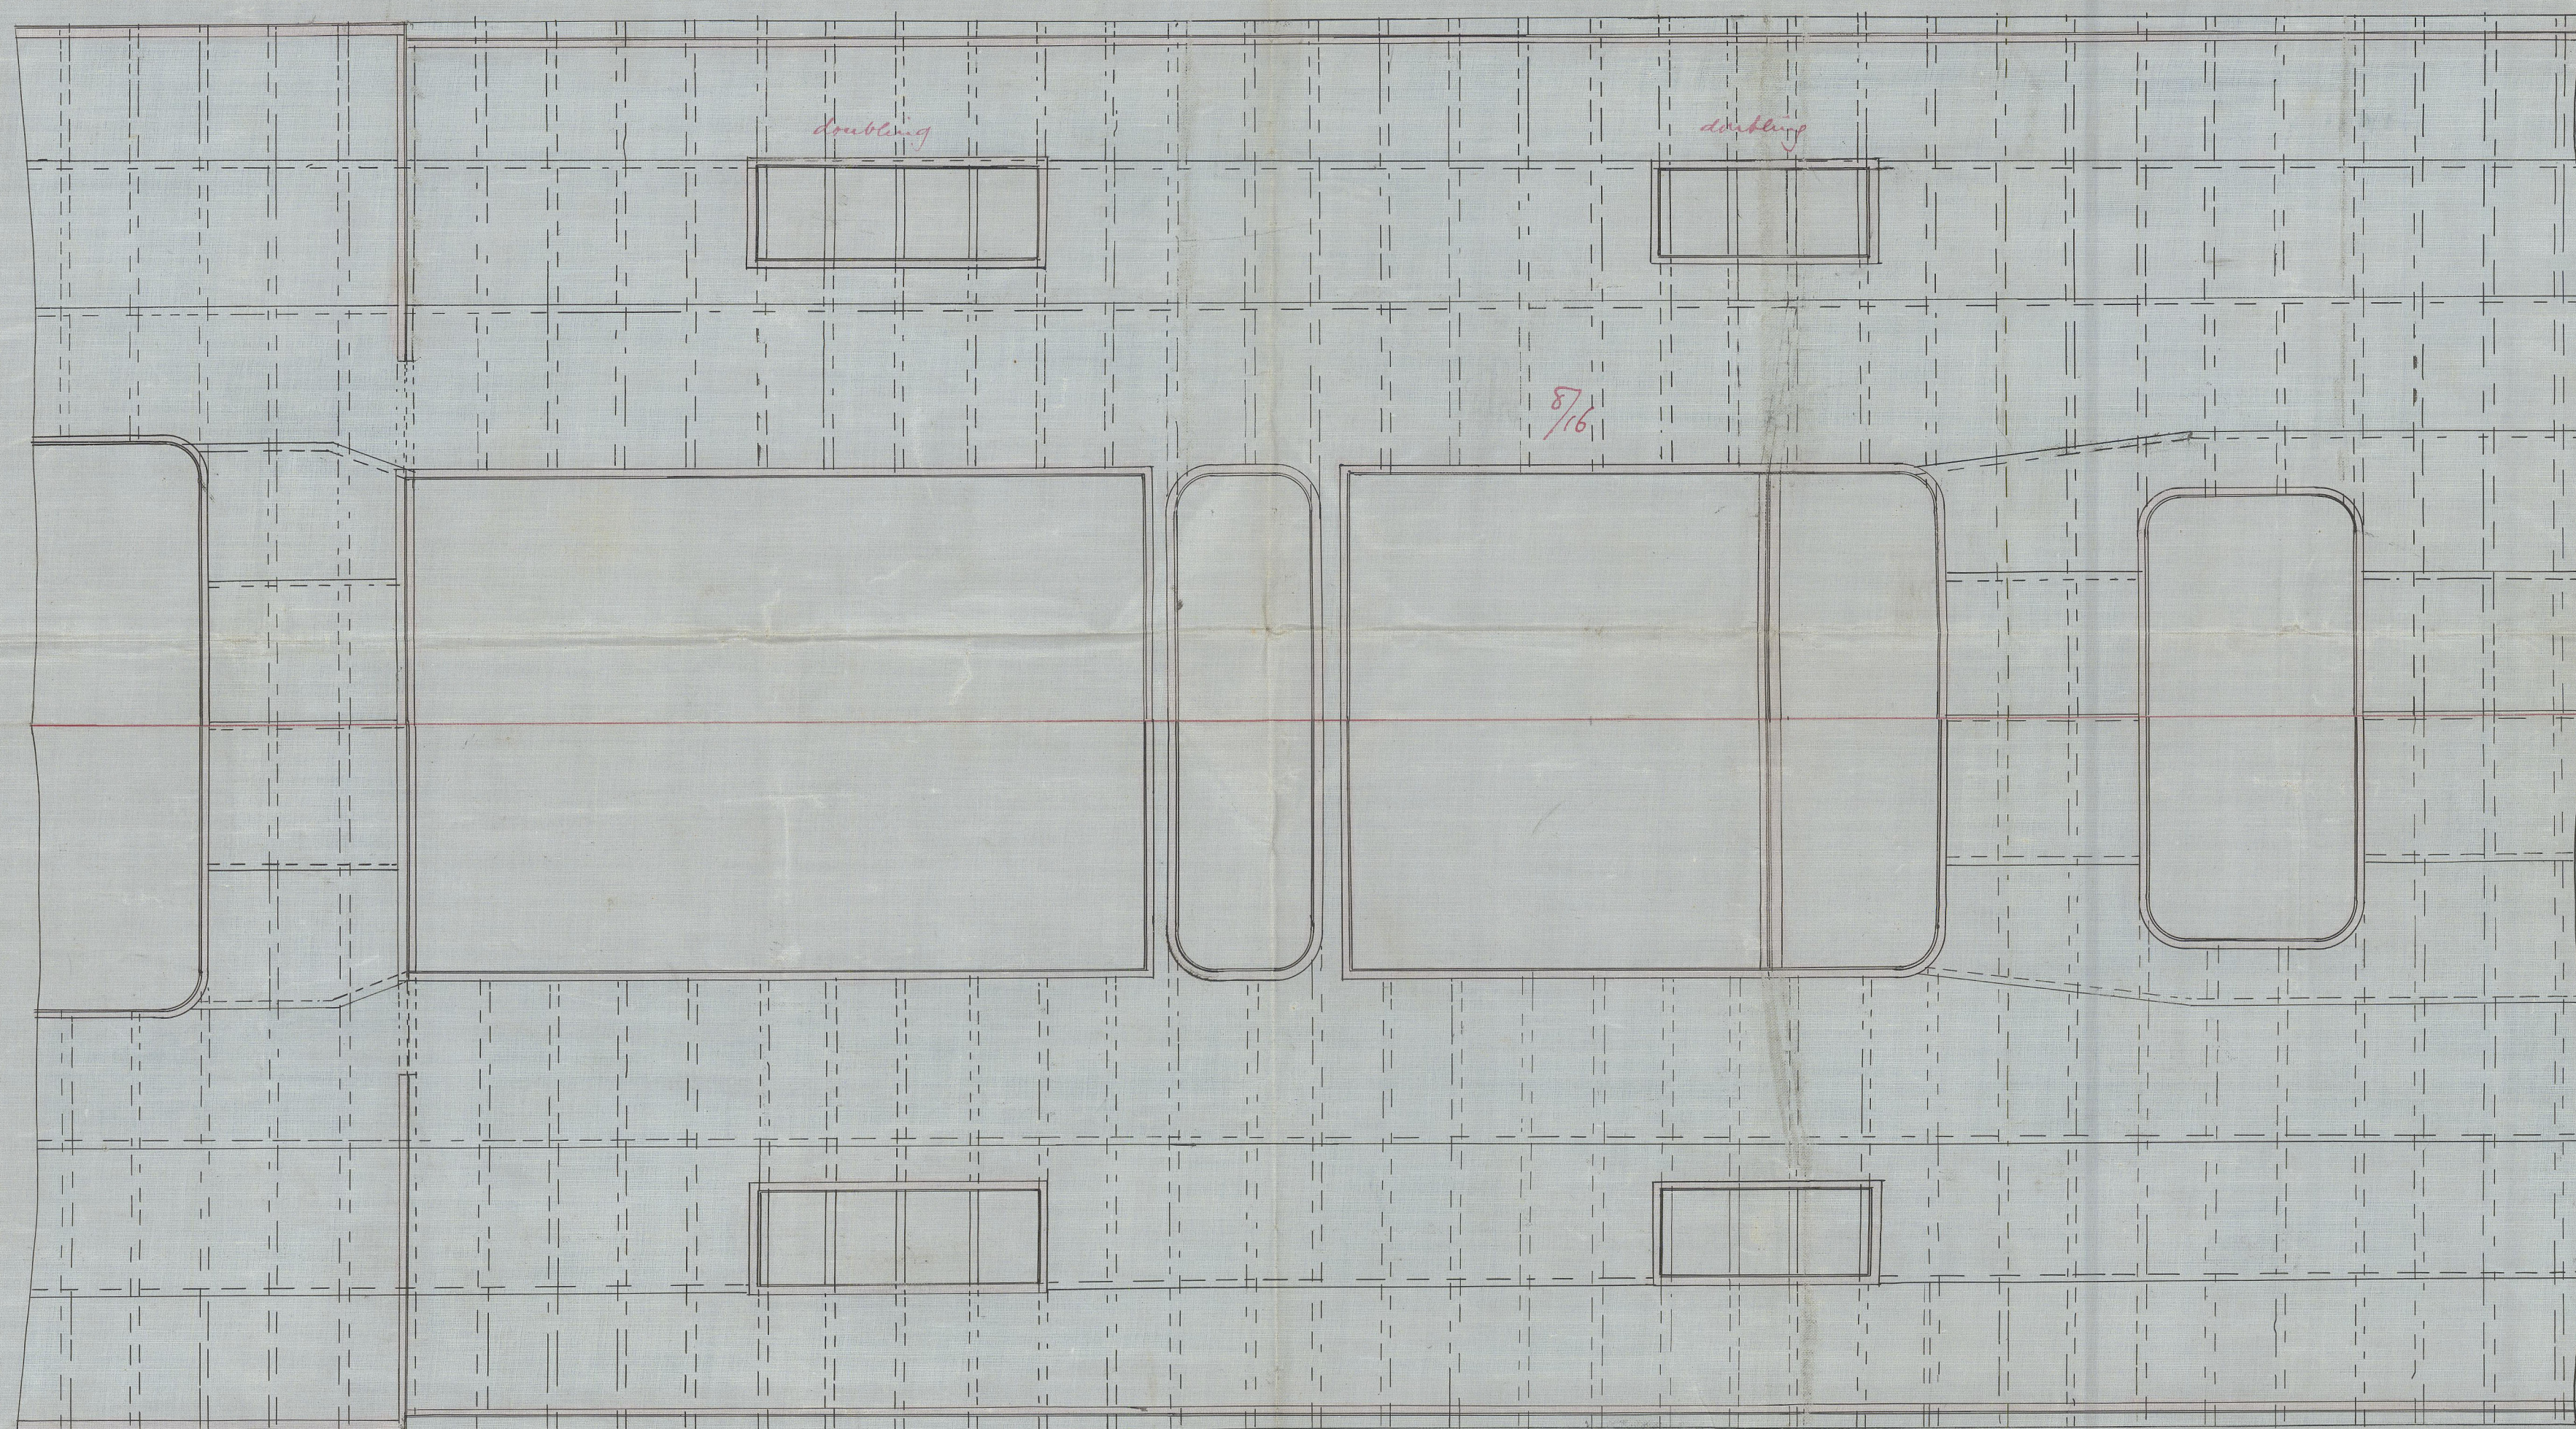

Spar Deck

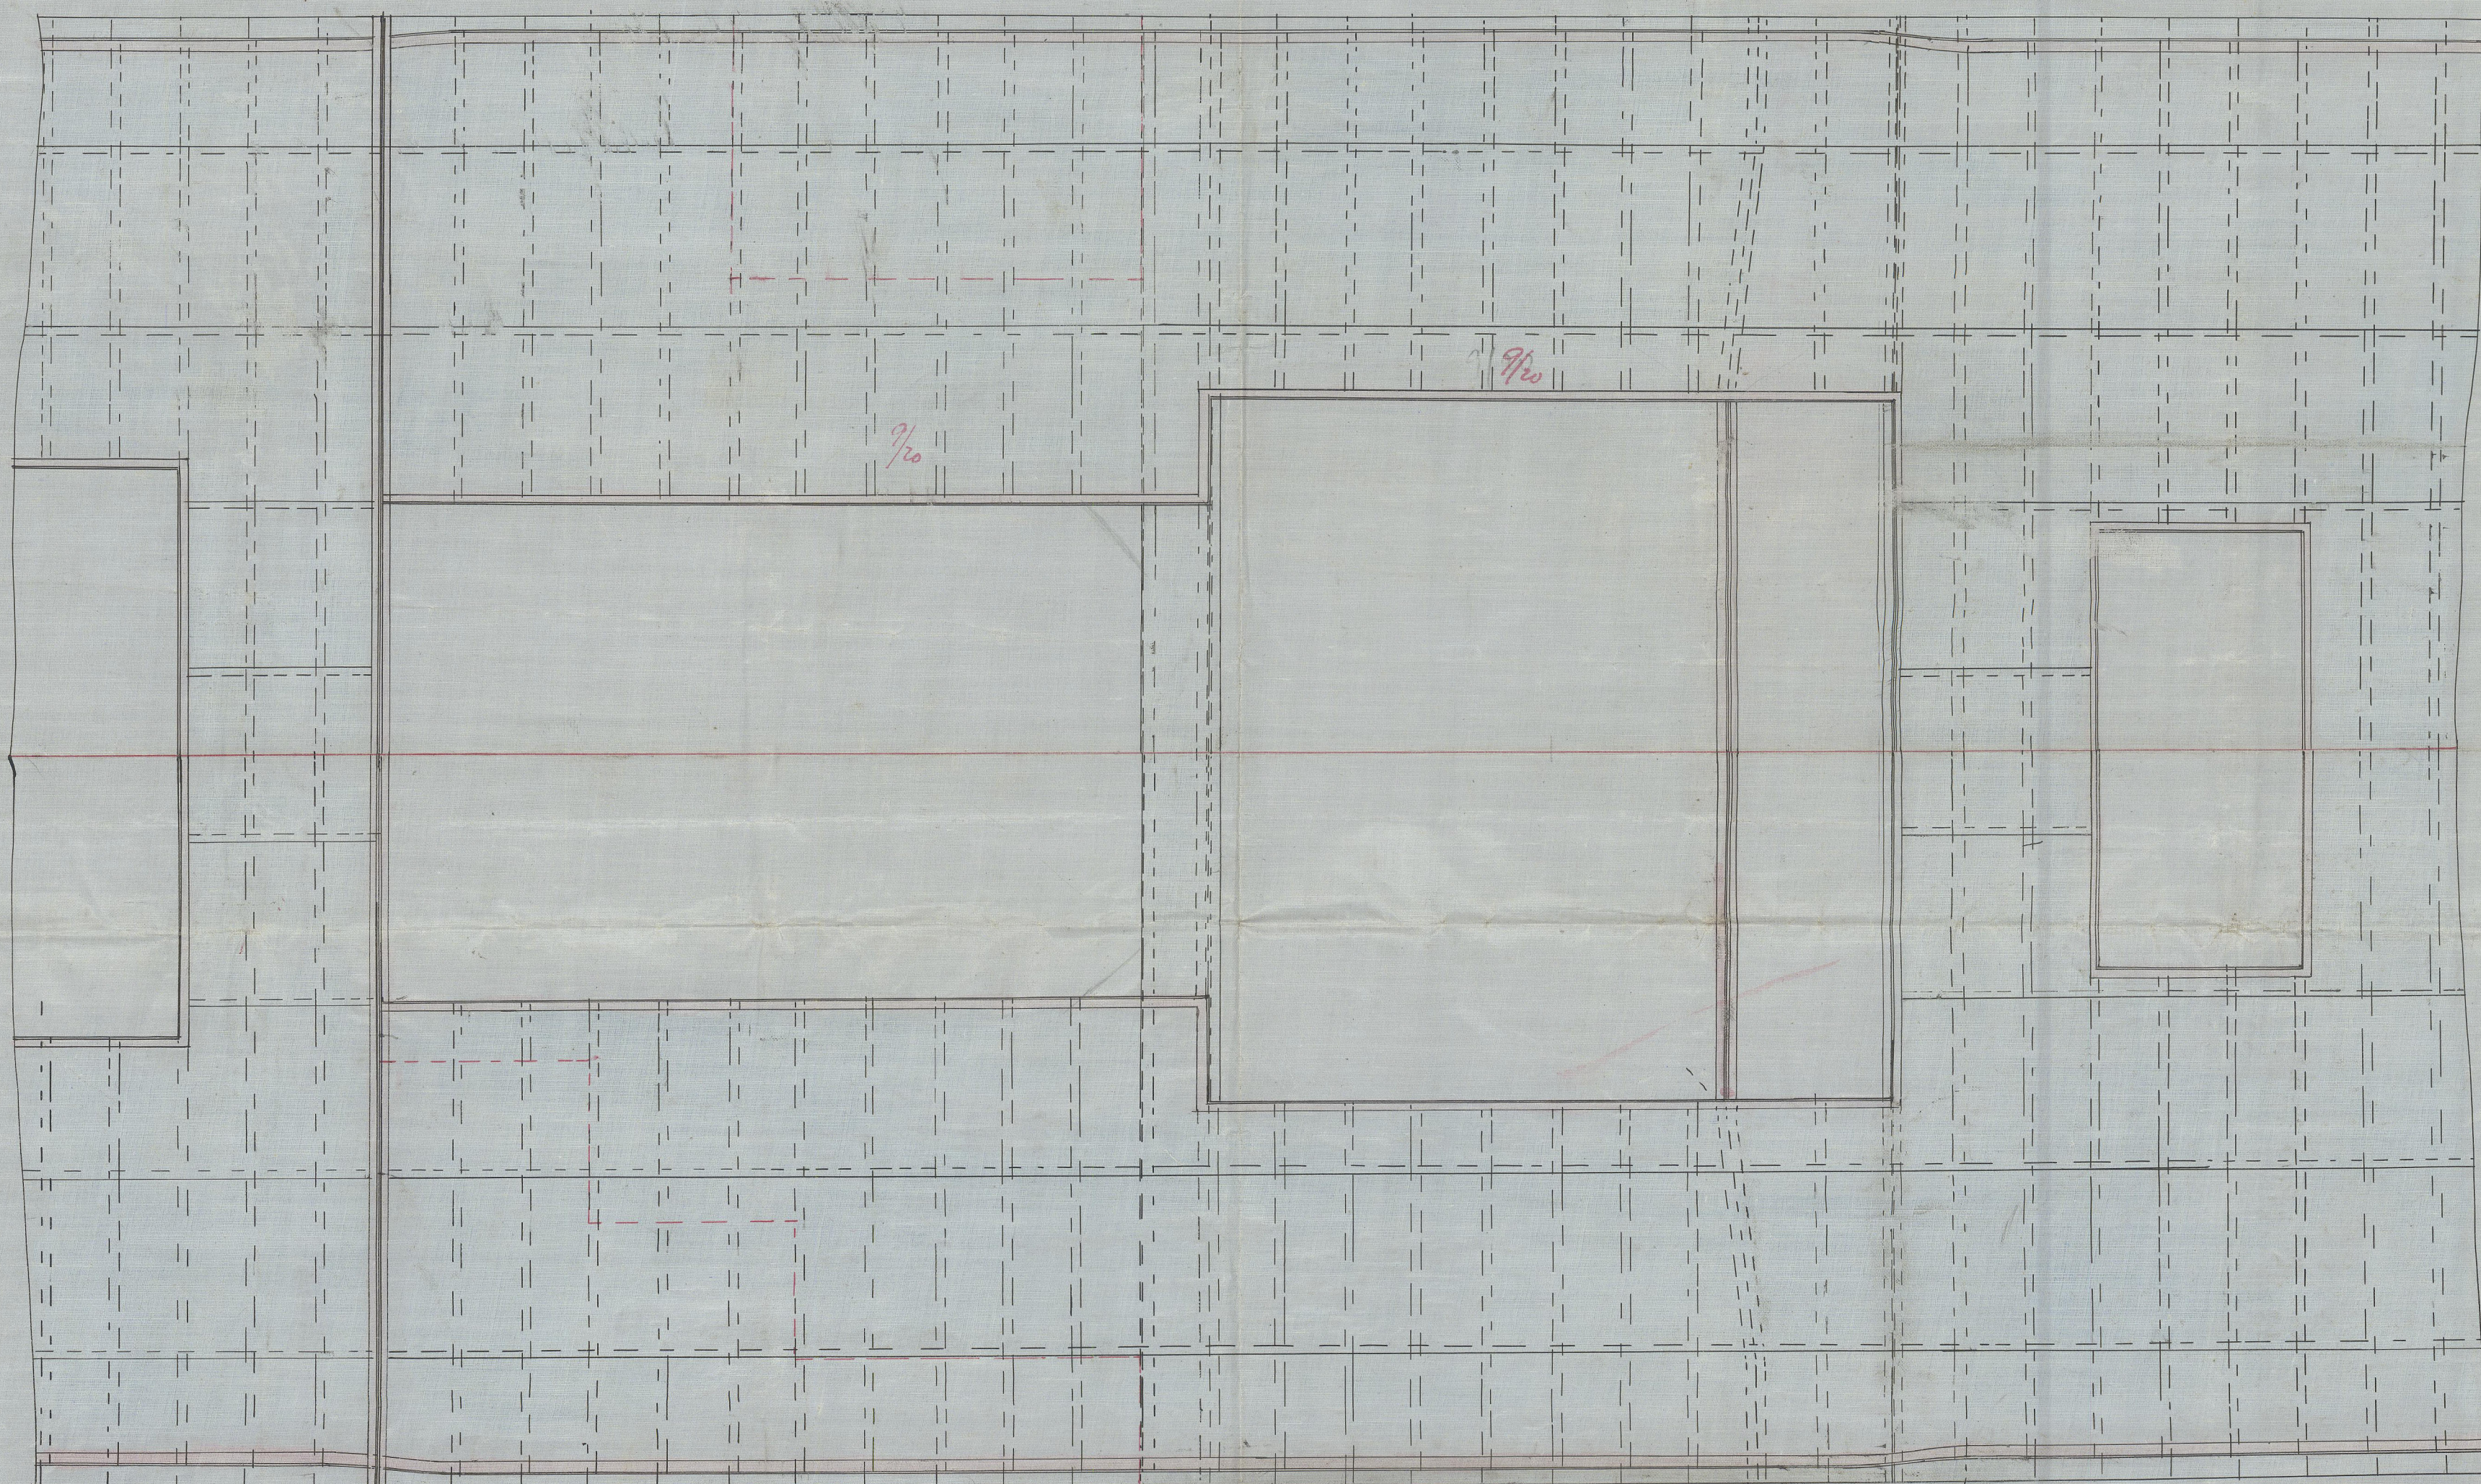

Main Deck.


Grawock
6/3/94



Beams in 305 & C
Engine & Boiler space
Jas. A. Rodger & Co
"Strathcarron" 11057

Grp Rpt. 11051
"Baron Cawdor"
Grp Rpt 11174

GRH328-0116

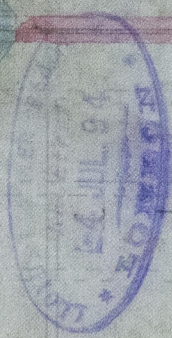

© 2020
Lloyd's Register
Foundation