

1. 3. 94.


Clude

Midship Section No 365.

Scale $\frac{1}{2}'' = 1'-0''$

Reg. Dimensions $270 \times 39 \times 22.6$

Proportions.
Depth to length $10.1:1$
Breadth to $1:1$ $6.6:5$

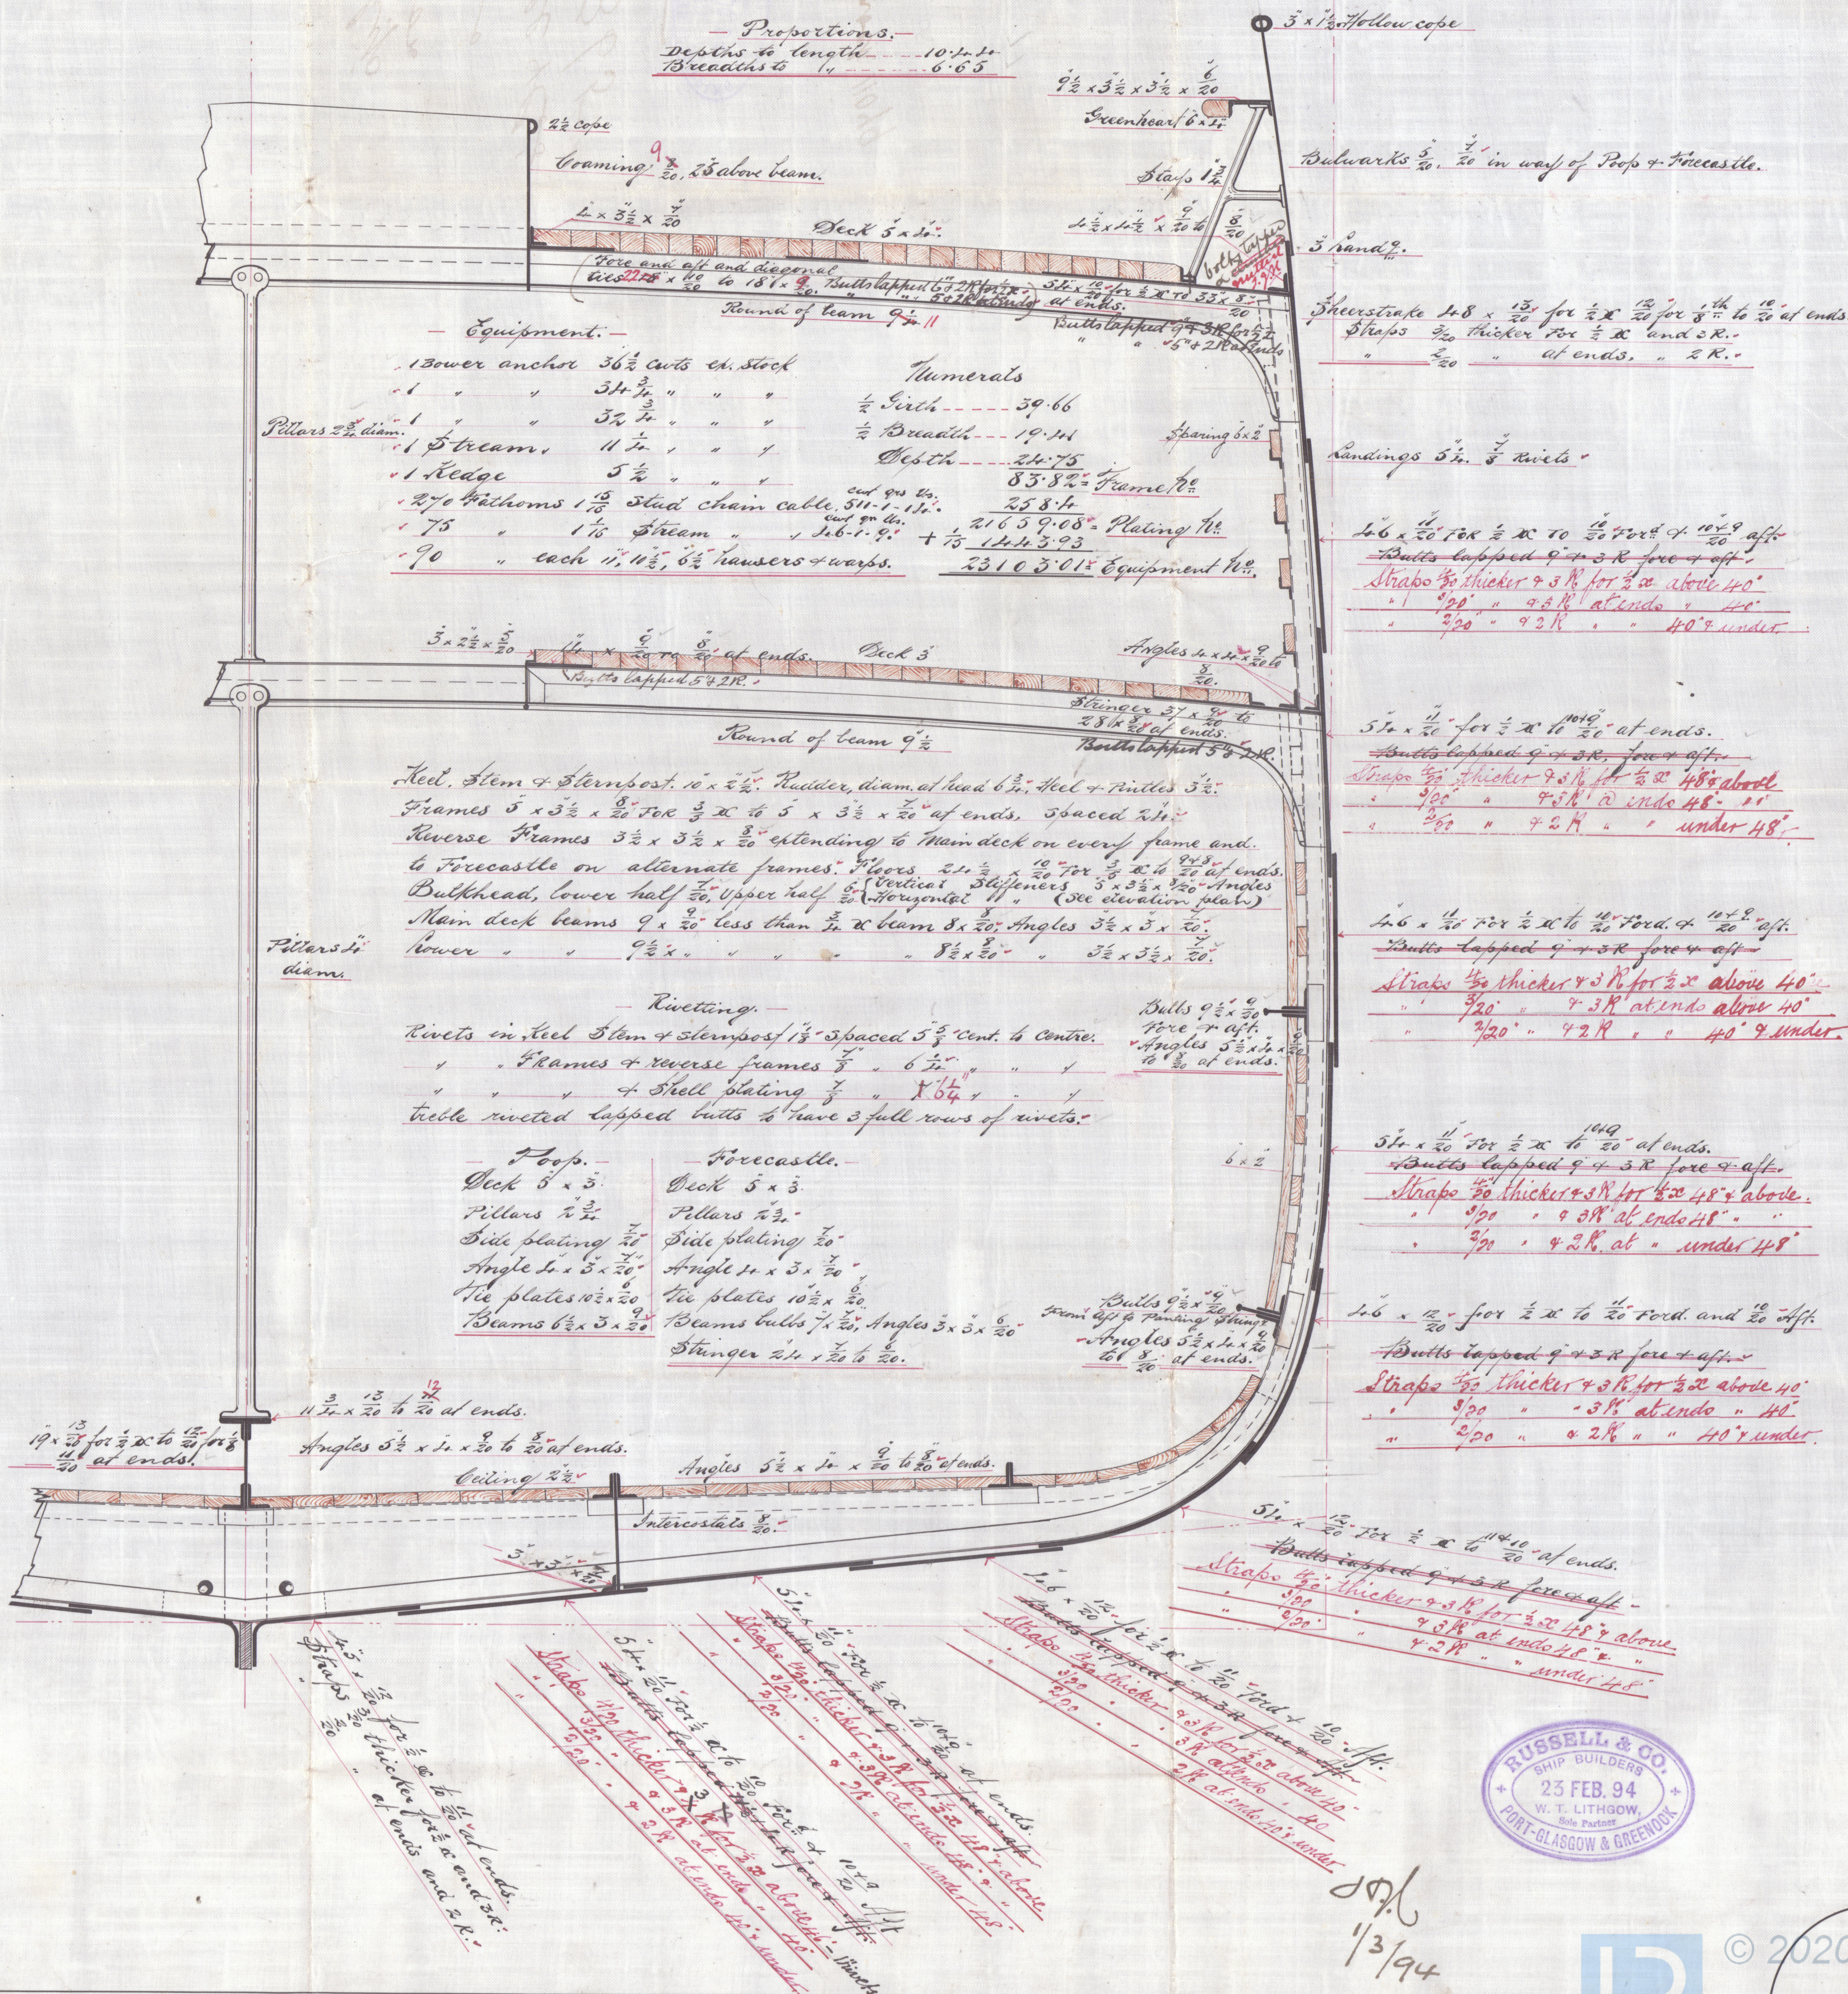


Midships
Section
Messrs
Russell & Co's
No 365



Bk. Clyde,
Greenock 11049

6164328-0705

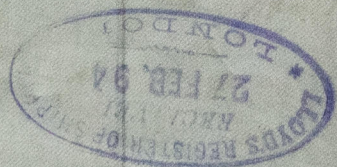

© 2020

Lloyd's Register
Foundation