

Lloyd's Register of British and Foreign Shipping.

(Report on Vessel No. *11079* Port *Greenock*)No. *4482* SHIP FORGINGS ~~OR CASTINGS~~.

I have to report that the undermentioned Iron ~~or Steel~~ Forgings ~~or Castings~~,
 manufactured by *The Irvine Forge Coy*
 of *Irvine* for the Vessel No. *365*, being built
 by *Messrs Russell & Coy* of *Port Glasgow*
 have been inspected by me as set forth below, and found to be, so far as can be seen,
Sound & efficient

Mark on Forgings.


Lloyd's
 No. *4482*
 W.H.

William Hamilton
Glasgow
7/6/94

	STERN FRAME.	RUDDER FRAME.	STEM.
Material* ...	<div data-bbox="400 1266 754 1607" style="position: relative; height: 140px;"> <div style="position: absolute; top: 0; left: 0; right: 0; bottom: 0; background: linear-gradient(to top right, transparent 49%, black 49%, black 51%, transparent 51%);"></div> </div>	<div data-bbox="754 1266 1108 1607" style="position: relative; height: 140px;"> <div style="position: absolute; top: 0; left: 0; right: 0; bottom: 0; background: linear-gradient(to top right, transparent 49%, black 49%, black 51%, transparent 51%);"></div> </div>	<div data-bbox="1108 1266 1432 1607" style="position: relative; height: 140px;"> <div style="position: absolute; top: 0; left: 0; right: 0; bottom: 0; background: linear-gradient(to top right, transparent 49%, black 49%, black 51%, transparent 51%);"></div> </div>
How made ...			
Dimensions ...			
Progress on Inspection			
Date when Inspected			

Scrap iron
Forged
7 to 3 1/2
Forging & smithing
5/6/94. 27/4/94. 10/11/94.
18.21.24. 30/8/94. 1.4/6/94

SKETCHES OF FRAMES SHOWING POSITION AND DESCRIPTION OF WELDS OF FORGINGS, OR PARTICULARS OF TESTS APPLIED TO CASTINGS.

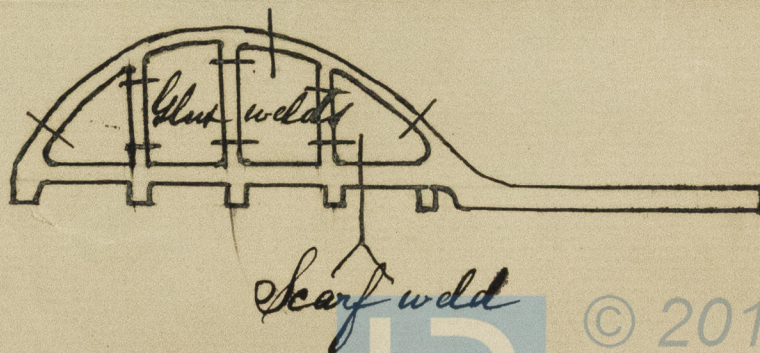

✓

© 2019

Lloyd's Register
 Foundation