



Lin 22 x $1\frac{1}{2}$ within $\frac{1}{2}$ length

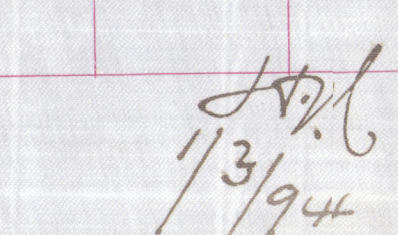

MAIN HATCH 16'-0" x 8'-0"

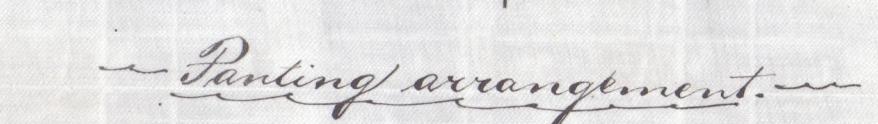

RUSSELL & CO.
SHIP BUILDERS
23 FEB. 94
W. T. LITHGOW,
Sole Partner
PORT-GLASGOW & GREENOCK

Messrs Russell &
Main Deck Plan

No 365-

BK "Clyde"
Greenock 11049

Arch 328-0202



© 2020



Lloyd's Register
Foundation