
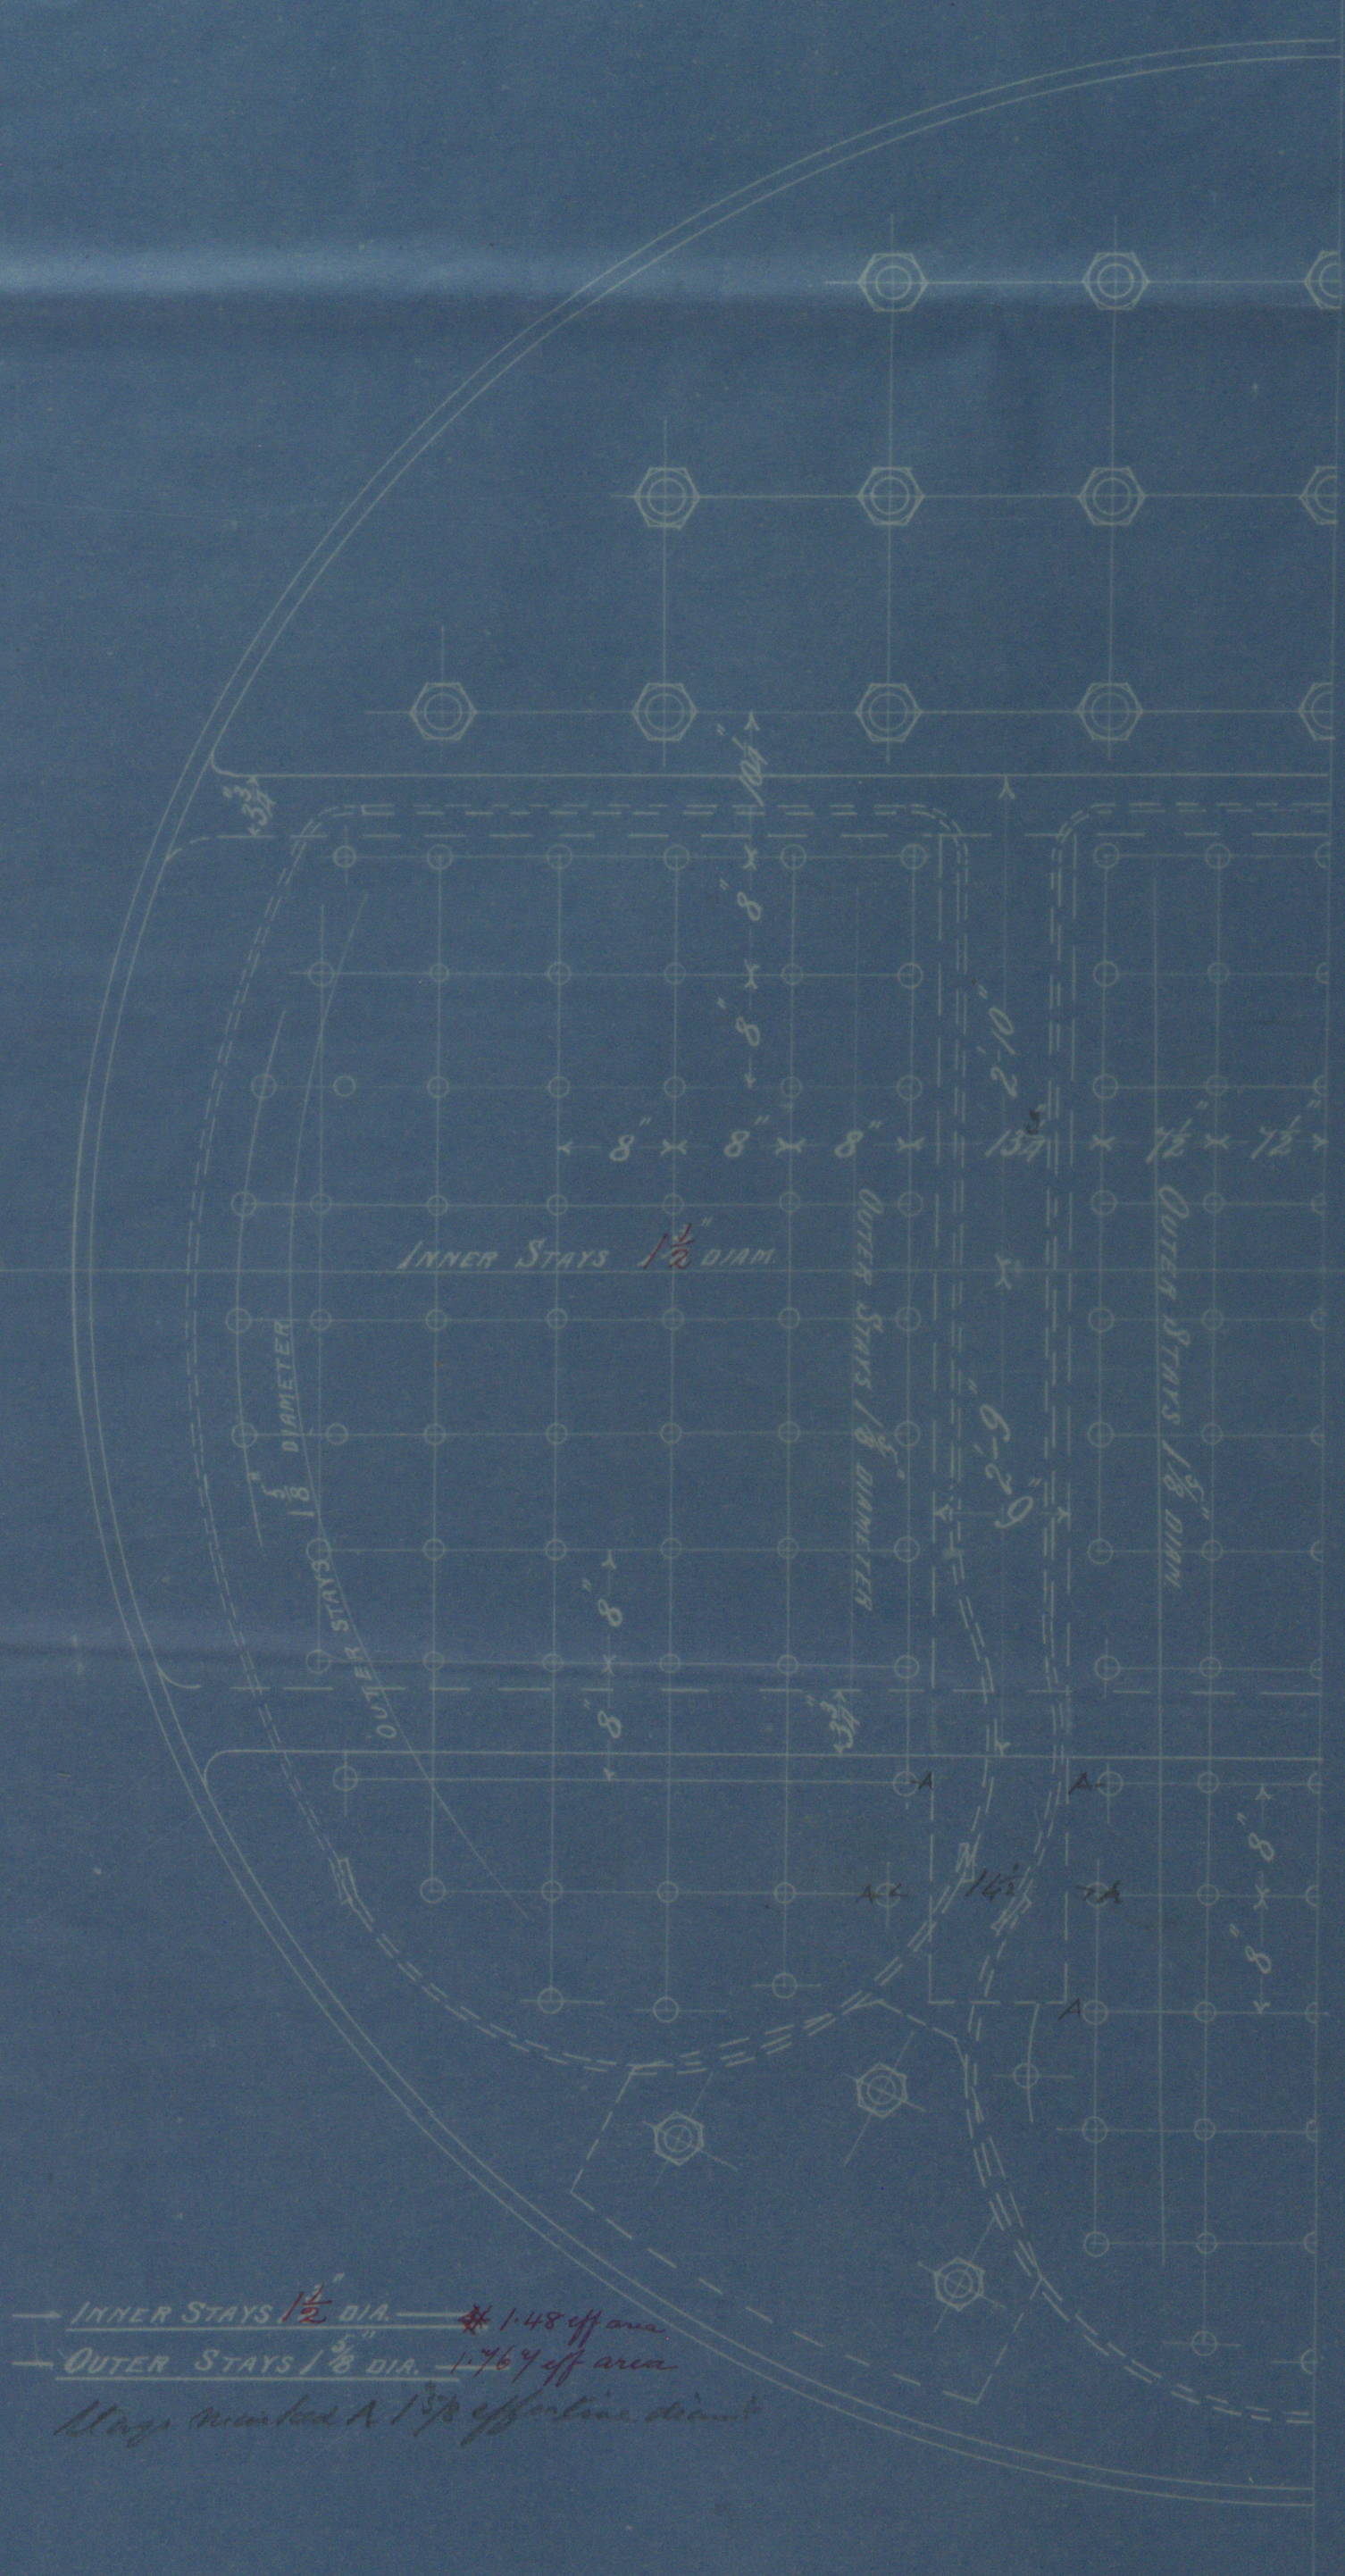
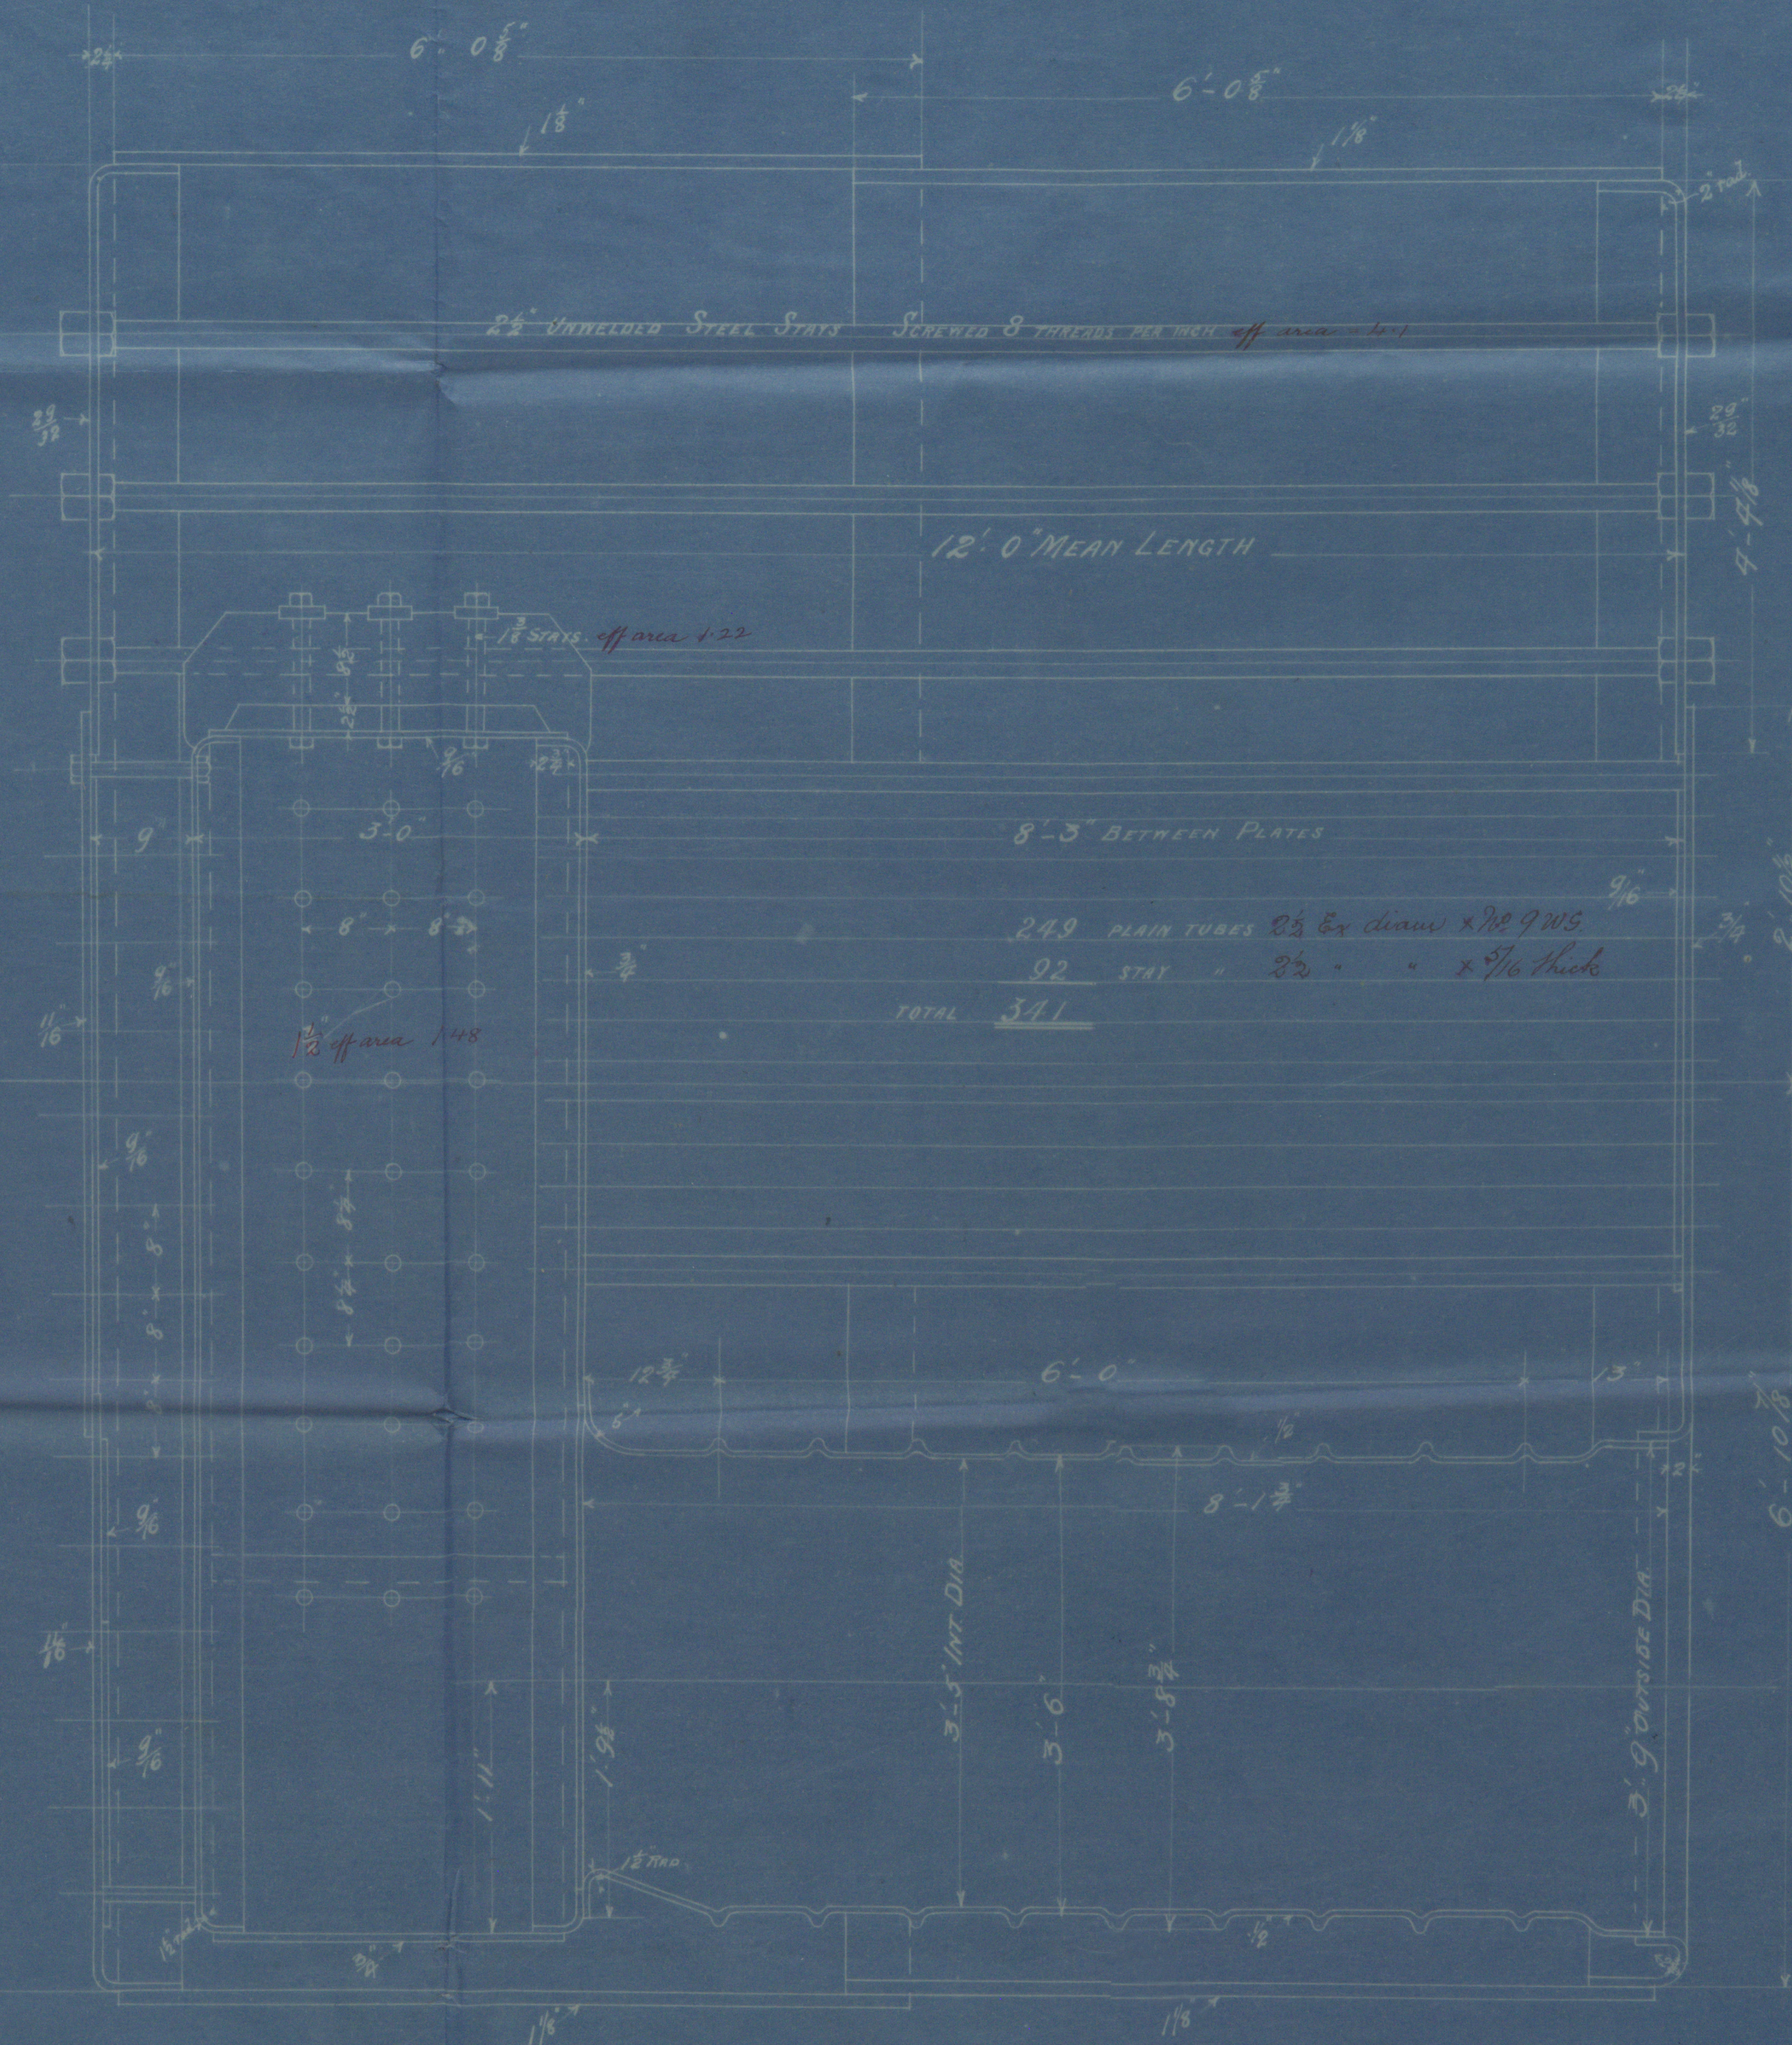


From BLACKWOOD & GORDON,
For ENCLOSURE to
Lloyds

Apr. 21

air


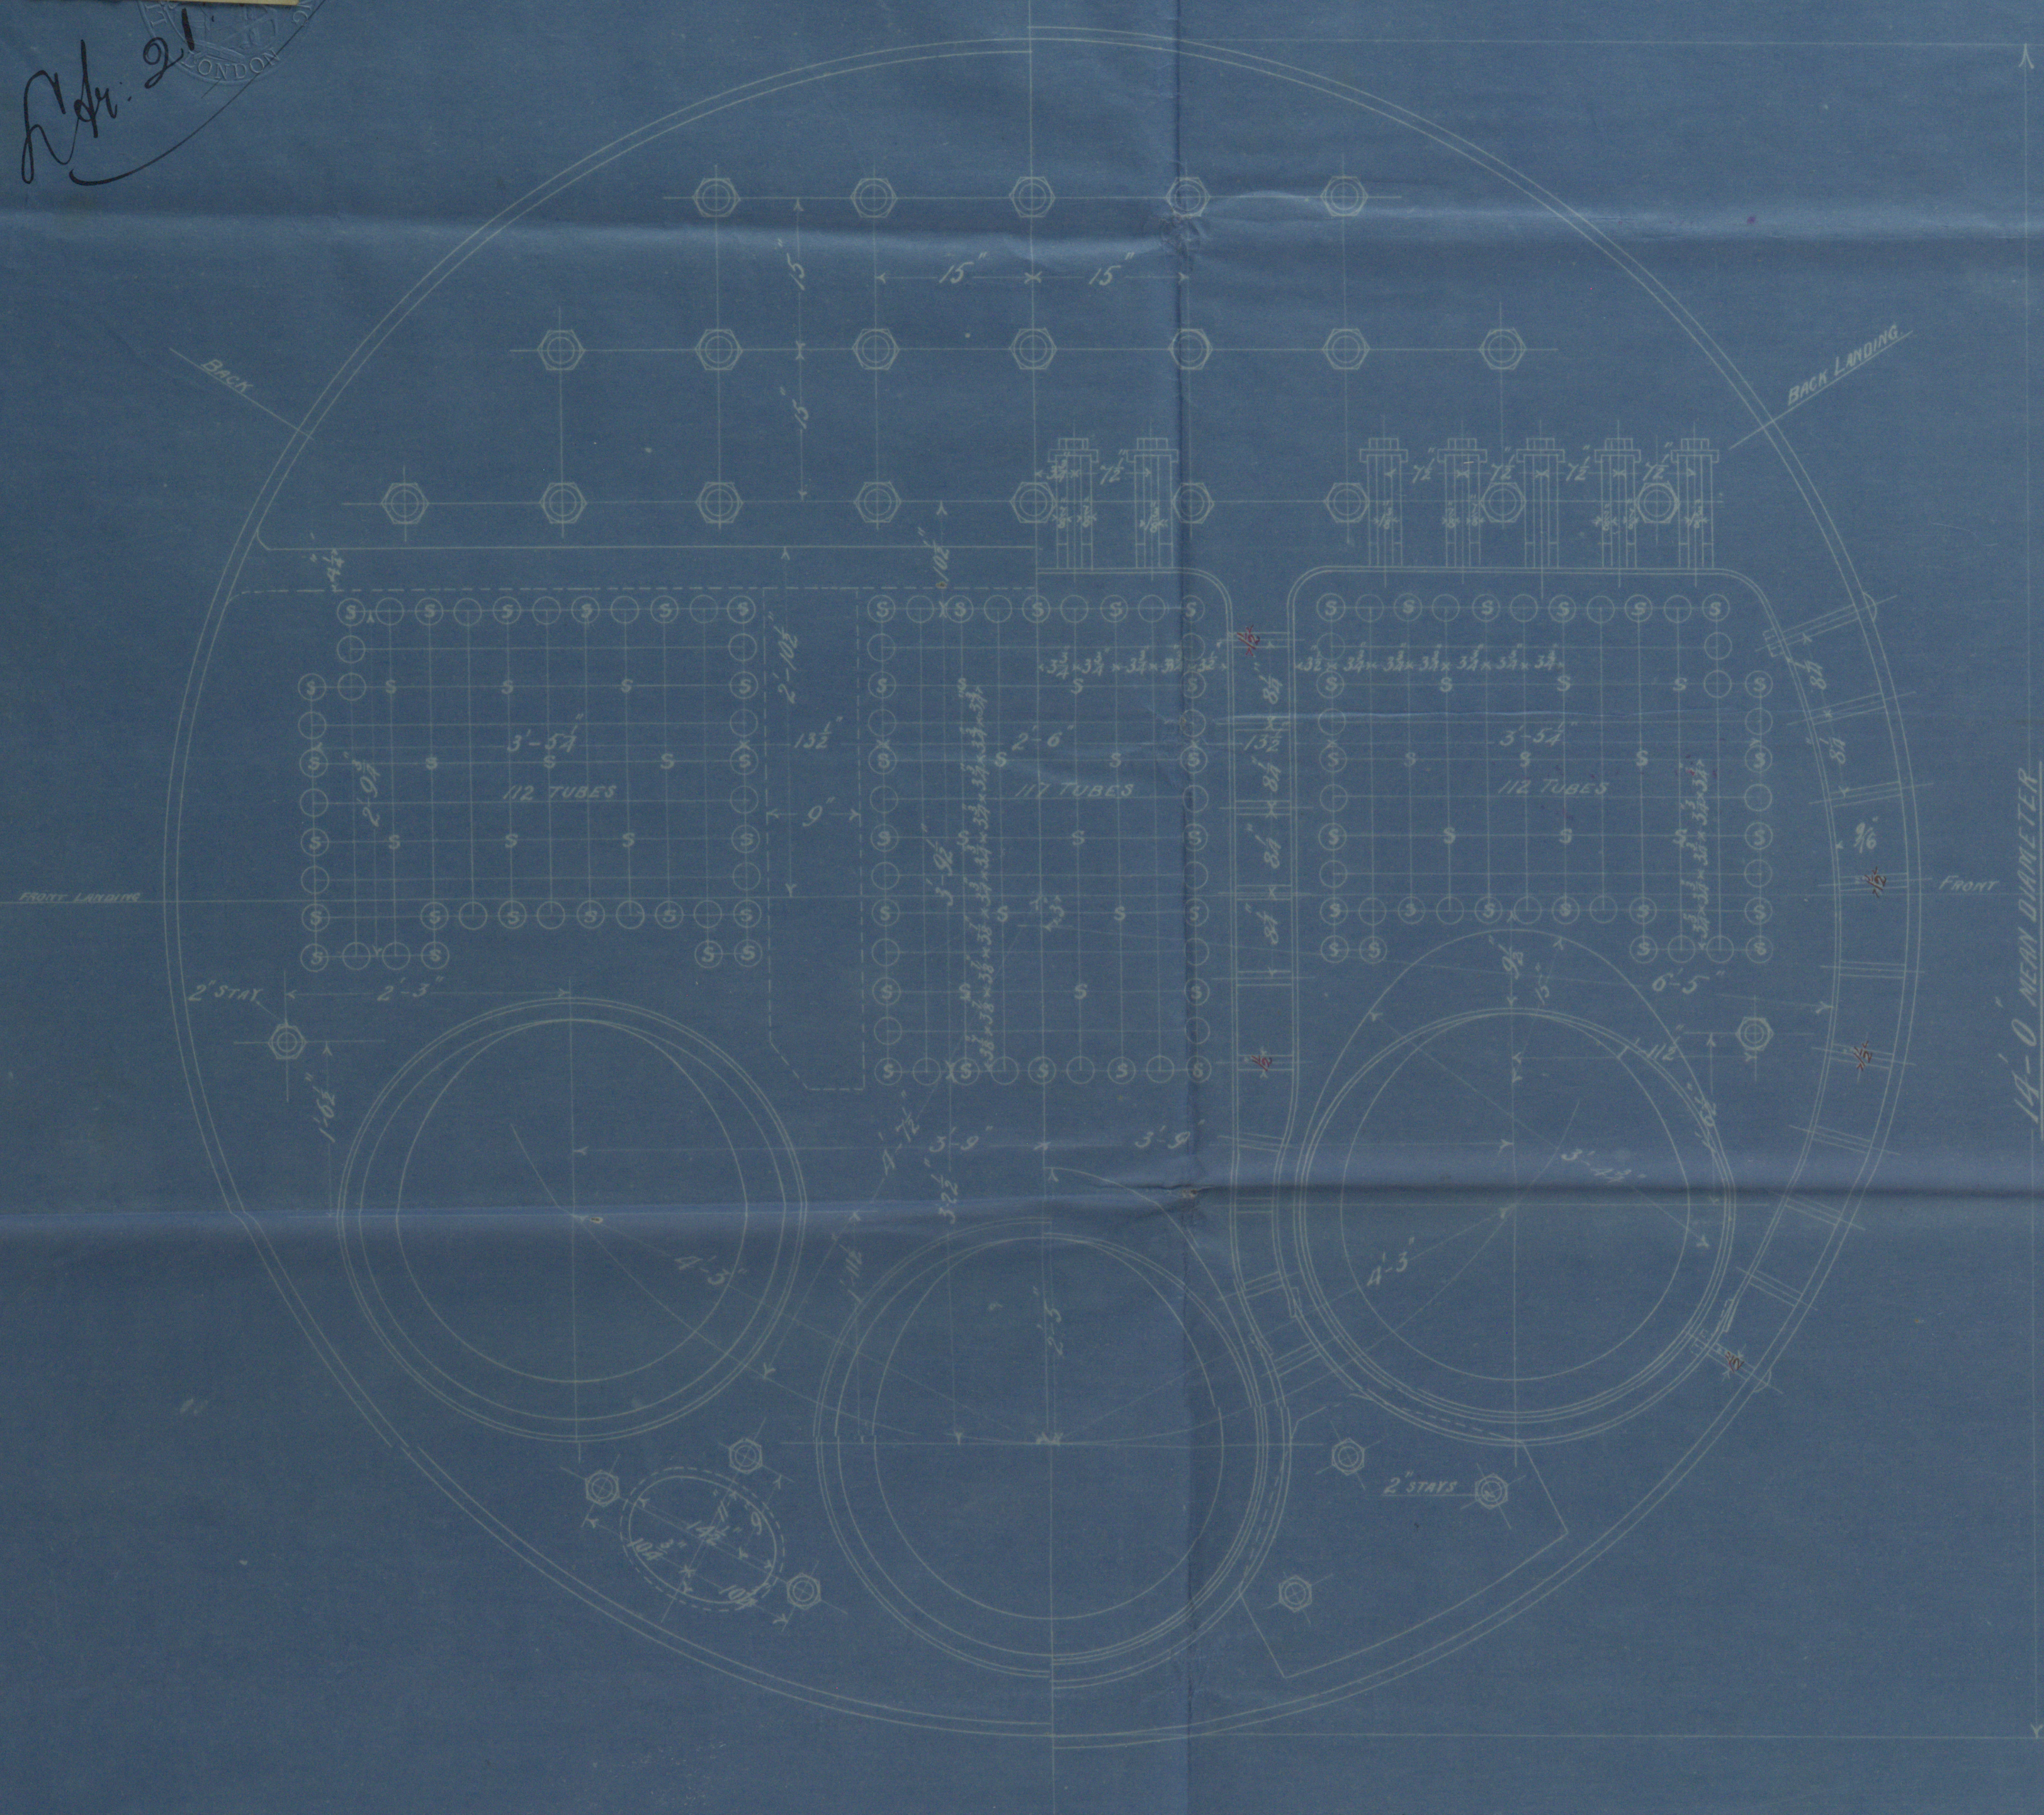


N^o 316 BOILER FOR S. S. "LAMINGTON"


160 LBS. WORKING PRESSURE

British Corporation Lloyds, Glasgow

Scale 1" = 1 foot

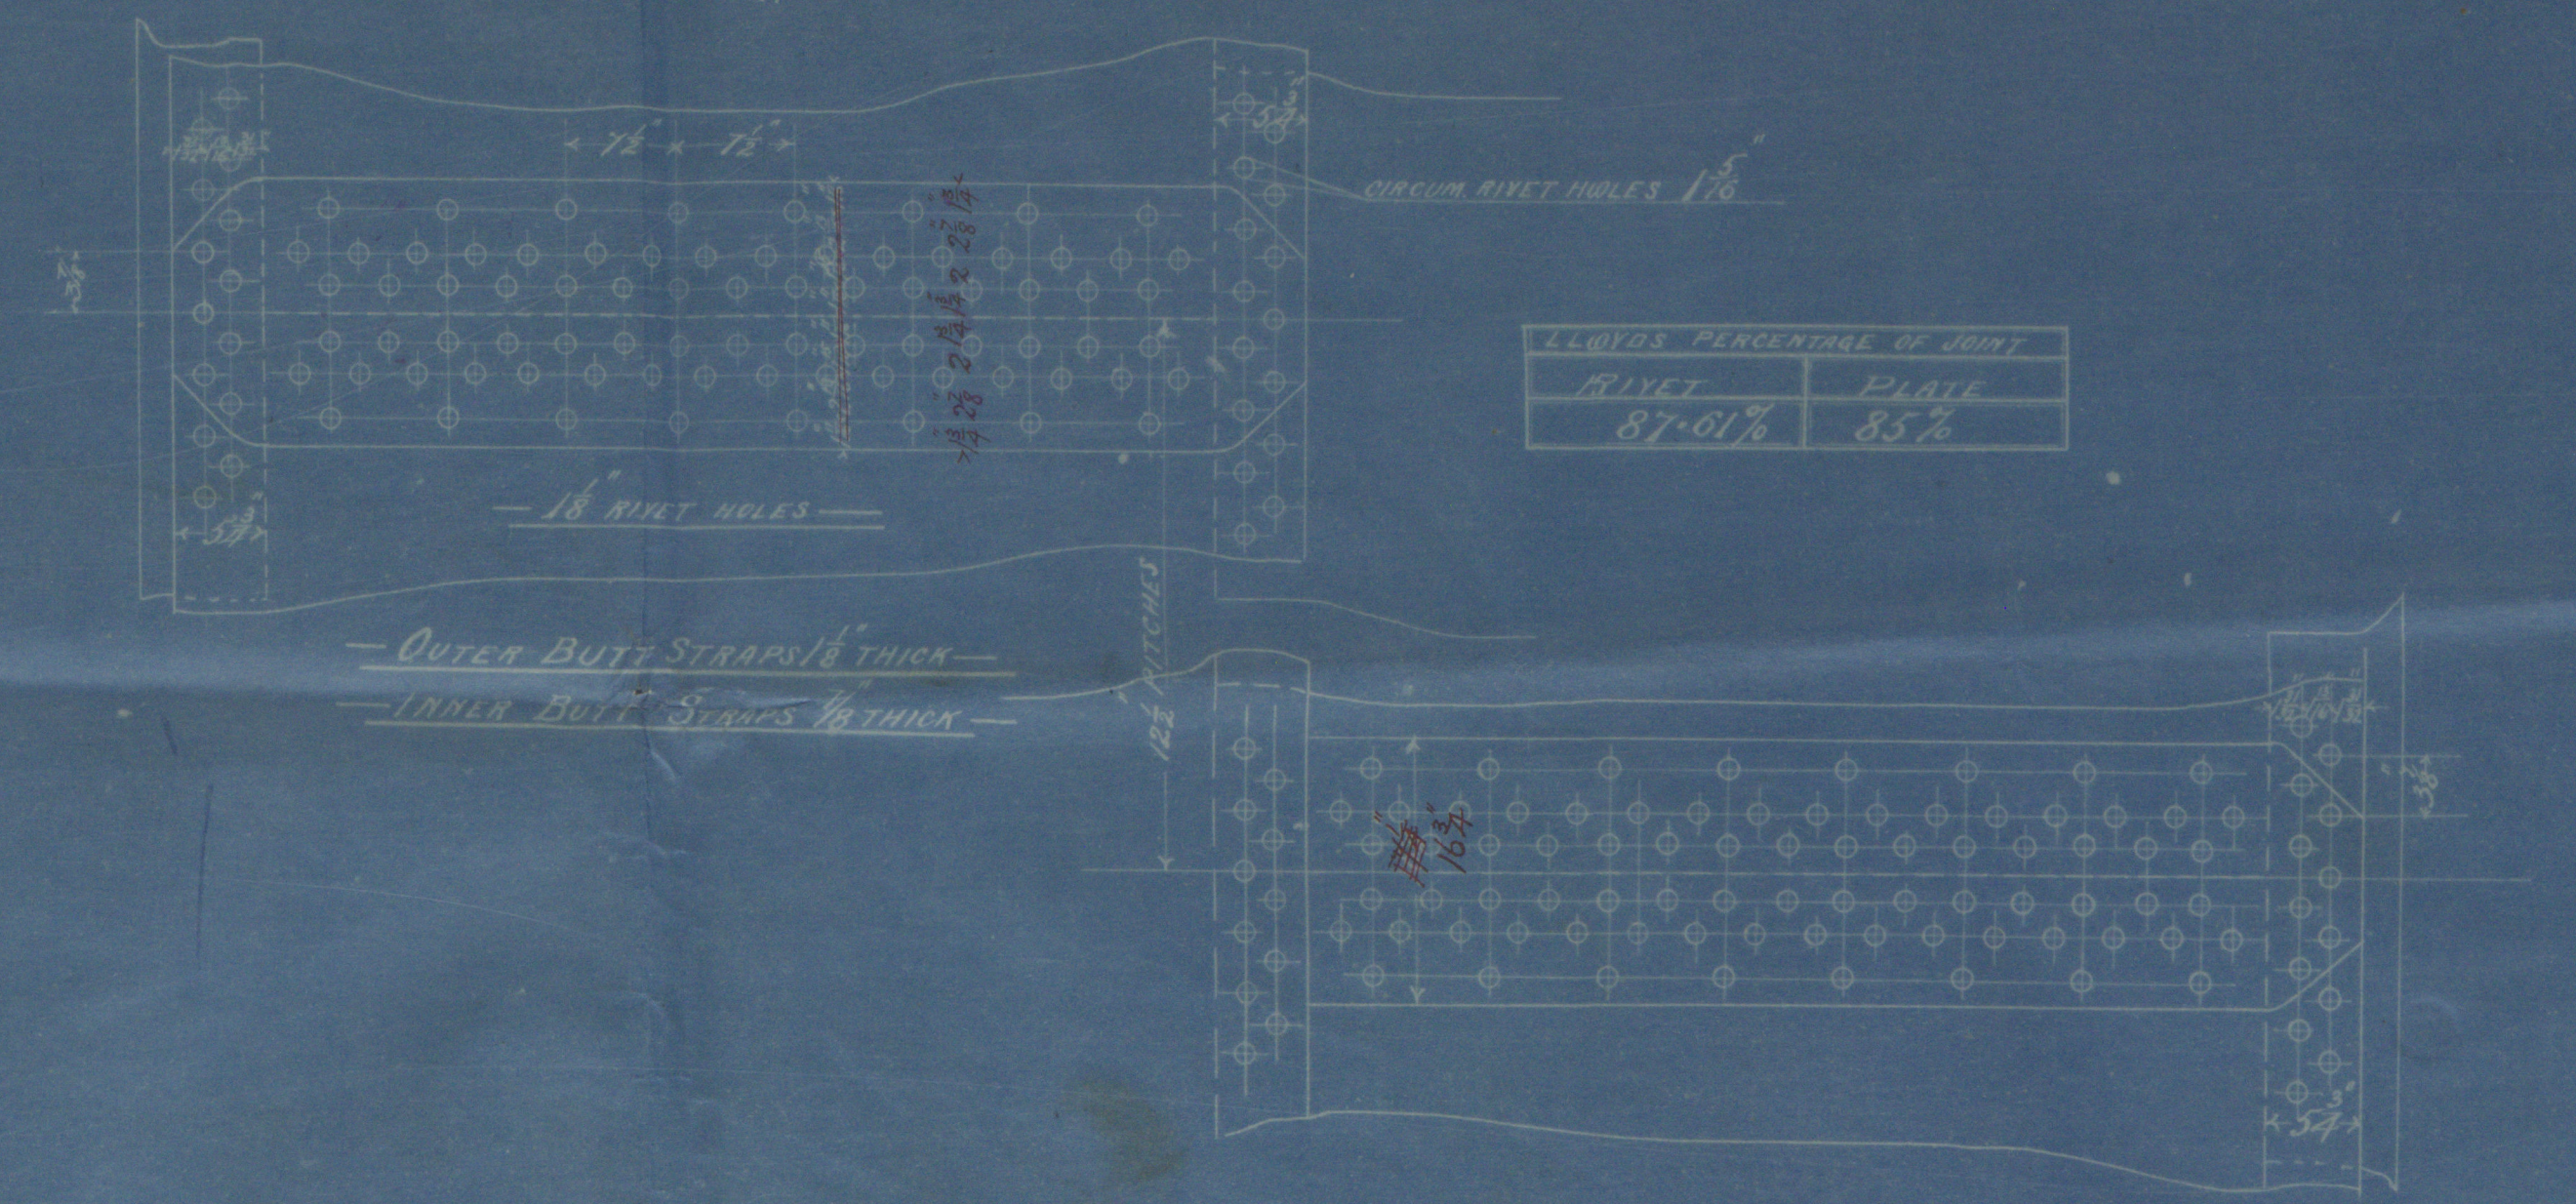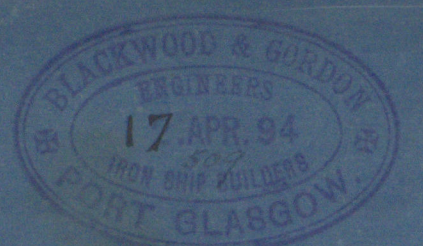

LLOYD'S PERCENTAGE OF JOINT	

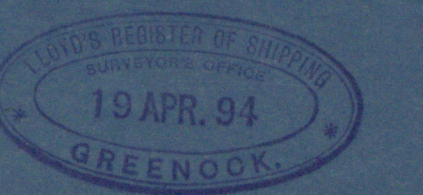

J. M.
20/4/94



GREENOCK

Main Boiler
For
S S Lamington⁹



© 2020

Lloyd's Register
Foundation
GRK 329-0009