



10.5.94
22.5.94


Tannassos.

Midship Section

N° 369

Reg. Dim. 270'x41'-2"x23'-6"


Scale 1/2 inch = 1 foot

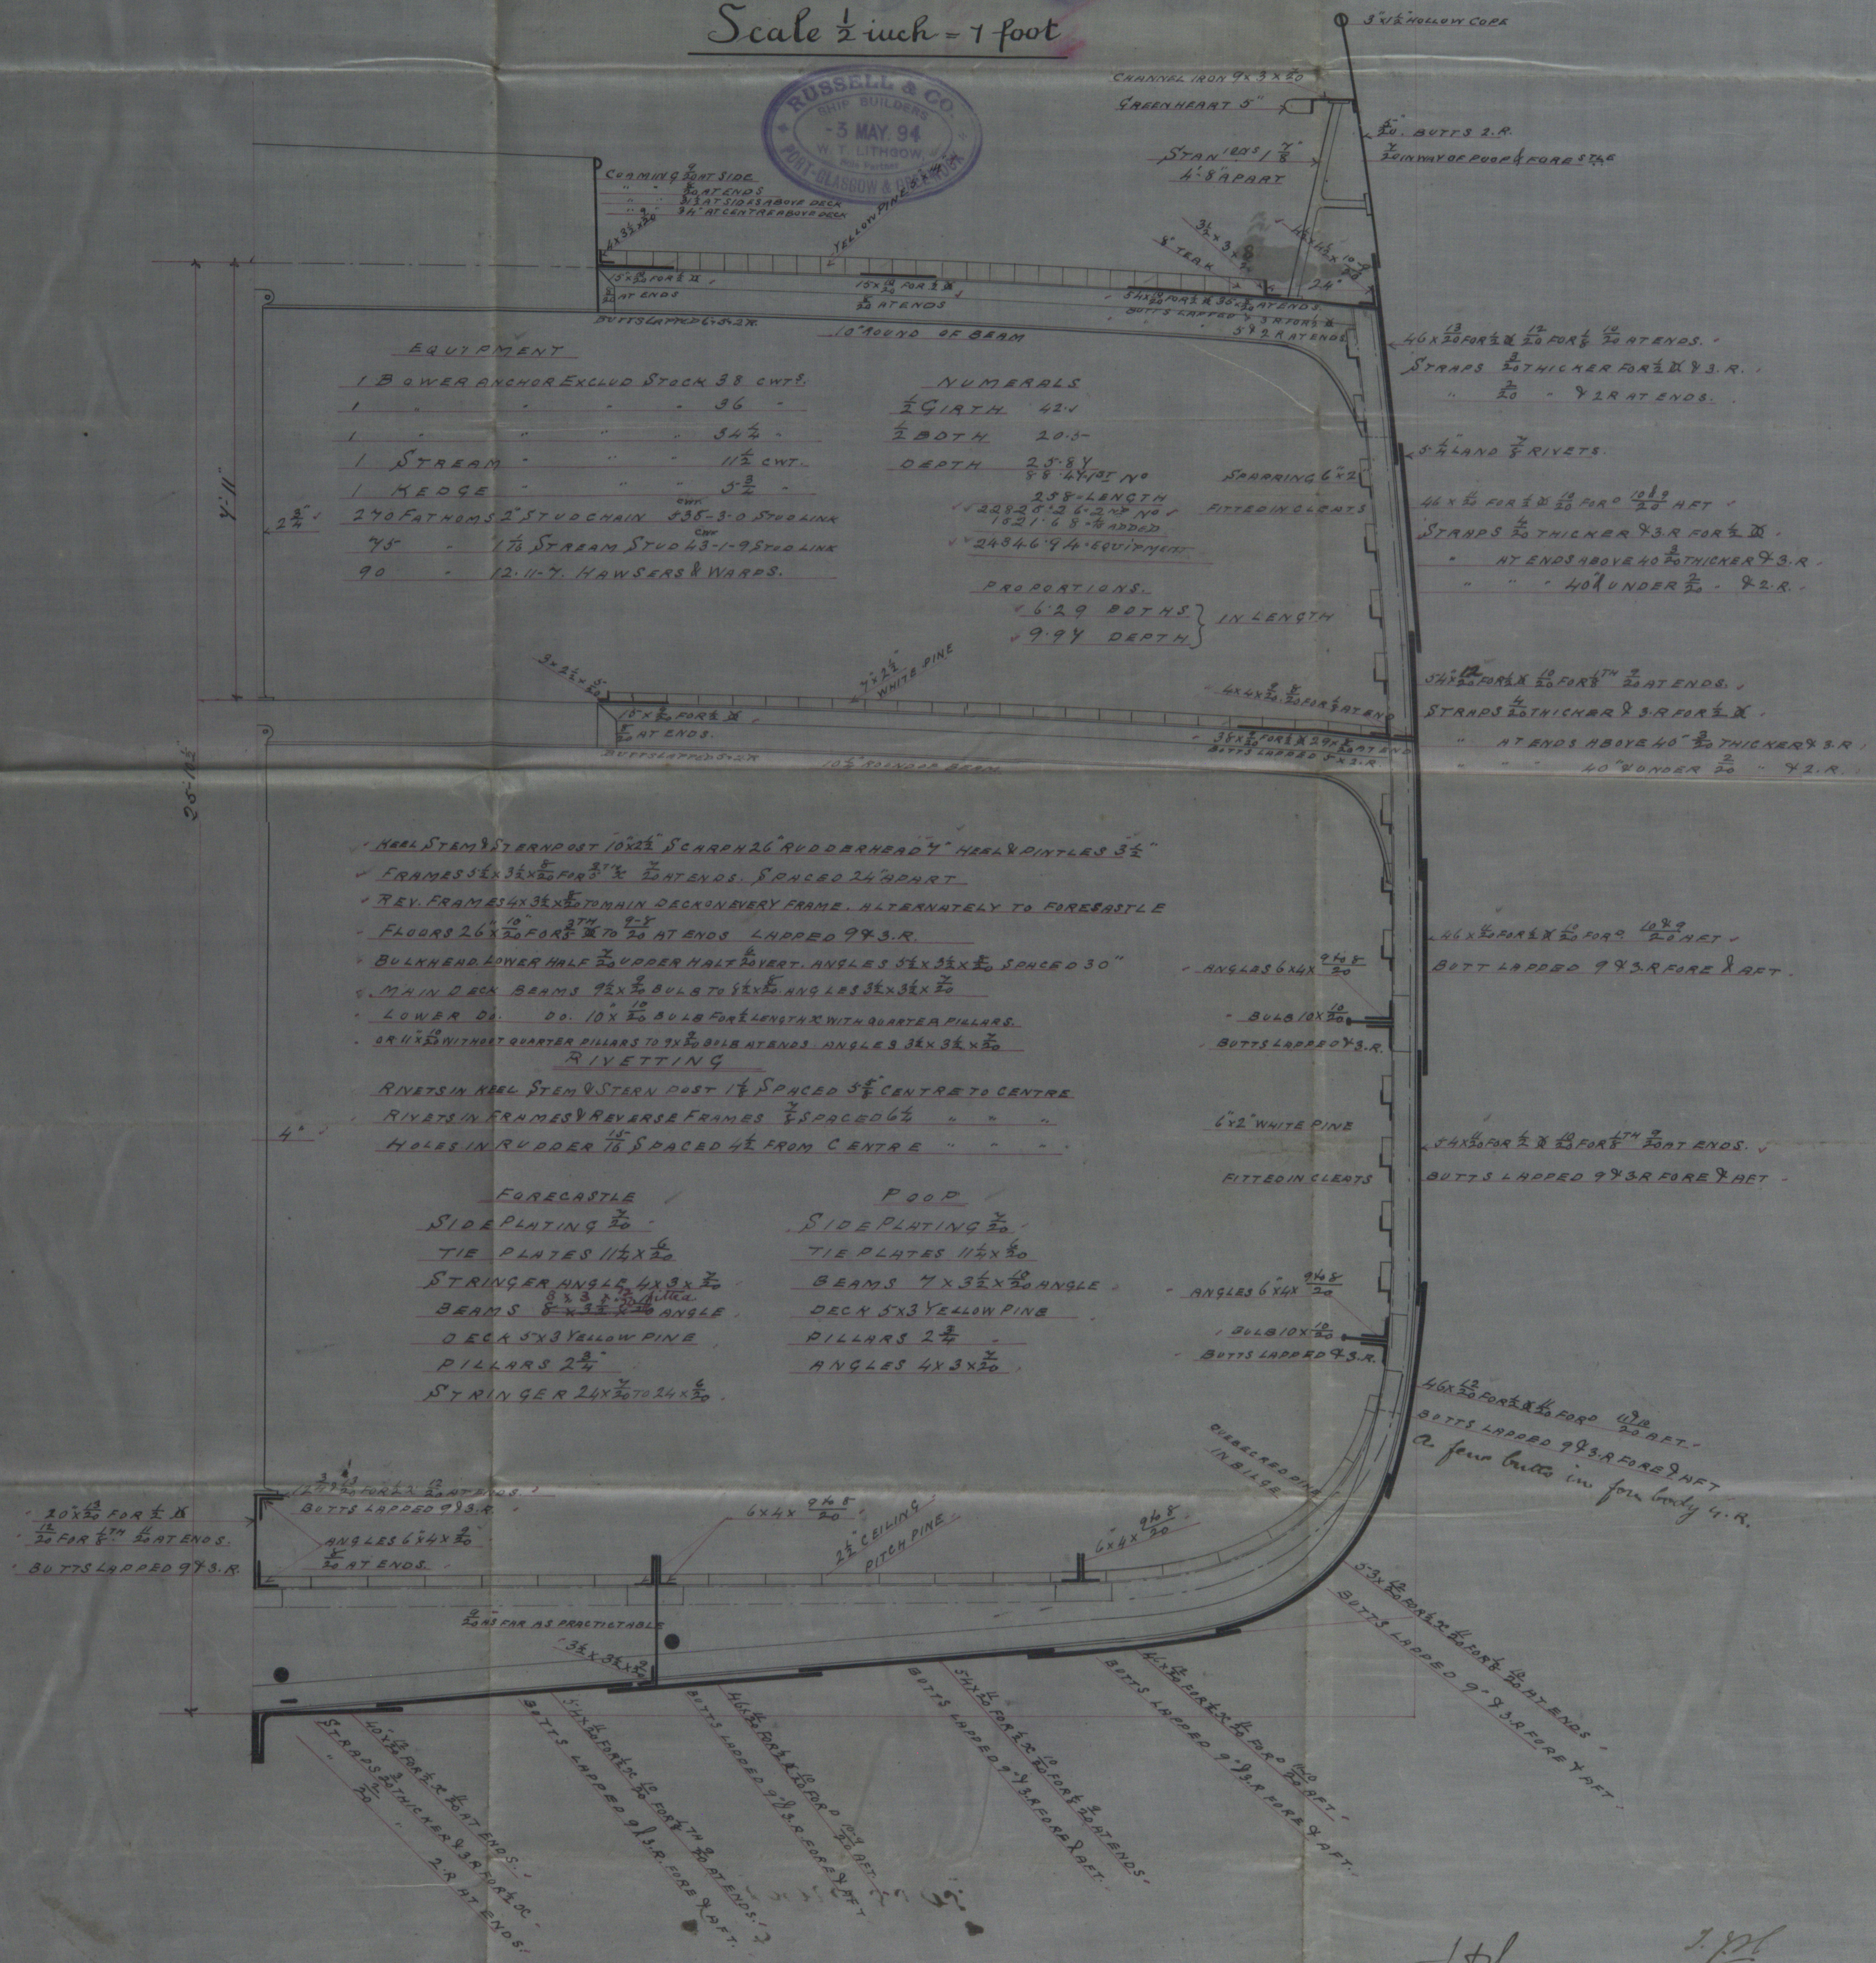

J.H.B.
10/5/94

J.H.B.

Midship section
Russell's
N^o 369

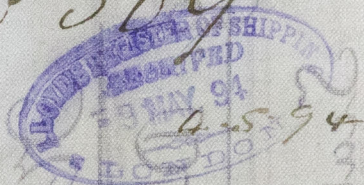

"Farnasso"



© 2020

Lloyd's Register
Foundation

GRK329-0026