

Lloyd's Register of British and Foreign Shipping.

(Report on Vessel No. *11094* Port *Greenock*)No. *2170*

SHIP FORGINGS OR CASTINGS.

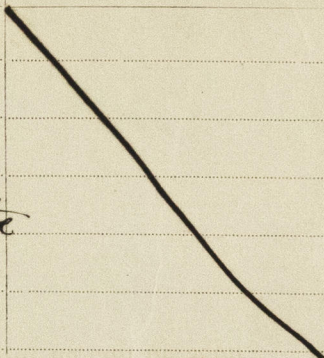
I have to report that the undermentioned Iron ~~or Steel~~ Forgings ~~or Castings~~,
 manufactured by *The Jarrow Forge & Co*
 of *Jarrow* for the Vessel No. *369*, being built
 by *Messrs Russell & Co* of *Greenock*
 have been inspected by me as set forth below, and found to be, so far as can be seen,
Sound

Mark on Forgings.

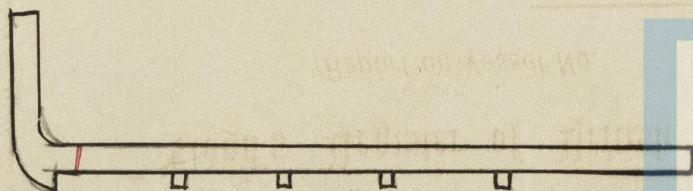
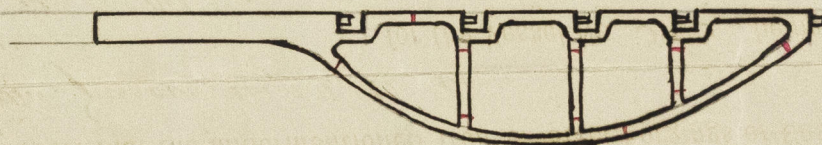
Lloyd's

No. *3637B**JE*

John C Craig
Newcastle

	STERN FRAME.	RUDDER FRAME.	STEM.
Material* ...	<i>Scrap Iron</i>	<i>Scrap Iron</i>	
How made ...	<i>Forged</i>	<i>Forged</i>	
Dimensions ...	<i>10 - 2 1/2</i>	<i>7 - 3 1/2</i>	
Progress on Inspection	<i>Forged & Smithed</i>	<i>Forged & Smithed</i>	
Date when Inspected	<i>April 26 May 2 8-11/94</i>	<i>June 6-14-18 July 4-10-13/94</i>	

SKETCHES OF FRAMES SHOWING POSITION AND DESCRIPTION OF WELDS OF FORGINGS, OR PARTICULARS OF TESTS APPLIED TO CASTINGS.

*welds*

© 2019

J. J. H.
 Lloyd's Register
 Foundation