

10.5.94


Garnassos.

PANTING ARRANGEMENT

— MAIN & LOWER DECK PLANS

- N^o 369 -

— SCALE $\frac{1}{4}$ INCH = ONE FOOT —

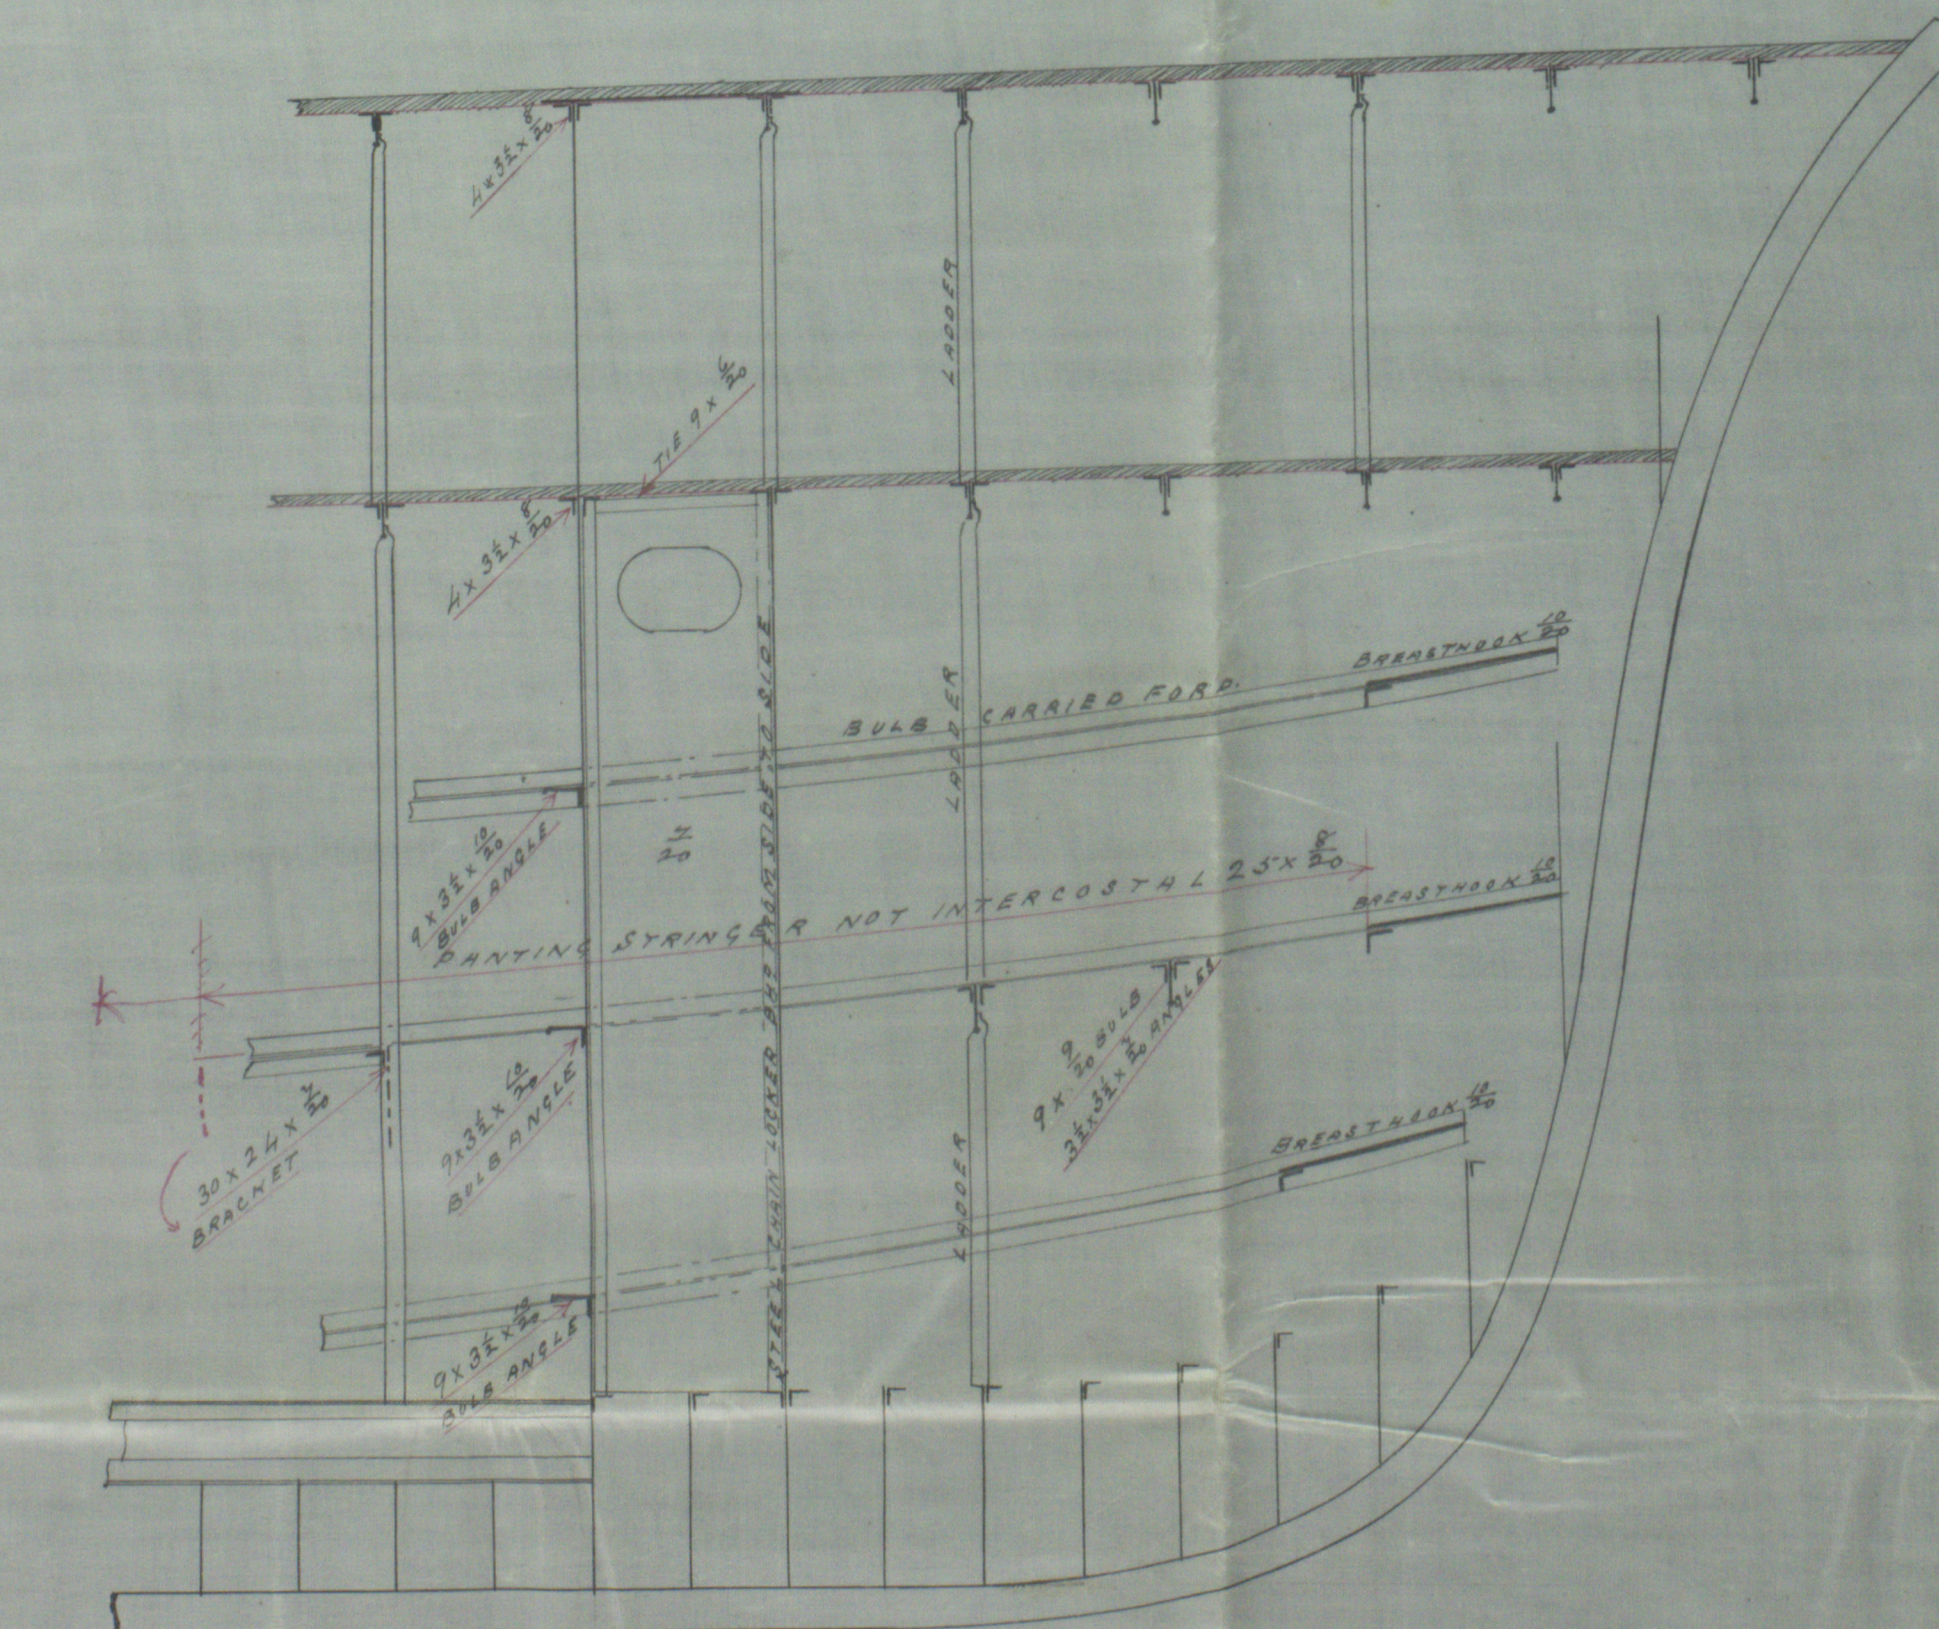

PANTING ARRANGEMENT:

10/5/94



*"Barroso"
Capt. H. H. 11074*

*Shipping arrangements
Main & lower Deck
Plan*

*Russell & Co
No 369*

14. 5. 94



© 2020

Lloyd's Register
Foundation

GRK 329-0033