

G.R. 11120

Lloyd's Register of British and Foreign Shipping.

(Report on Vessel No. _____ Port _____)

No. **4432** SHIP FORGINGS ~~OR CASTINGS~~.

I have to report that the undermentioned Iron or Steel Forgings or Castings, manufactured by *Messrs Robt Kerr & Sons*

of *Irvine* for the Vessel No. *125*, being built by *Messrs Murdoch & Murray* of *Port Glasgow*

have been inspected by me as set forth below, and found to be, so far as can be seen, *Sound & efficient*

Mark on Forgings.

Lloyd's
No. *4432*
W. H.

William Hamilton

Glasgow

~~STERN FRAME~~


~~RUBBER FRAME~~

7/6/94
STEM. *Kulbars*

Material*	...
How made	...
Dimensions	...
Progress on Inspection	...
Date when Inspected	...

<i>Scrap iron</i>	<i>Scrap iron</i>
<i>Forged</i>	<i>Forged</i>
<i>6 1/2 x 3</i>	<i>6 1/2 x 1 1/2 to 7 x 1 1/2</i>
<i>Forging & smithing</i>	<i>Forging</i>
<i>22-25/10-12/14</i>	<i>22-25-26/94</i>
<i>21/5/94-2.4.7/6/94</i>	

SKETCHES OF FRAMES SHOWING POSITION AND DESCRIPTION OF WELDS OF FORGINGS, OR PARTICULARS OF TESTS APPLIED TO CASTINGS.

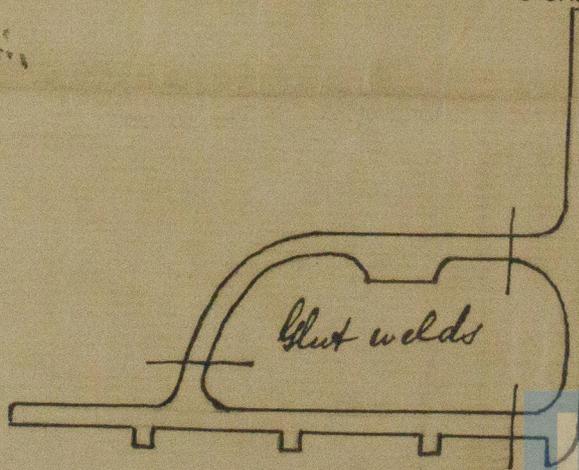

G.R. 329-0132

G.R. 329-0132

G.R. 329-0132