

Lloyd's Register of British and Foreign Shipping.

(Report on Vessel No. _____ Port _____)

No. 4432 SHIP FORGINGS OR CASTINGS.

I have to report that the undermentioned Iron or Steel Forgings or Castings, manufactured by *Messrs Robt Kerr & Sons* of *Irvine* for the Vessel No. *125*, being built by *Messrs Murdoch & Murray* of *Port Glasgow* have been inspected by me as set forth below, and found to be, so far as can be seen, *Sound & efficient*

The words FORGINGS or CASTINGS, IRON or STEEL, should be struck out as may be required.

Mark on Forgings.

Lloyd's


No. 4432

W.H.

William Hamilton
Glasgow 10/7/94

	STERN FRAME.	RUDDER FRAME.	STEM.
Material* ...		<i>Scrap iron</i>	
How made ...		<i>Forged</i>	
Dimensions ...		<i>4 1/4 to 2 1/2</i>	
Progress on Inspection		<i>Forging & smithing</i>	
Date when Inspected		<i>19. 22. 27. 29/4/94</i> <i>4. 10/7/94</i>	

SKETCHES OF FRAMES SHOWING POSITION AND DESCRIPTION OF WELDS OF FORGINGS, OR PARTICULARS OF TESTS APPLIED TO CASTINGS.

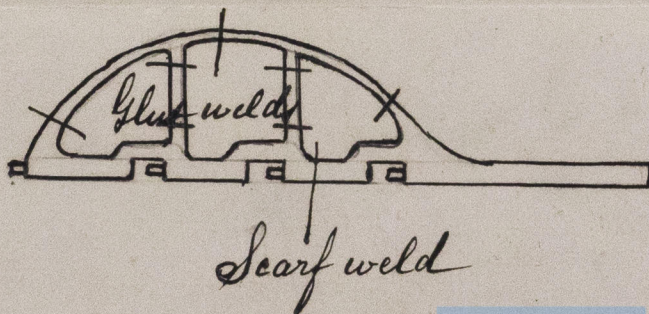

✓



© 2019

Lloyd's Register
Foundation