

Murdoch & Murray  
No. 125

No. 125

Ms. 11120.

1/2/07  
J.H.P.

5. 2. 1. 2. 3.

GRK329-0137


© 2019

Lloyd's Register  
Foundation



2.2.92

Murdoch & Murray's  
No. 125

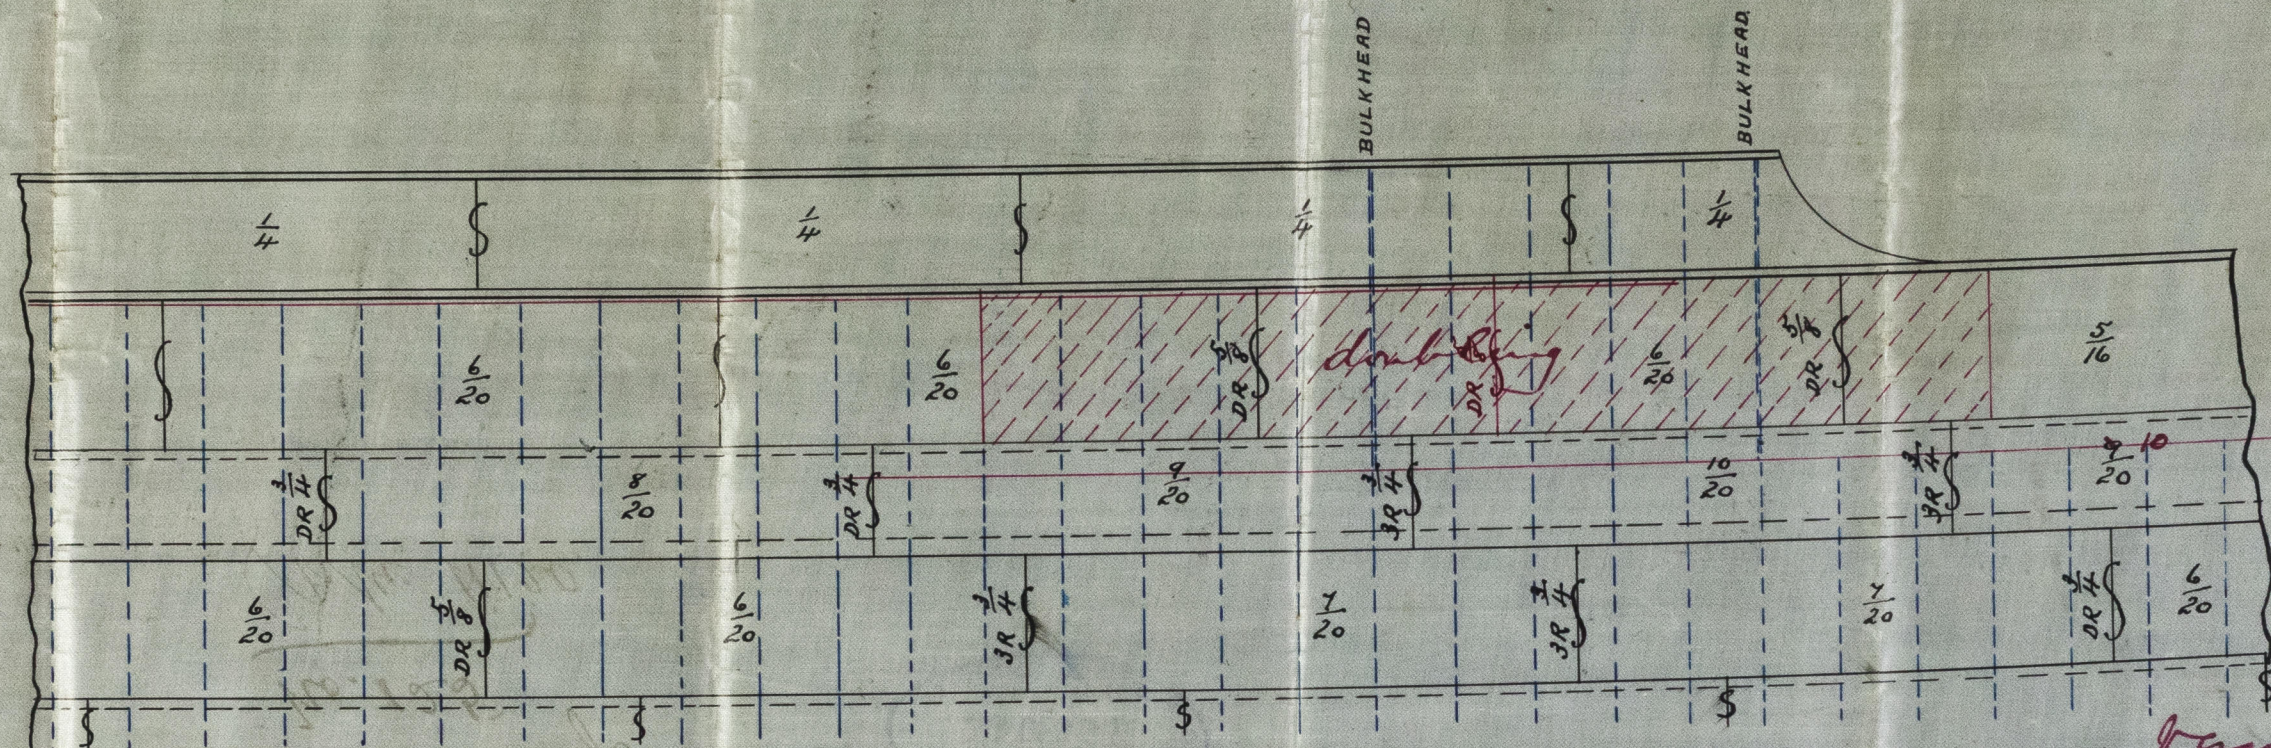

NOTE Increased thickness in those two strakes is in lieu of sheerstrake doubling at front of bridge.

Used additionally strengthened at break to surveyor's satisfaction.

DRAWING No 2108.  
SCALE 1/4 INCH TO A FOOT.

ARRANGEMENT OF PLATING  
AT BREAK  
S.S. No 125



J.H.L.  
2/2/92

