
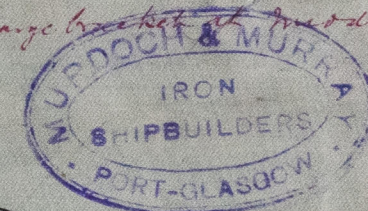
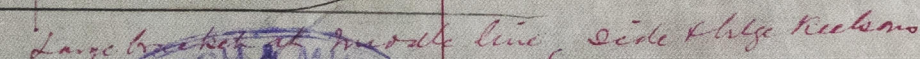



Murdoch Murray's No. 125.

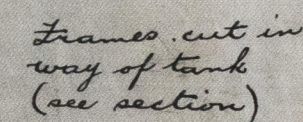

PROFILE & DECK PLAN
STEEL SCREW STEAMER
Nº 125.

DRAWING N^o 2107
SCALE $\frac{1}{8}$ INCH TO A FOOT

SECTION SHEWING
BRACKETS IN LIEU OF PILLARS
AT SIDES IN WAY OF MAIN HATCH

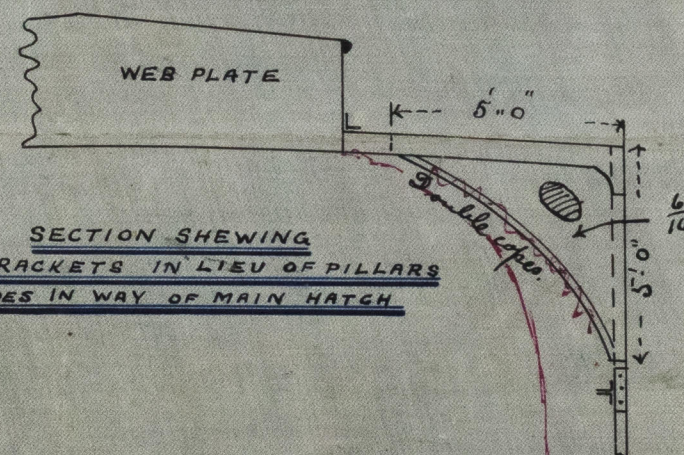

J. V. L.
2/2/92

12/1/21

Murdoch & Murray No. 125

NO. 125
SHEET 1 OF 2
MURDOCH & MURRAY

NO. 125
SHEET 1 OF 2
MURDOCH & MURRAY

Murdoch & Murray
No. 125.

Profile deck
plans.

G. T. 1120

LOYD'S REGISTER OF SHIPING
RECEIVED
24 JAN 91
LONDON

GRK329-0139



© 2020
Lloyd's Register
Foundation