



26.7.94  
 25.6.94  
 25.7.94

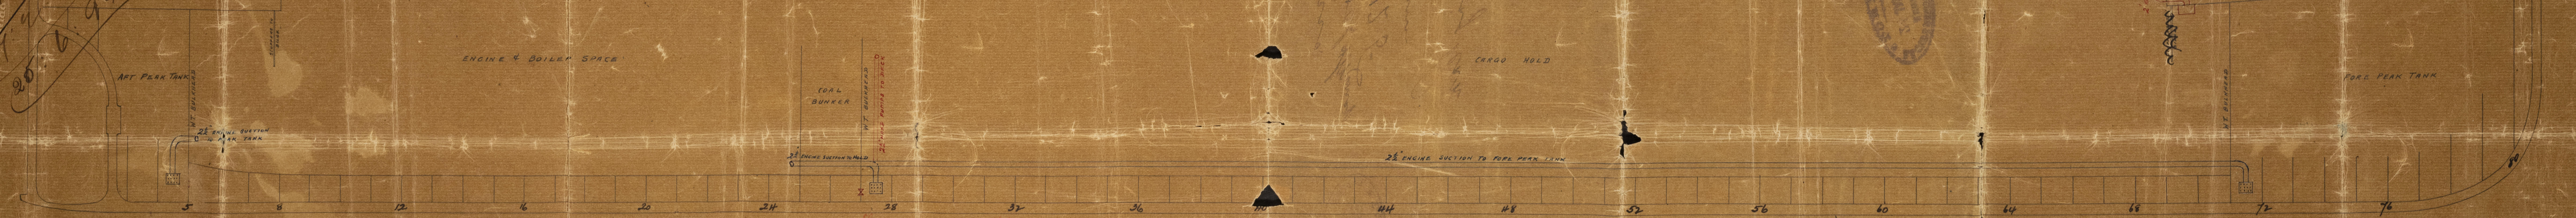

DRAWING No 2639.  
 SCALE 1/4" INCH TO A FOOT.

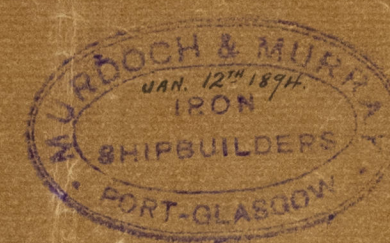




JIM  
 24/1/94  
 Lloyd's Register  
 Foundation



Messrs.  
No. 125  



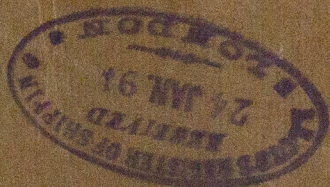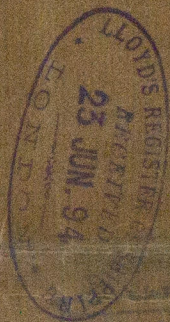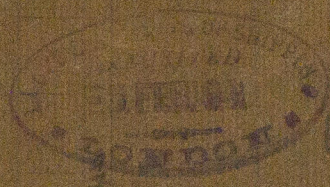

© 2020

Lloyd's Register  
Foundation