



27.2.94.
7.4.94


— Longitudinal Section & Deck Plans —
— S.S. No. 114 —
— Dimension 234' 0" x 31' 0" x 14' 3 1/4" hold —
— Scale 1/4" Inch = One Foot —

 

— Main Deck Plan —

 

— Hold Stringer Plan —

 

18.1
27/2/94

21 FEB 94
GREENOCK







Longitudinal section
& deck plans.

Hamilton Bay

No 117.

"Marbella"

GR 1128

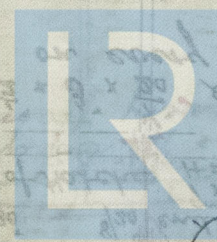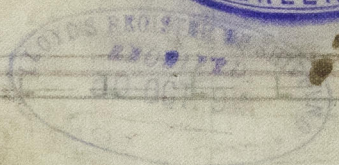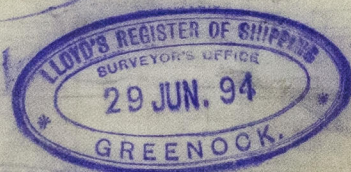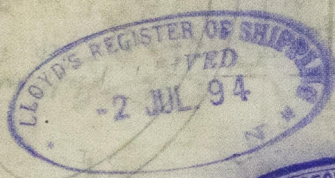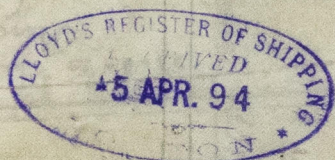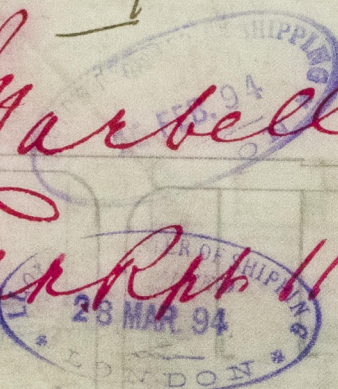

© 2020

Lloyd's Register
Foundation

GRK 329-0163