


3. 7. 94

— S. S. N° 117 —

— SCALE  $\frac{1}{4}$  INCH = 1 FOOT —

Bull plate  $7'' \times \frac{7}{8}''$   
Double angles  $3'' \times 3'' \times \frac{5}{8}''$

S  $\frac{1}{2}$  TRINGER plate  $7' \times 20'$  angles  $3' \times 3' \times 20'$   
 26' x 20' LAP BUTTS D.R.  
 Bull  
 Double

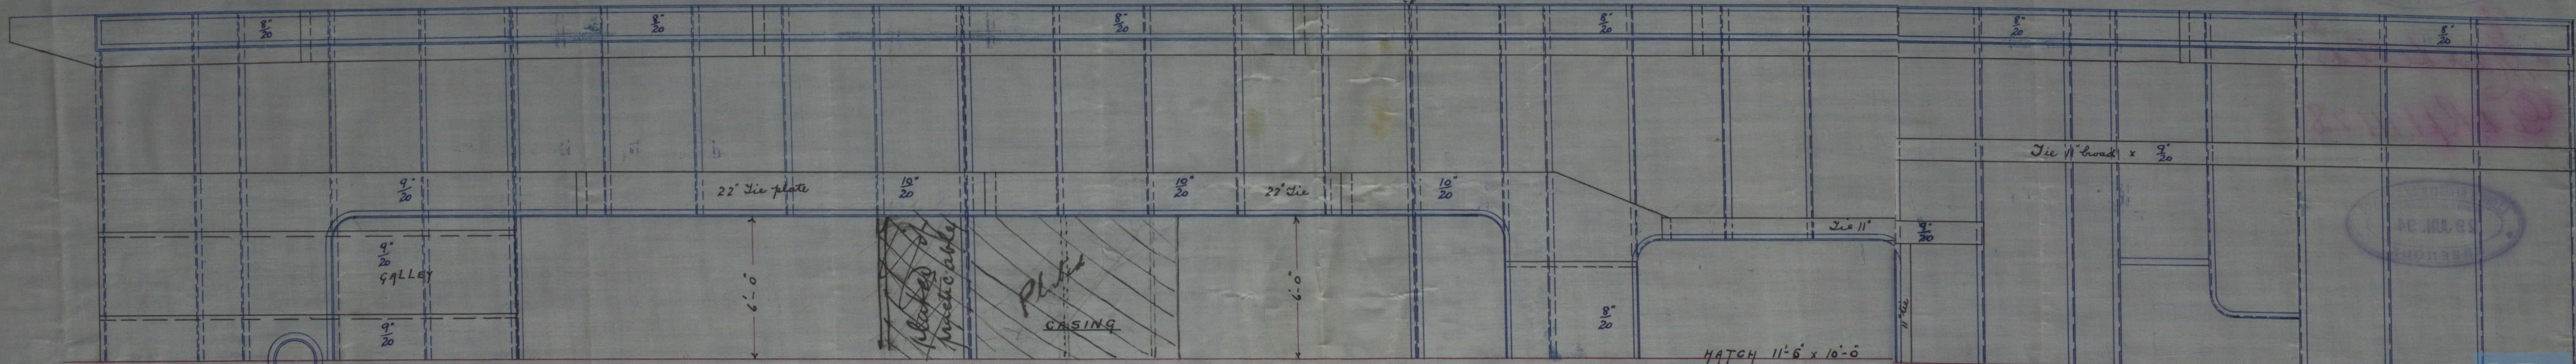

J.V.L.  
2/7/94

Lloyd's Register  
Foundation

GRK329-0191



W. Hamilton & Co.



N<sup>o</sup> 117

Plan of Bridge & K  
Plating



30.6.94

"Marbella"  
Gr. Rpt. 11128

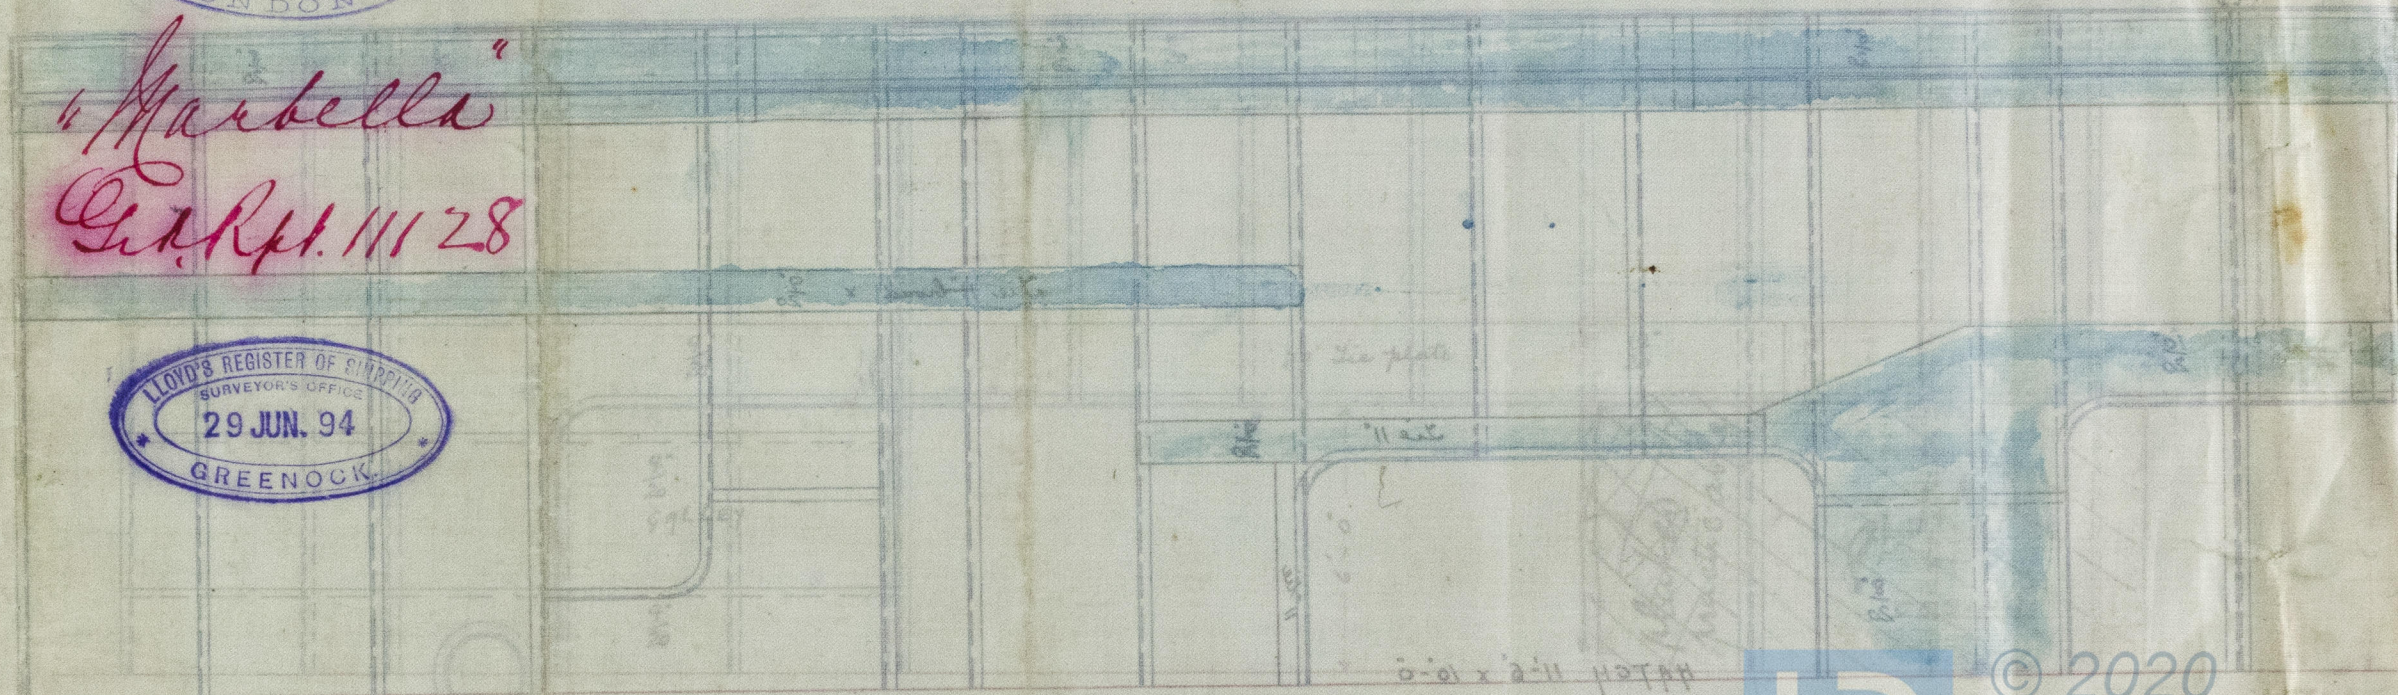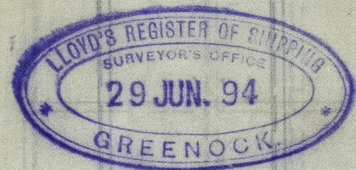

x p/10/108

W10-PSER 80

GRK 329 -0191

J. H. B.  
4/1/10



© 2020

Lloyd's Register  
Foundation