


Web frames in  
boiler space

Hamilton Bay.

Nov 17

"Marbella"

Grp Rpt 11128

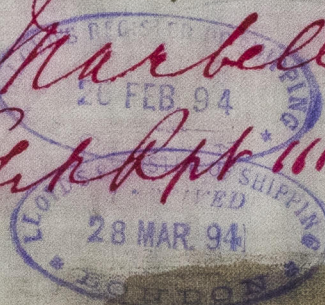

GRK 329-0193



© 2019

Lloyd's Register  
Foundation






27.2.94. — Plan of Web Frames — as fitted in  
 7.4.94 — in Boiler Space. —  
 — S. S. No 114 — Vessel.



Reversed  
frames double  
in boiler space

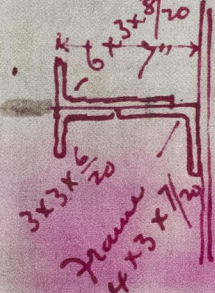

webs dispensed  
with.



— Scale 1/4 Inch = One Foot. —



© 2019

Lloyd's Register  
Foundation

GRK 329-0193

27/2/94