


Marbella
Grp Rpt.
11128

Hamilton & Co
Sp No 114

*Amended arrangement
of deep framing
in way of Boilers*

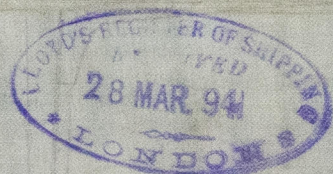

© 2019


Lloyd's Register
Foundation

GRK 329-0194

See letter
7.4.94

Section in way Boilers D. D. No 117 (Not approved)
Scale $\frac{1}{4}$ " = one foot

See other arrangement

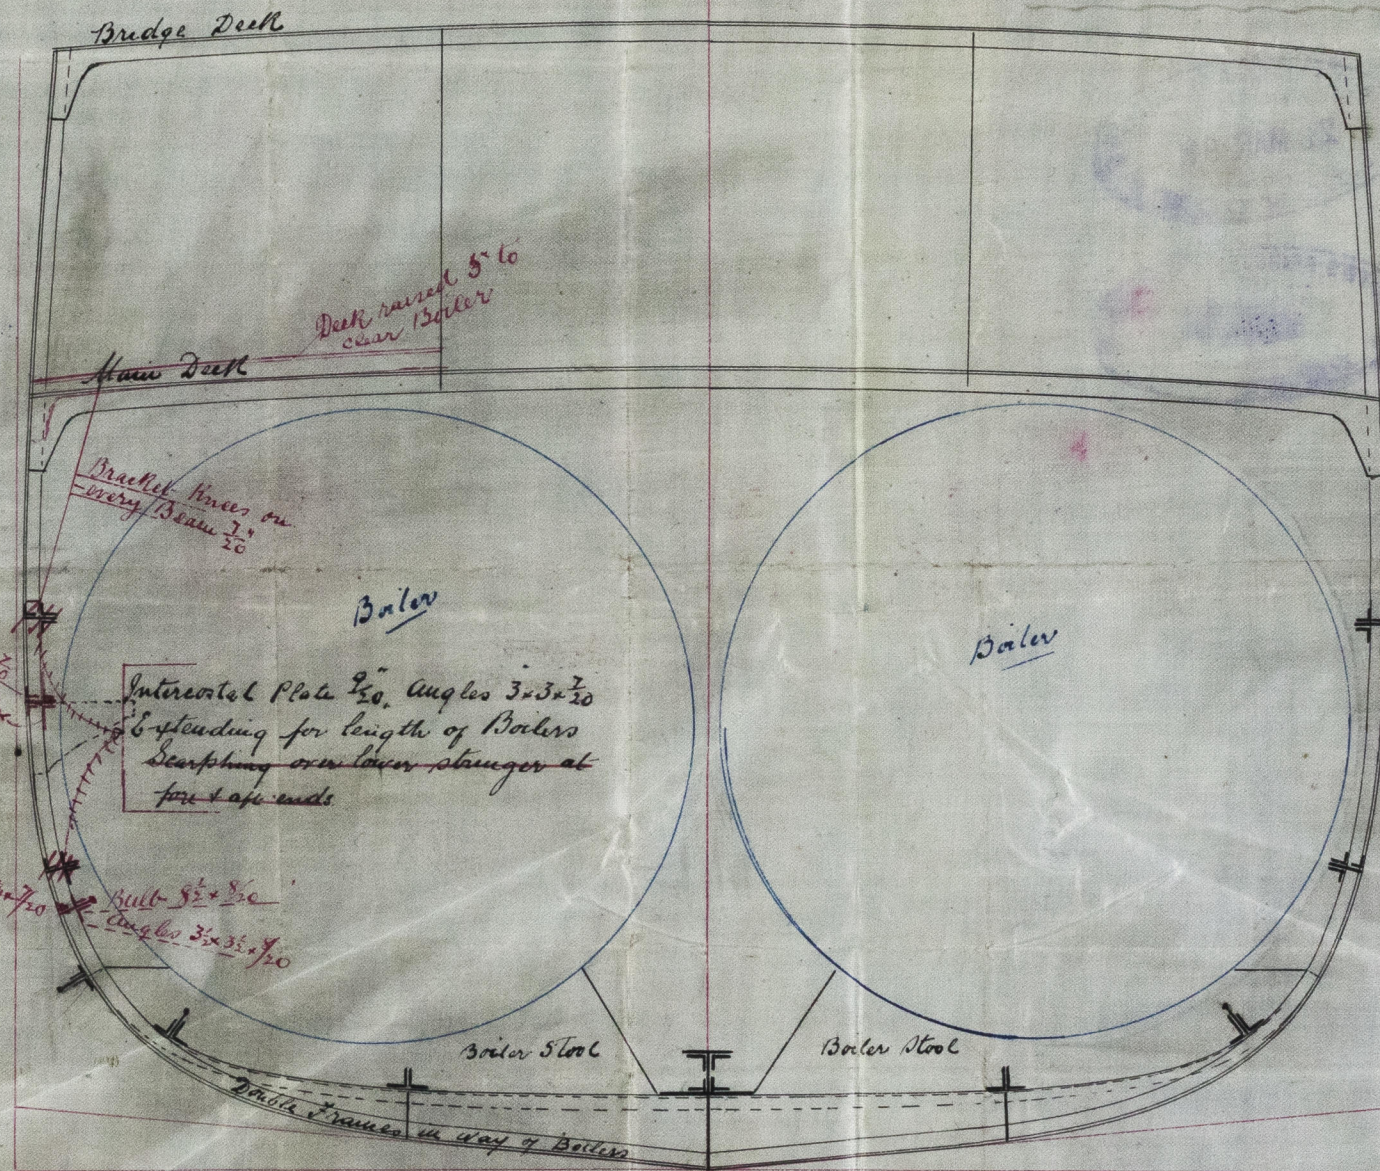

Section showing Double Frames
in way of Boilers

Reverse Box 3 1/2 x 3 1/2 x 7/20
Double Frames 4 x 3 x 7/20

