


JOSEPH T. ELTRINGHAM + Co
IRON SHIP & BOILER BUILDERS
SOUTH SHIELDS

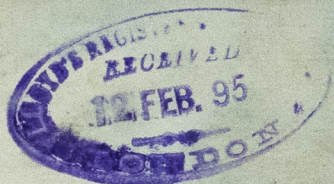

237

C

Eltringham 737

amended

In Stock

Late, S.S. "James Watt."
now named, "Neptune"

Ex. HH75
Slog as 2st
320 lbs
R.H.
13-12-94

July 11189

GRK330-0217



© 2020

Lloyd's Register
Foundation