

Lloyd's Register of British and Foreign Shipping.

(Report on Vessel No. 11291 Port *Buenos Aires*)

No. 4495 SHIP FORGINGS OR CASTINGS

I have to report that the undermentioned iron or steel forgings or castings, manufactured by *The Portland Forge Coy* of *Wilmamott* by *Messrs Russell & Co* of *Port Glasgow* for the vessel No. 361, being built *found & efficient* have been inspected by me as set forth below, and found to be, so far as can be seen,


The words FORGINGS or CASTINGS, IRON or STEEL, should be struck out as may be required.

Mark on Forgings.

W.M.  
No. 4495

Material*	How made	Dimensions	Progress on Inspection	Date when Inspected
Scrap iron	Forged	11 4 6	Forgings making	13/6/94 2-5-11-17/94 16.17.20.27/8/94.7.10.20. 21.28/9/94.9.12.16/10/94 6.7/11/94
Scrap iron	Forged	10 2 1/4 2 3/4	Forgings	22/6/94.11/7/94
STEM:				
RUDDER FRAME.				

*William Beaman*  
*Glasgow 11/94*

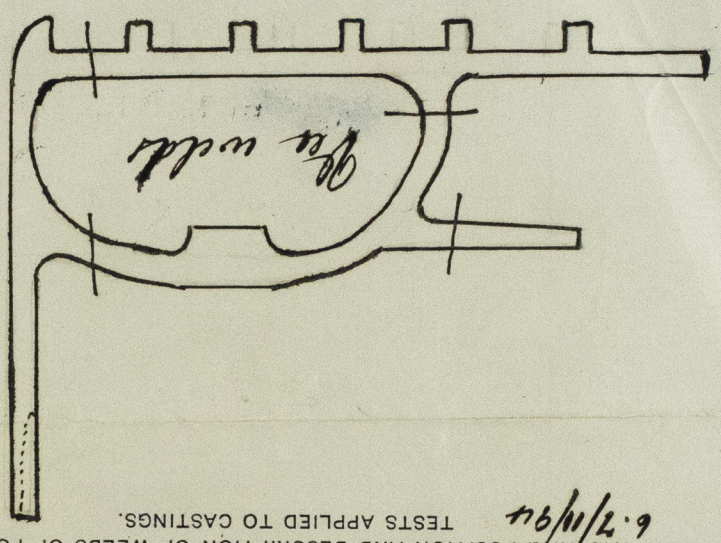

SKETCHES OF FRAMES SHOWING POSITION AND DESCRIPTION OF WELDS OF FORGINGS, OR PARTICULARS OF TESTS APPLIED TO CASTINGS.

\* If of Iron, state whether scrap or puddled Iron.

Figures 261

© 2019

Lloyd's Register  
Foundation