


12.3.94.

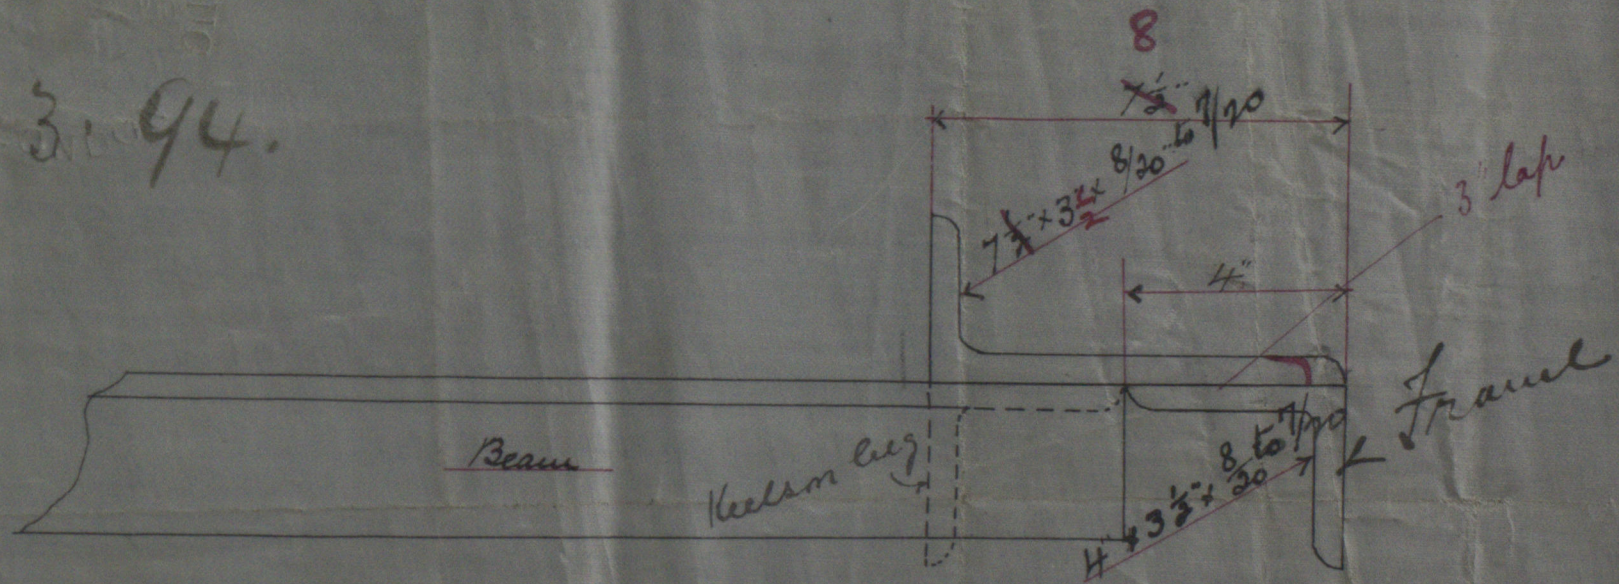

proposed deep framing

S.S. No. 36142

Scale 3 inches - one foot

A duplex  
S.A.M.

10/11/94

10/11/94

10/3/94



© 2020

Lloyd's Register  
Foundation