


8.2.94  
19.2.94  
12.3.94  
16.5.94  
15.5.95

S.S. No 361 + 2  
Midships Section  
340' x 43' 6" 42' 10" Mid. x 29' 0" ML to S. SK.  
To Class 100 A. 1st Spar Deck Rule  
Scale 1/2 inch = 1 foot.


Alternative proposal for framing  
Vessel built on the Deep Frame System  
as below

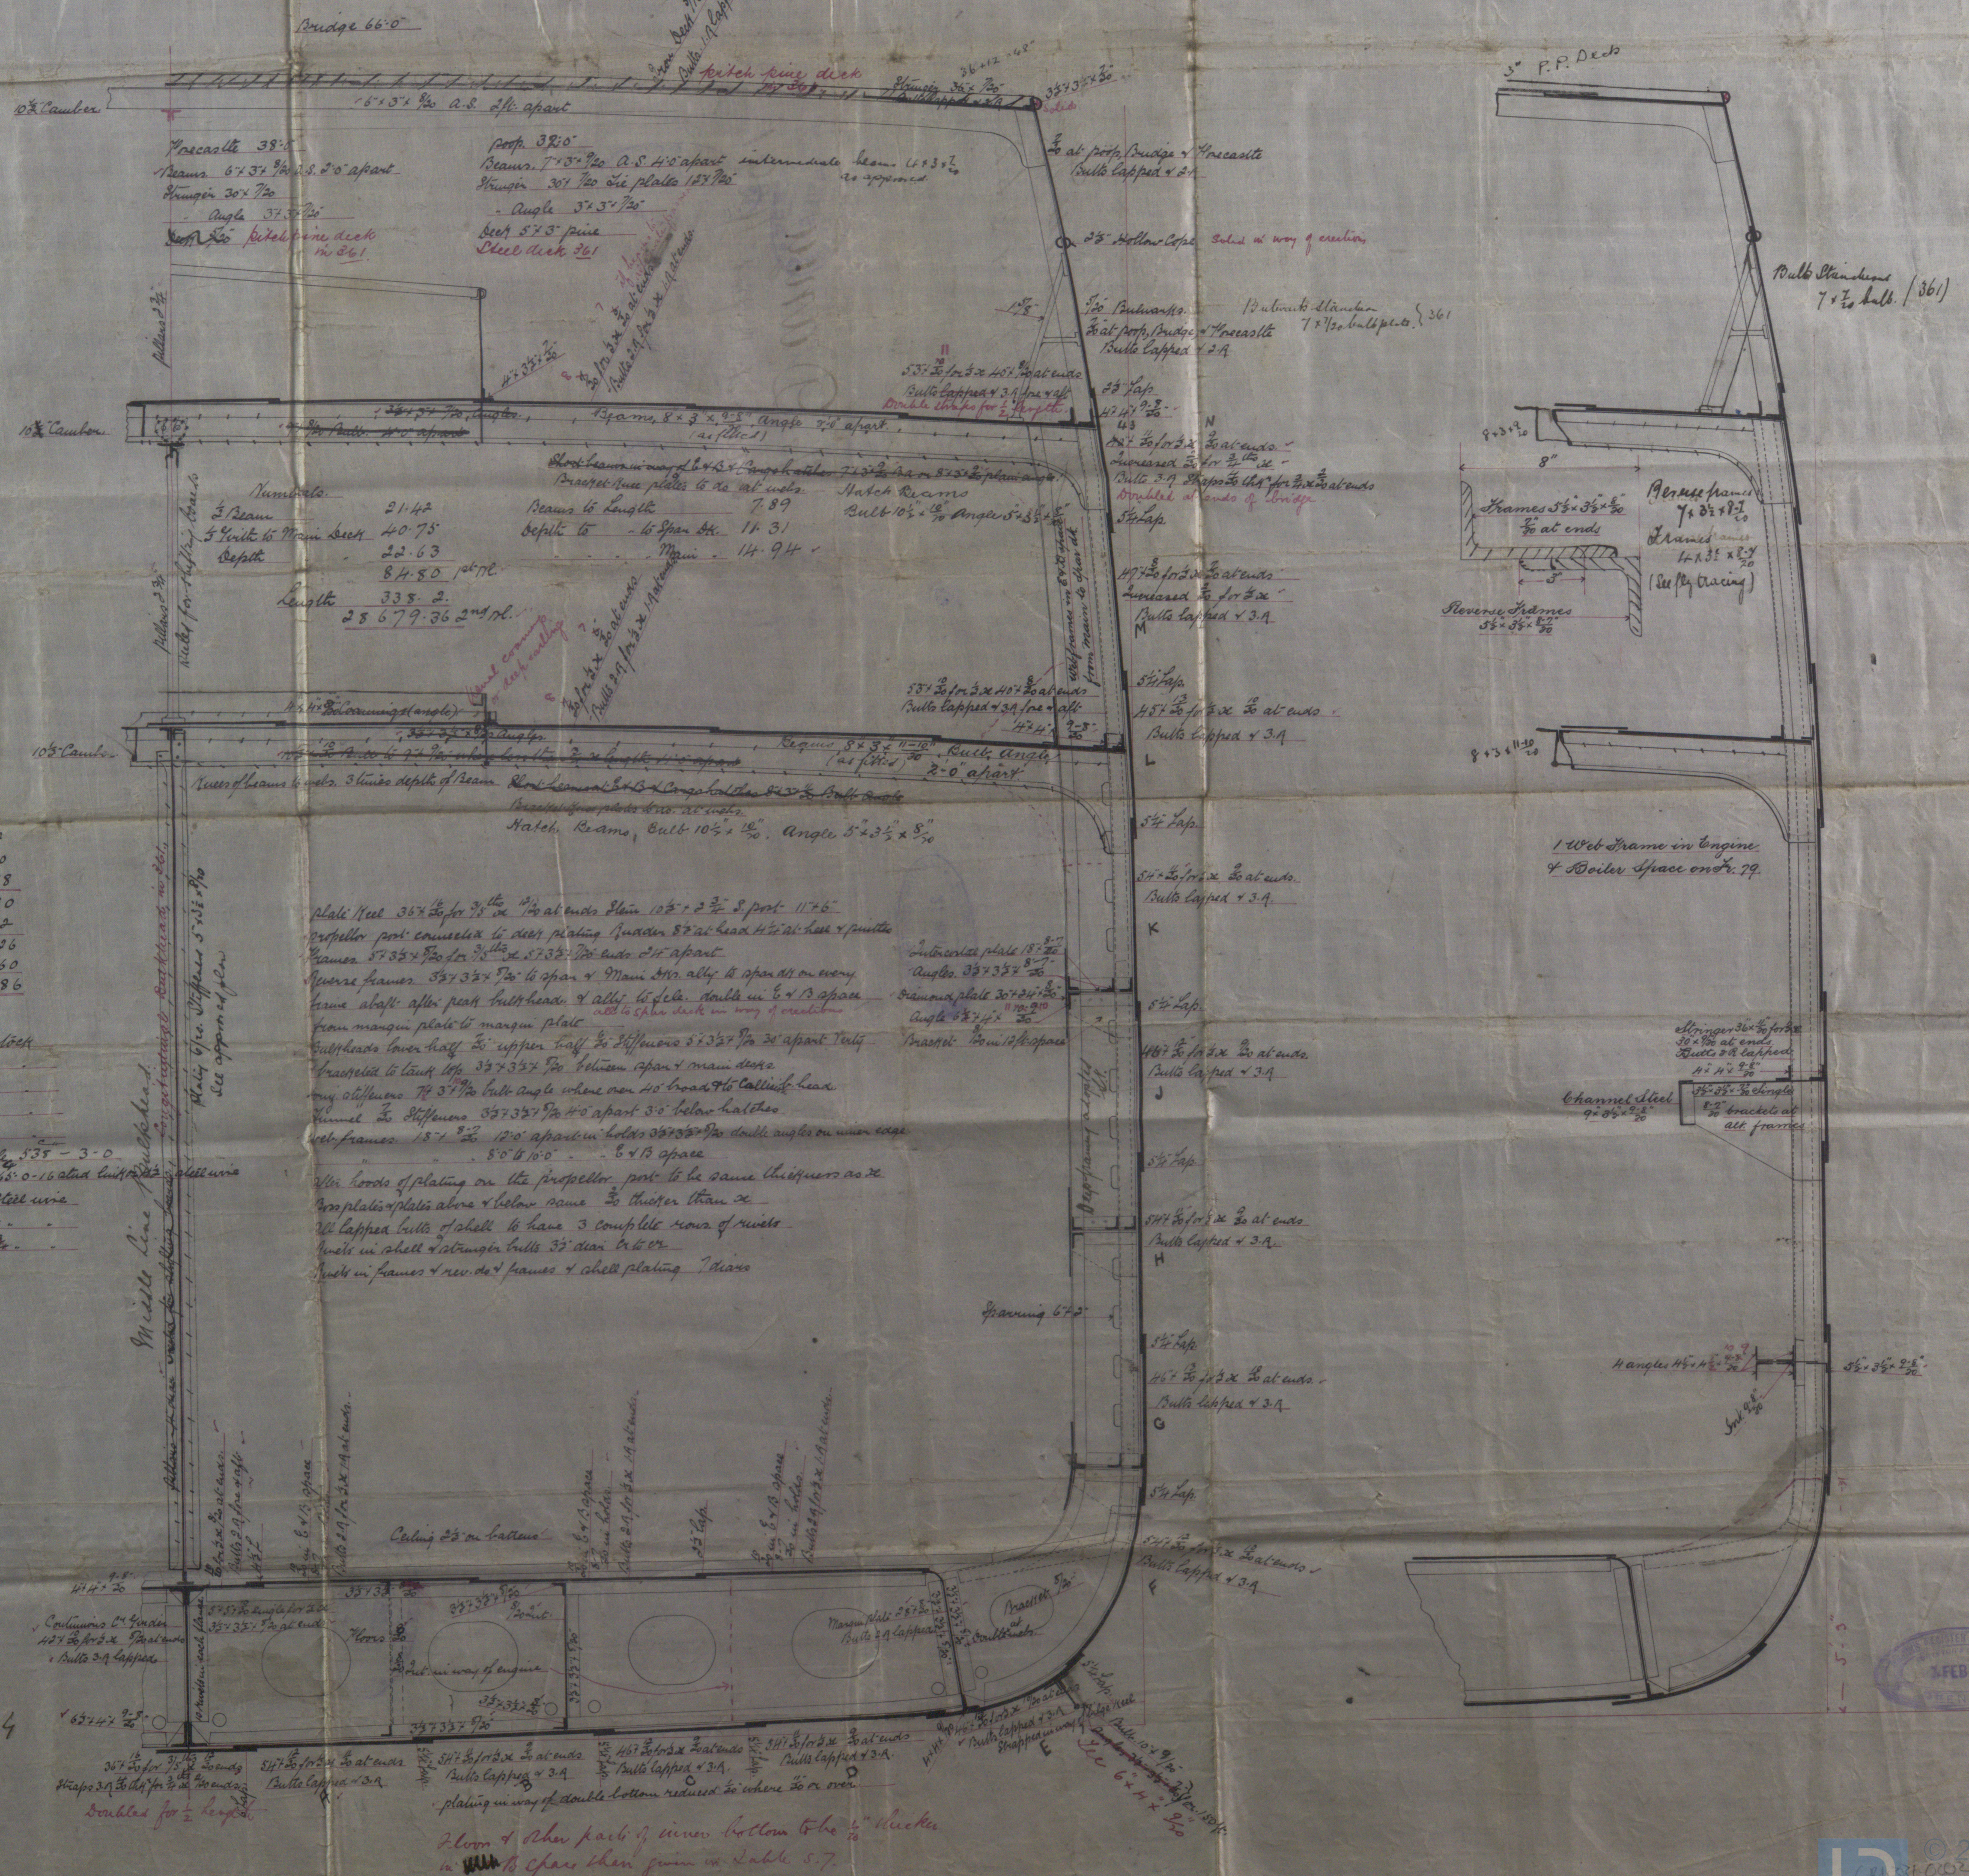


RECEIVED BY SURVEYOR  
FEB 94  
FRENCH



424331-0202

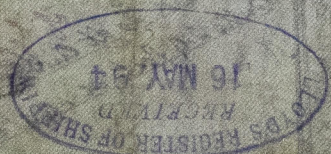

of Newcastle Report 11291

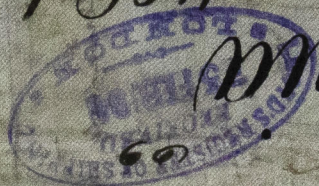

s/o Anna

Richardson

Nov. 361 9362

James. Funnell & Co



© 2020

Lloyd's Register  
Foundation