
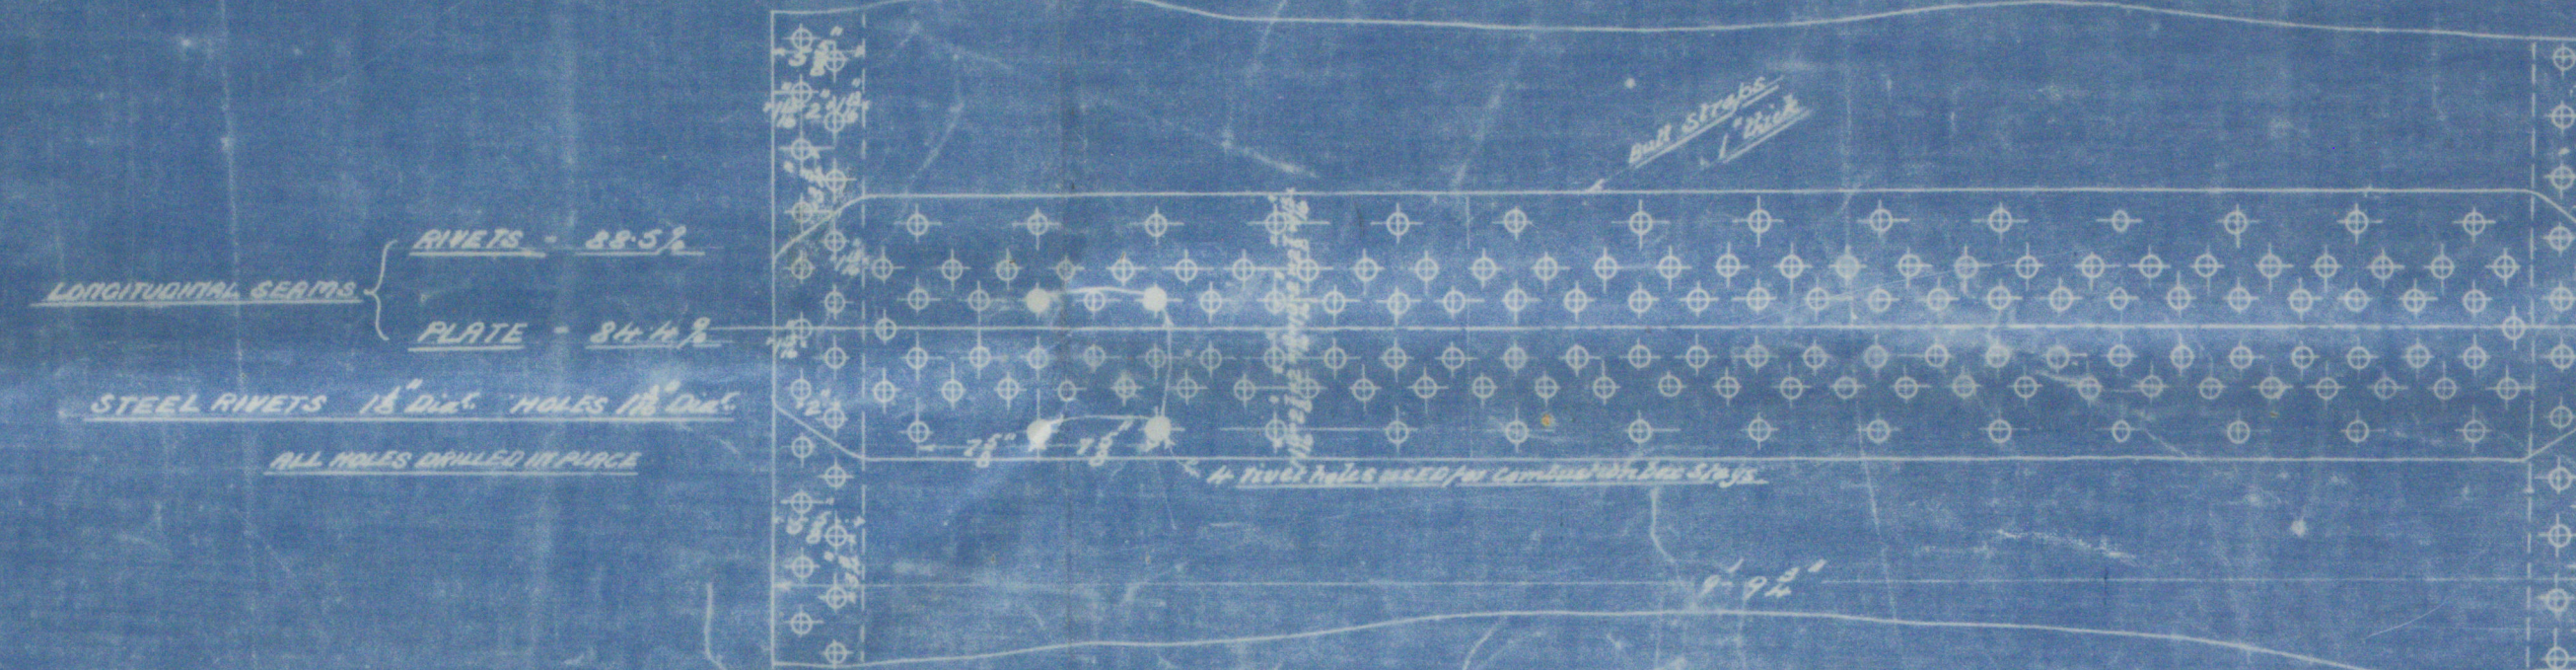
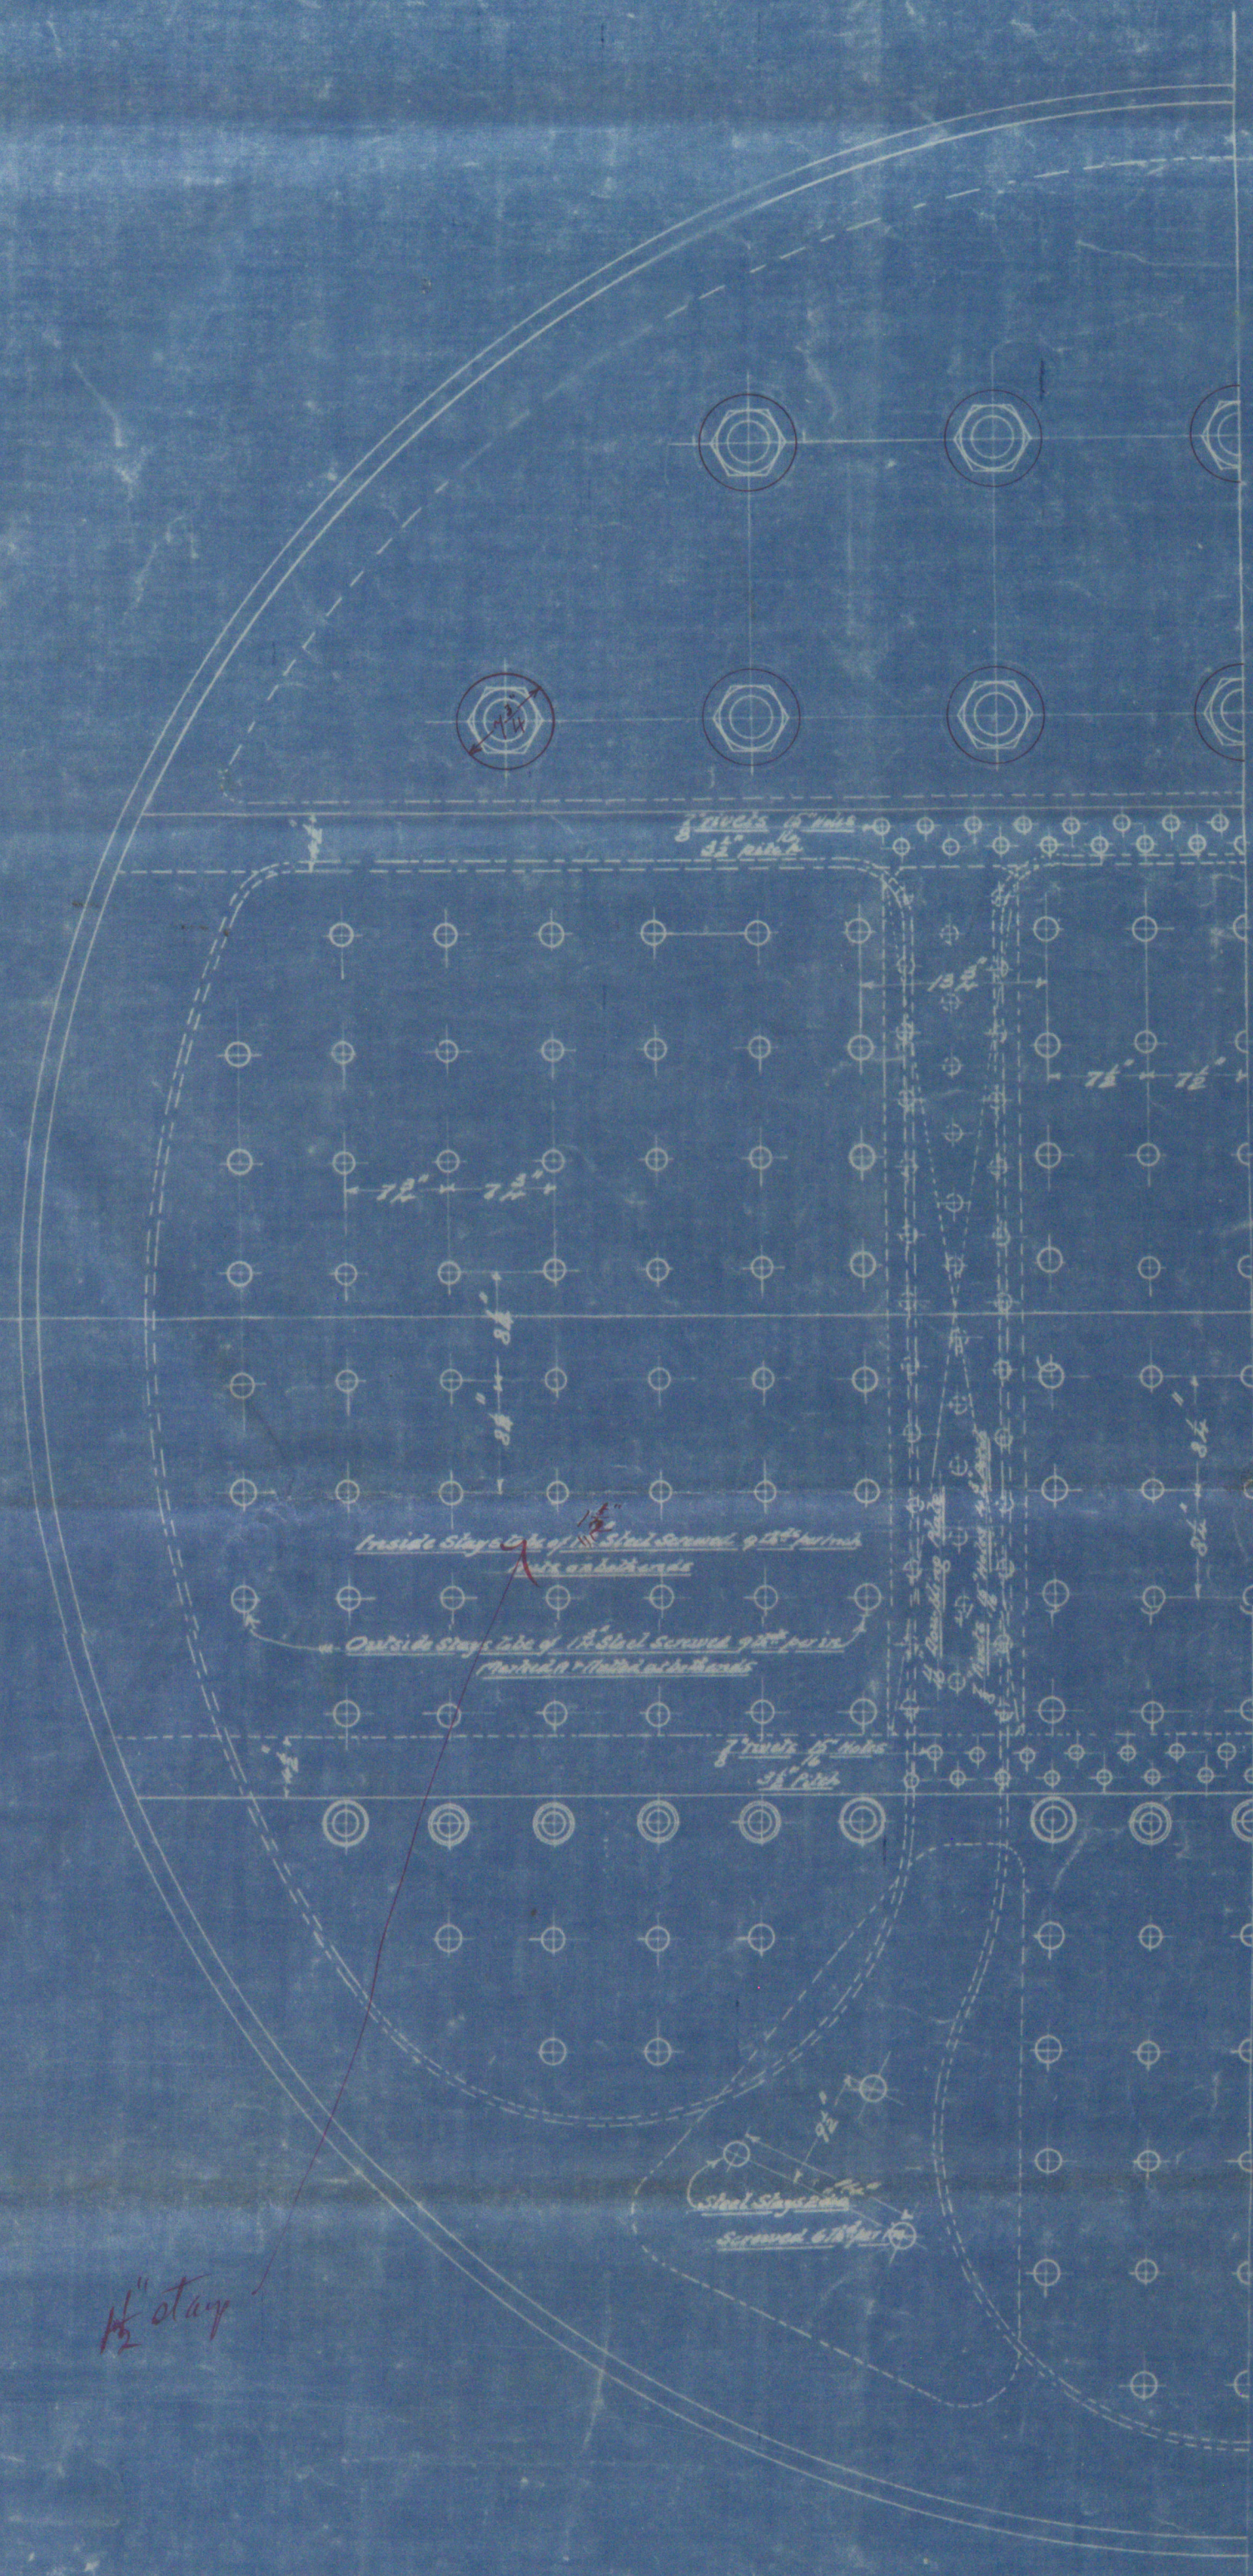
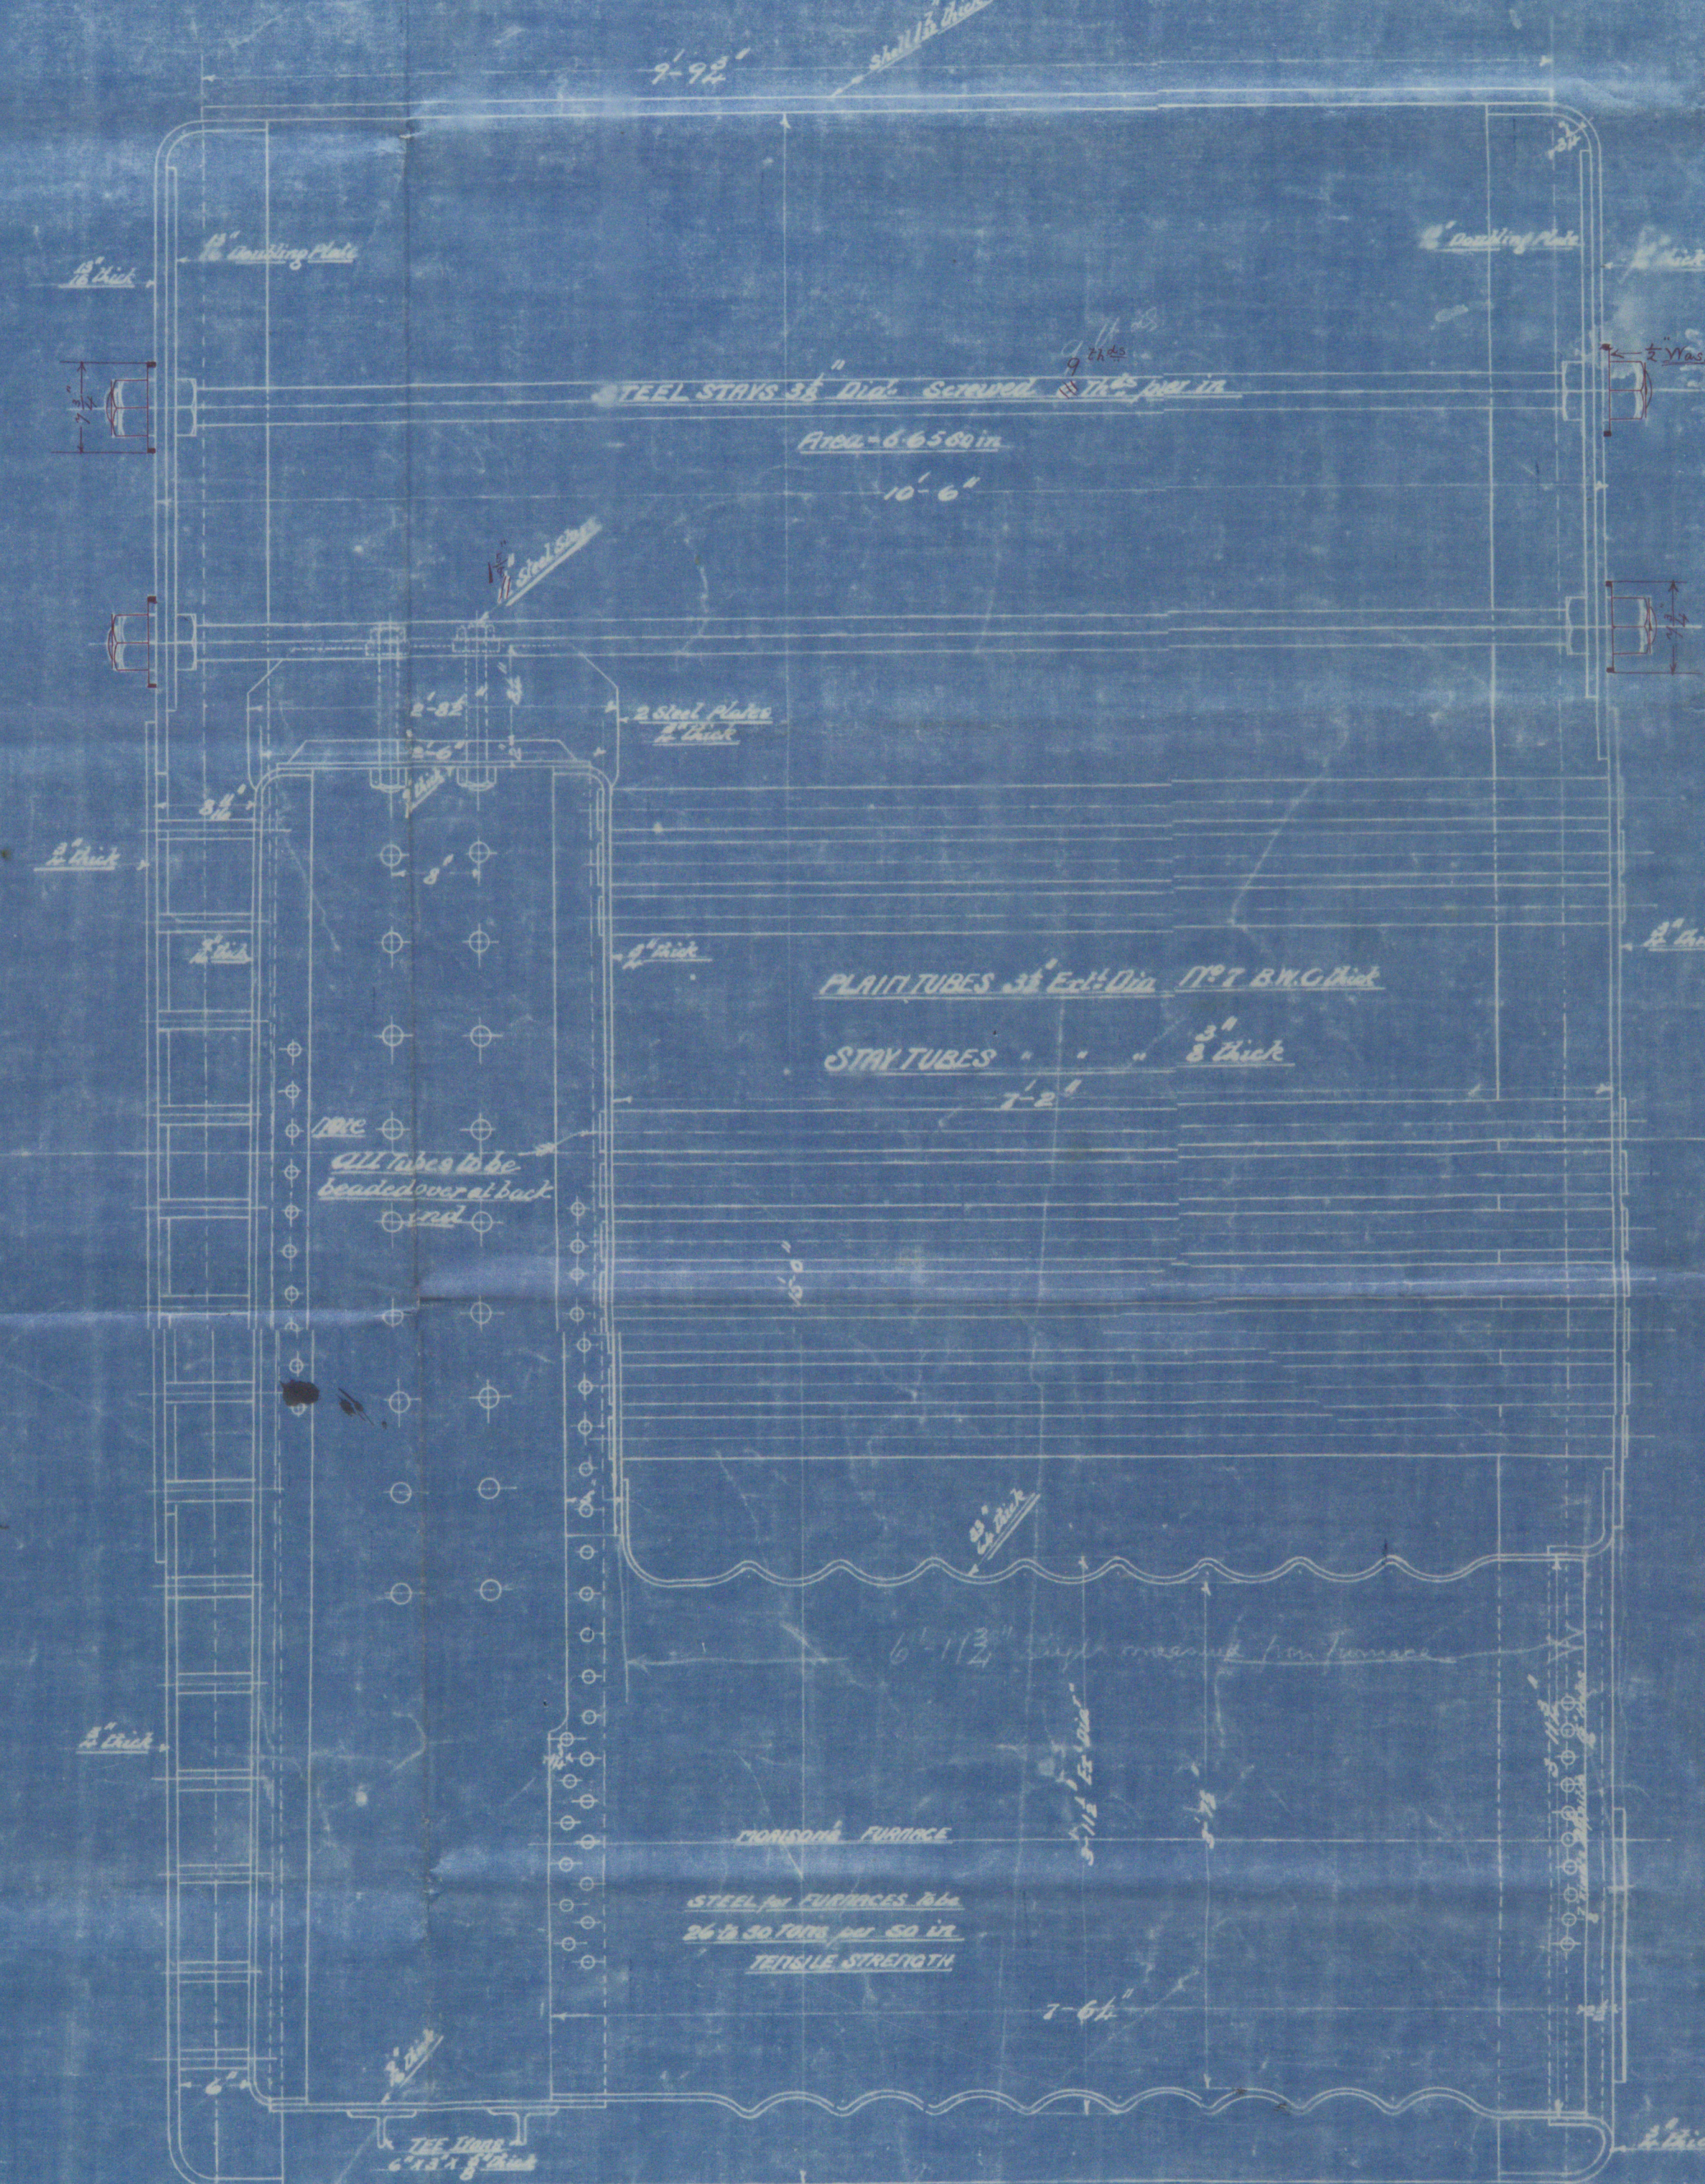


See Rpt. 24-12-94

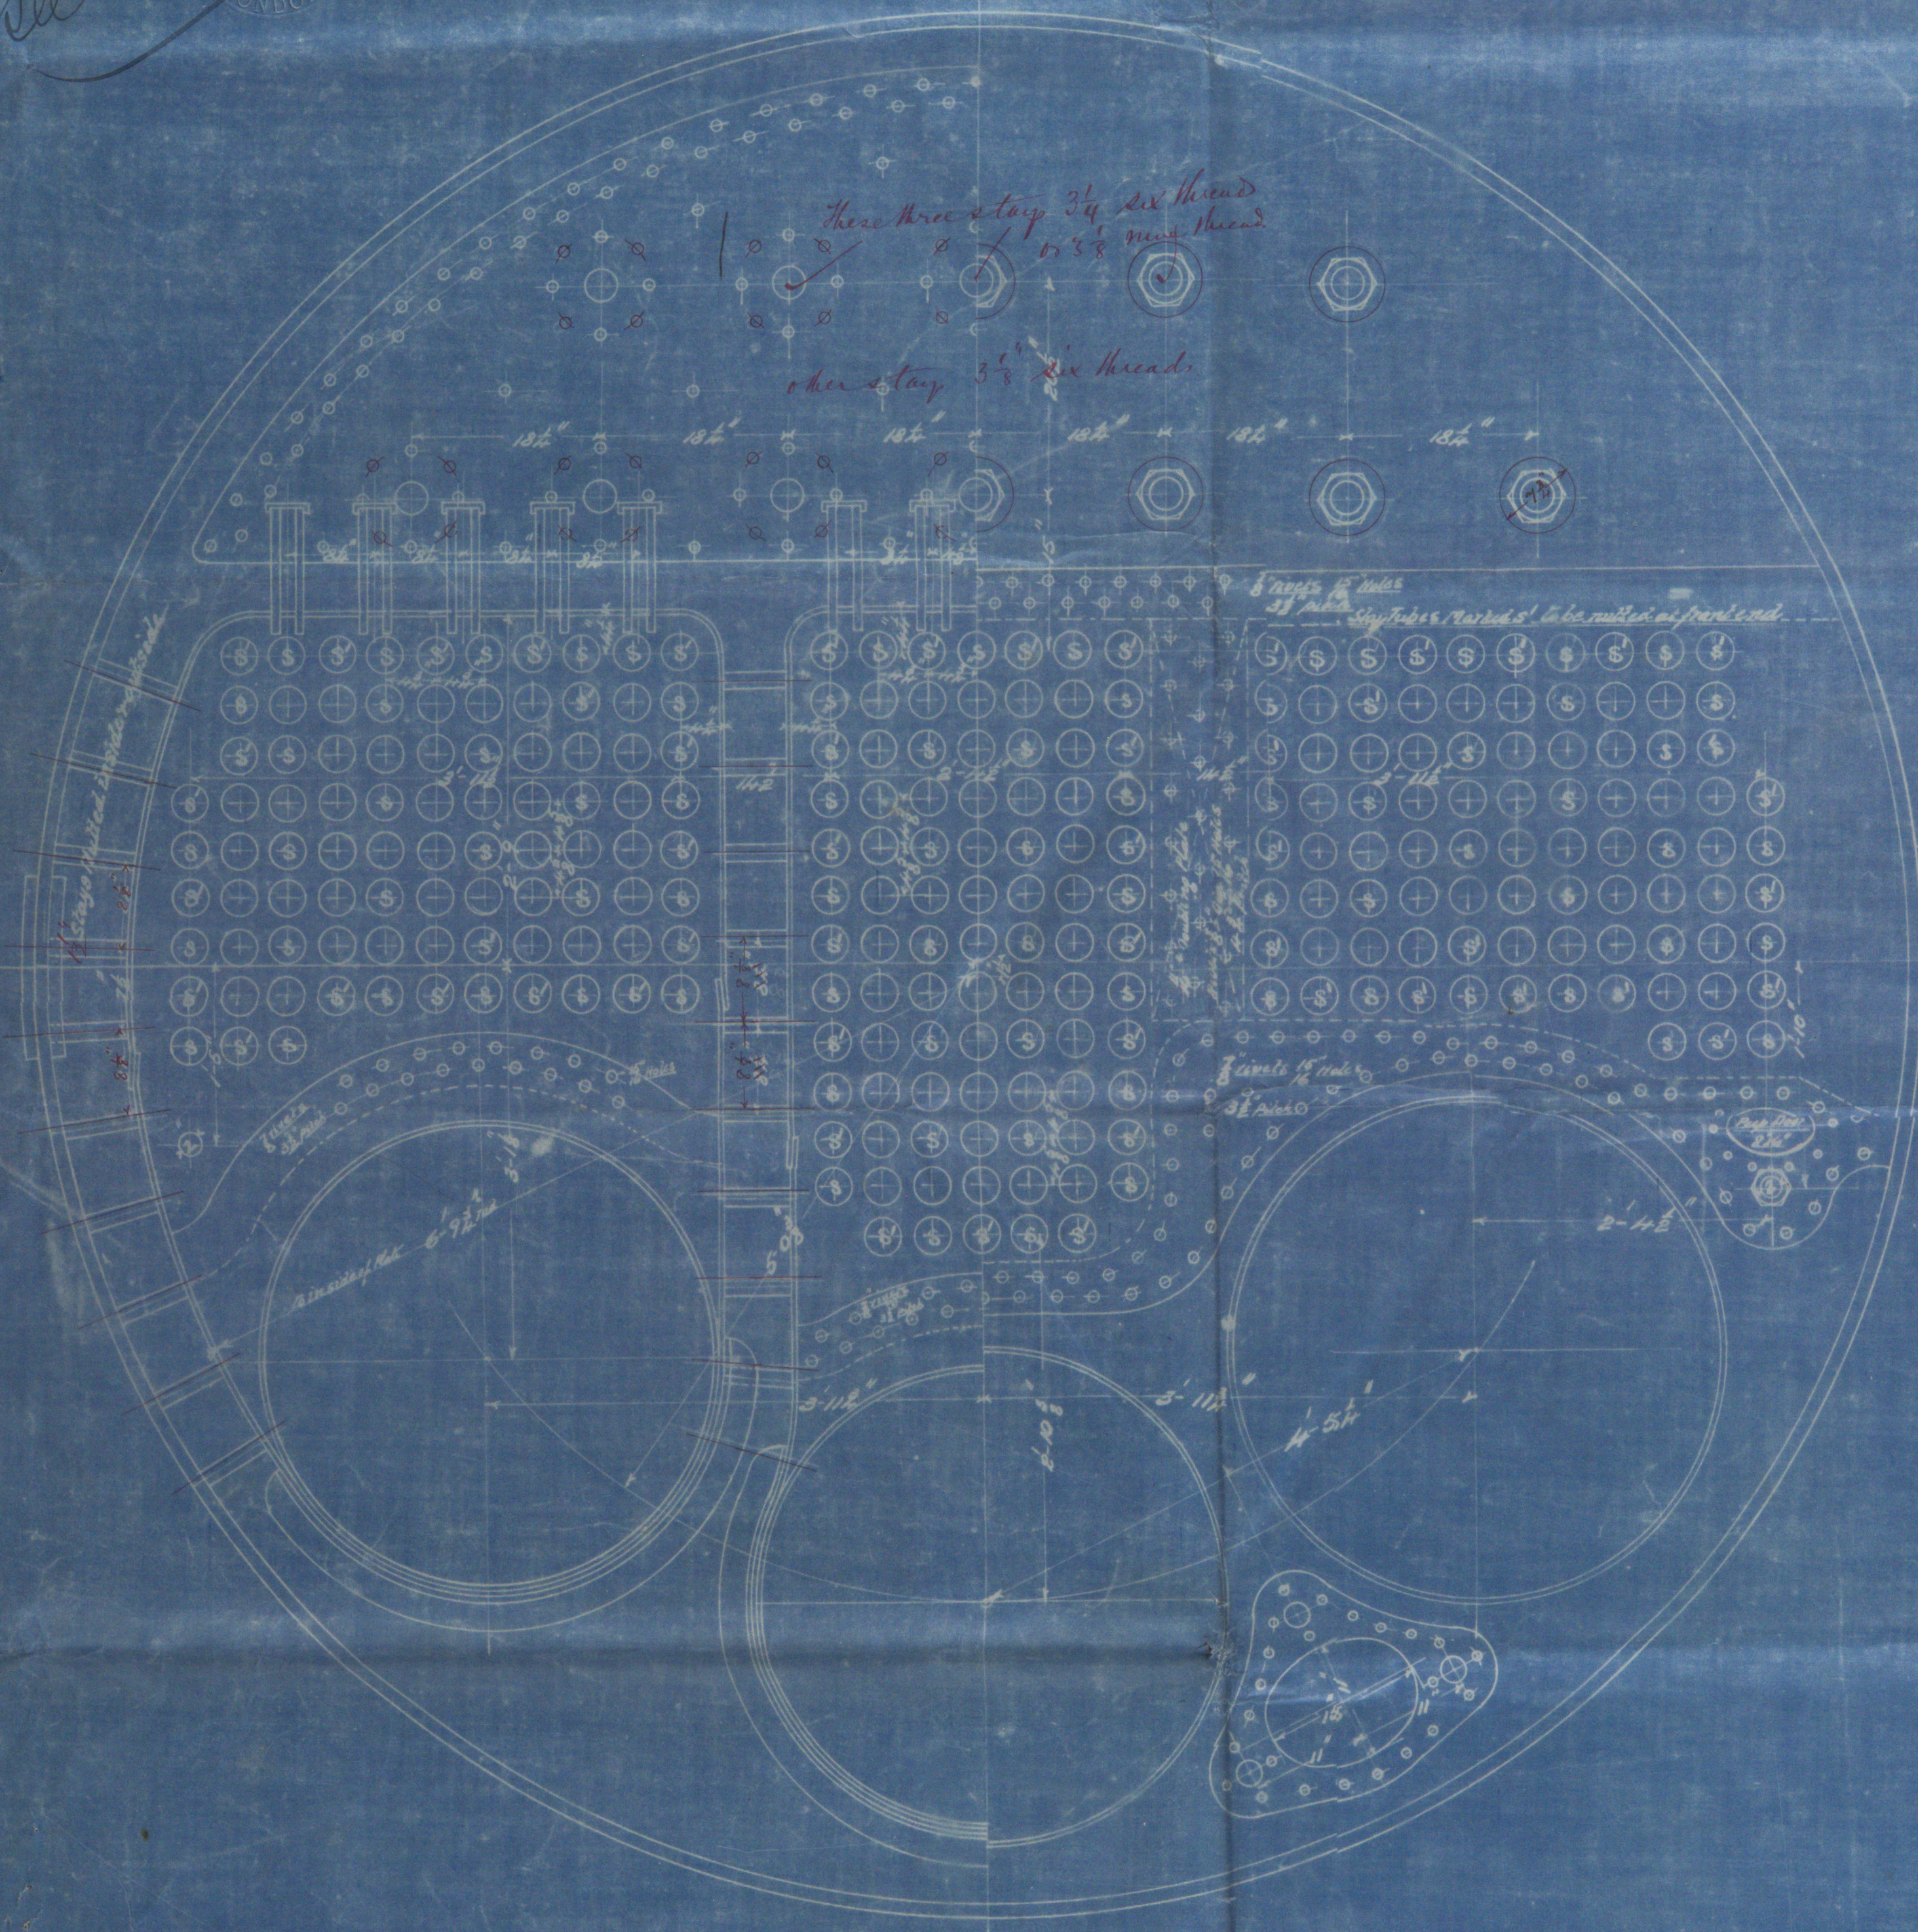

BOILERS Nos 195 & 196

15' 0" Int. Dia. 10' 6" Long

Working Press 165 lb. per sq. in.

Scales - One foot = 1/4" = 1/8"

M. J. Mason
21/12/94





© 2020

Lloyd's Register
Foundation