

Received at

Office, MON. 14 OCT 1895

Lloyd's Register of British and Foreign Shipping.

(Report on Vessel No. 11329 Port Greenock)

No. 4750 SHIP FORGINGS ~~OR CASTINGS~~.



The words FORGINGS or CASTINGS, IRON or STEEL, should be struck out as may be required.

I have to report that the undermentioned Iron or Steel Forgings or Castings
 manufactured by The Portland Forge Coy
 of Kilmarnock for the Vessel No. 371, being built
 by Messrs Russell & Coy of Port Glasgow
 have been inspected by me as set forth below, and found to be, so far as can be seen,
Sound & efficient


Mark on Forgings.

Lloyd's
 No. 4757
 W. H.

William Hamilton
Glasgow 21/2/95

	STERN FRAME.	RUDDER FRAME.	STEM.
Material*	Scrap iron		Scrap iron
How made	Forged		Forged
Dimensions	111+7		11+3
Progress on Inspection	Forging & smithing		Forging
Date when Inspected	30/11/94. 5. 10. 12. 14 19. 24/12/94. 7. 9. 12. 18 21. 29. 30/1/95. 7. 14. 21/2/95		27/11/94

SKETCHES OF FRAMES SHOWING POSITION AND DESCRIPTION OF WELDS OF FORGINGS, OR PARTICULARS OF TESTS APPLIED TO CASTINGS.

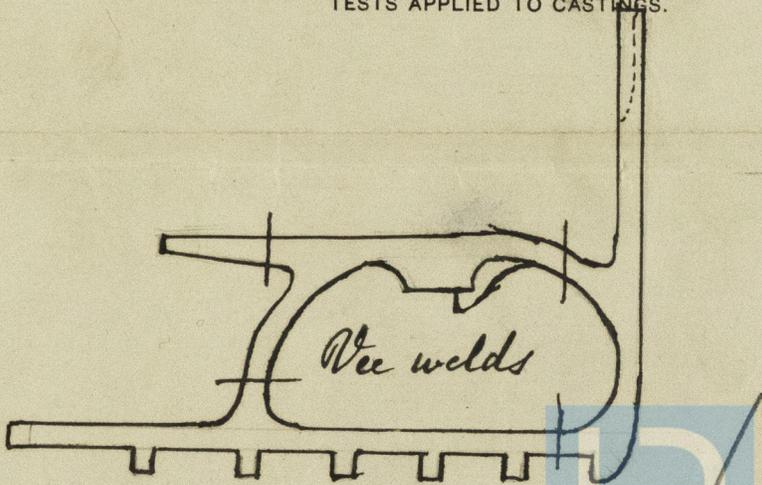

Fee (if any chargeable) £ : :

To be paid at

* If of Iron, state whether scrap or puddled Iron.