

Received at *Greenock* Office, *27th April 1894*

Lloyd's Register of British and Foreign Shipping.

(Report on Vessel No. *11378* Port *Greenock*.)

No. *2013* SHIP FORGINGS OR CASTINGS.

The words FORGINGS or CASTINGS, IRON or STEEL, should be struck out as may be required.

I have to report that the undermentioned Iron ~~or Steel~~ Forgings ~~or Castings~~,
manufactured by *The Farrow Forge & Co*
of *Farrow* (used for No. 382) for the Vessel No. *355*, being built
by *Messrs Russell & Co* of *Greenock*
have been inspected by me as set forth below, and found to be, so far as can be seen,
sound



Mark on Forgings.

Lloyd's
No. *3354B*
JG

John C Craig
Newcastle

	STERN FRAME.	RUDDER FRAME.	STEM.
Material*		<i>Scrap Iron</i>	
How made		<i>Forged</i>	
Dimensions		<i>6 1/4 - 3 1/4</i>	
Progress on Inspection		<i>Forged & Smithed</i>	
Date when Inspected		<i>February 5-8-20-23-28</i> <i>March 15-19-29</i>	

SKETCHES OF FRAMES SHOWING POSITION AND DESCRIPTION OF WELDS OF FORGINGS, OR PARTICULARS OF TESTS APPLIED TO CASTINGS.

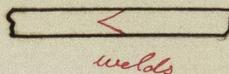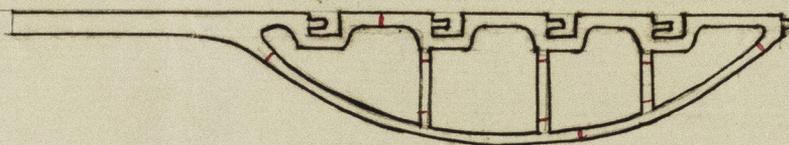

welds



© 2019

Lloyd's Register
Foundation

* If of Iron, state whether scrap or puddled Iron.

J. G. M.
3354 with 333-0012