


 No. 392. "Oakburn"

Rigging Plan

No. 382 & 383 & 392 being sister vessels to 356 & 370 -
 Scale 1/2 inch = one foot.
 Under Deck Tonnage 1537


LANDS OF FORE MAIN, MAIN MASTS, BOWSPRIT 1/2 AND 2/2 RIVETS.
 BUTTS OF MAST LAPPED 5/2 R BELOW DECK, 7/2 1/2 R ABOVE DECK. BUTTS OF
 BOWSPRIT LAPPED 5/2 R INSIDE KNUCKLEHEAD AND FROM BOWSPRIT CAP TO POINT
 LAPPED 7/2 1/2 R FROM KNUCKLEHEAD TO BOWSPRIT CAP. FORE AND MAIN
 MASTS 2 PLATES IN THE FOUND H ANGLE 3/2 1/2 R WHOLE LENGTH
 BOWSPRIT 2 PLATES IN THE FOUND H ANGLE 4/2 1/2 R TO BEYOND
 BOWSPRIT CAP. LANDS OF FORE AND MAIN TOPMASTS AND LOWER YARDS
 2 1/2 1/2 R RIVETS. LANDS OF FORE AND MAIN TOP GALLANT
 MASTS 2 1/2 1/2 R RIVETS. BUTTS OF TOPMASTS IN WAY OF
 TOPSAIL YARDS STRAPPED, STRAPS 1 1/2 IN AND 3/4 THICKER
 THAN THE PLATES THEY CONNECT. REMAINDER LAPPED
 7/2 1/2 R.
 2 ANGLES IN TOPMAST 4/2 1/2 R WHOLE LENGTH
 LANDS OF OTHER YARDS 2 1/2 1/2 R RIVETS BUTTS
 OF OTHER YARDS 7/2 1/2 R

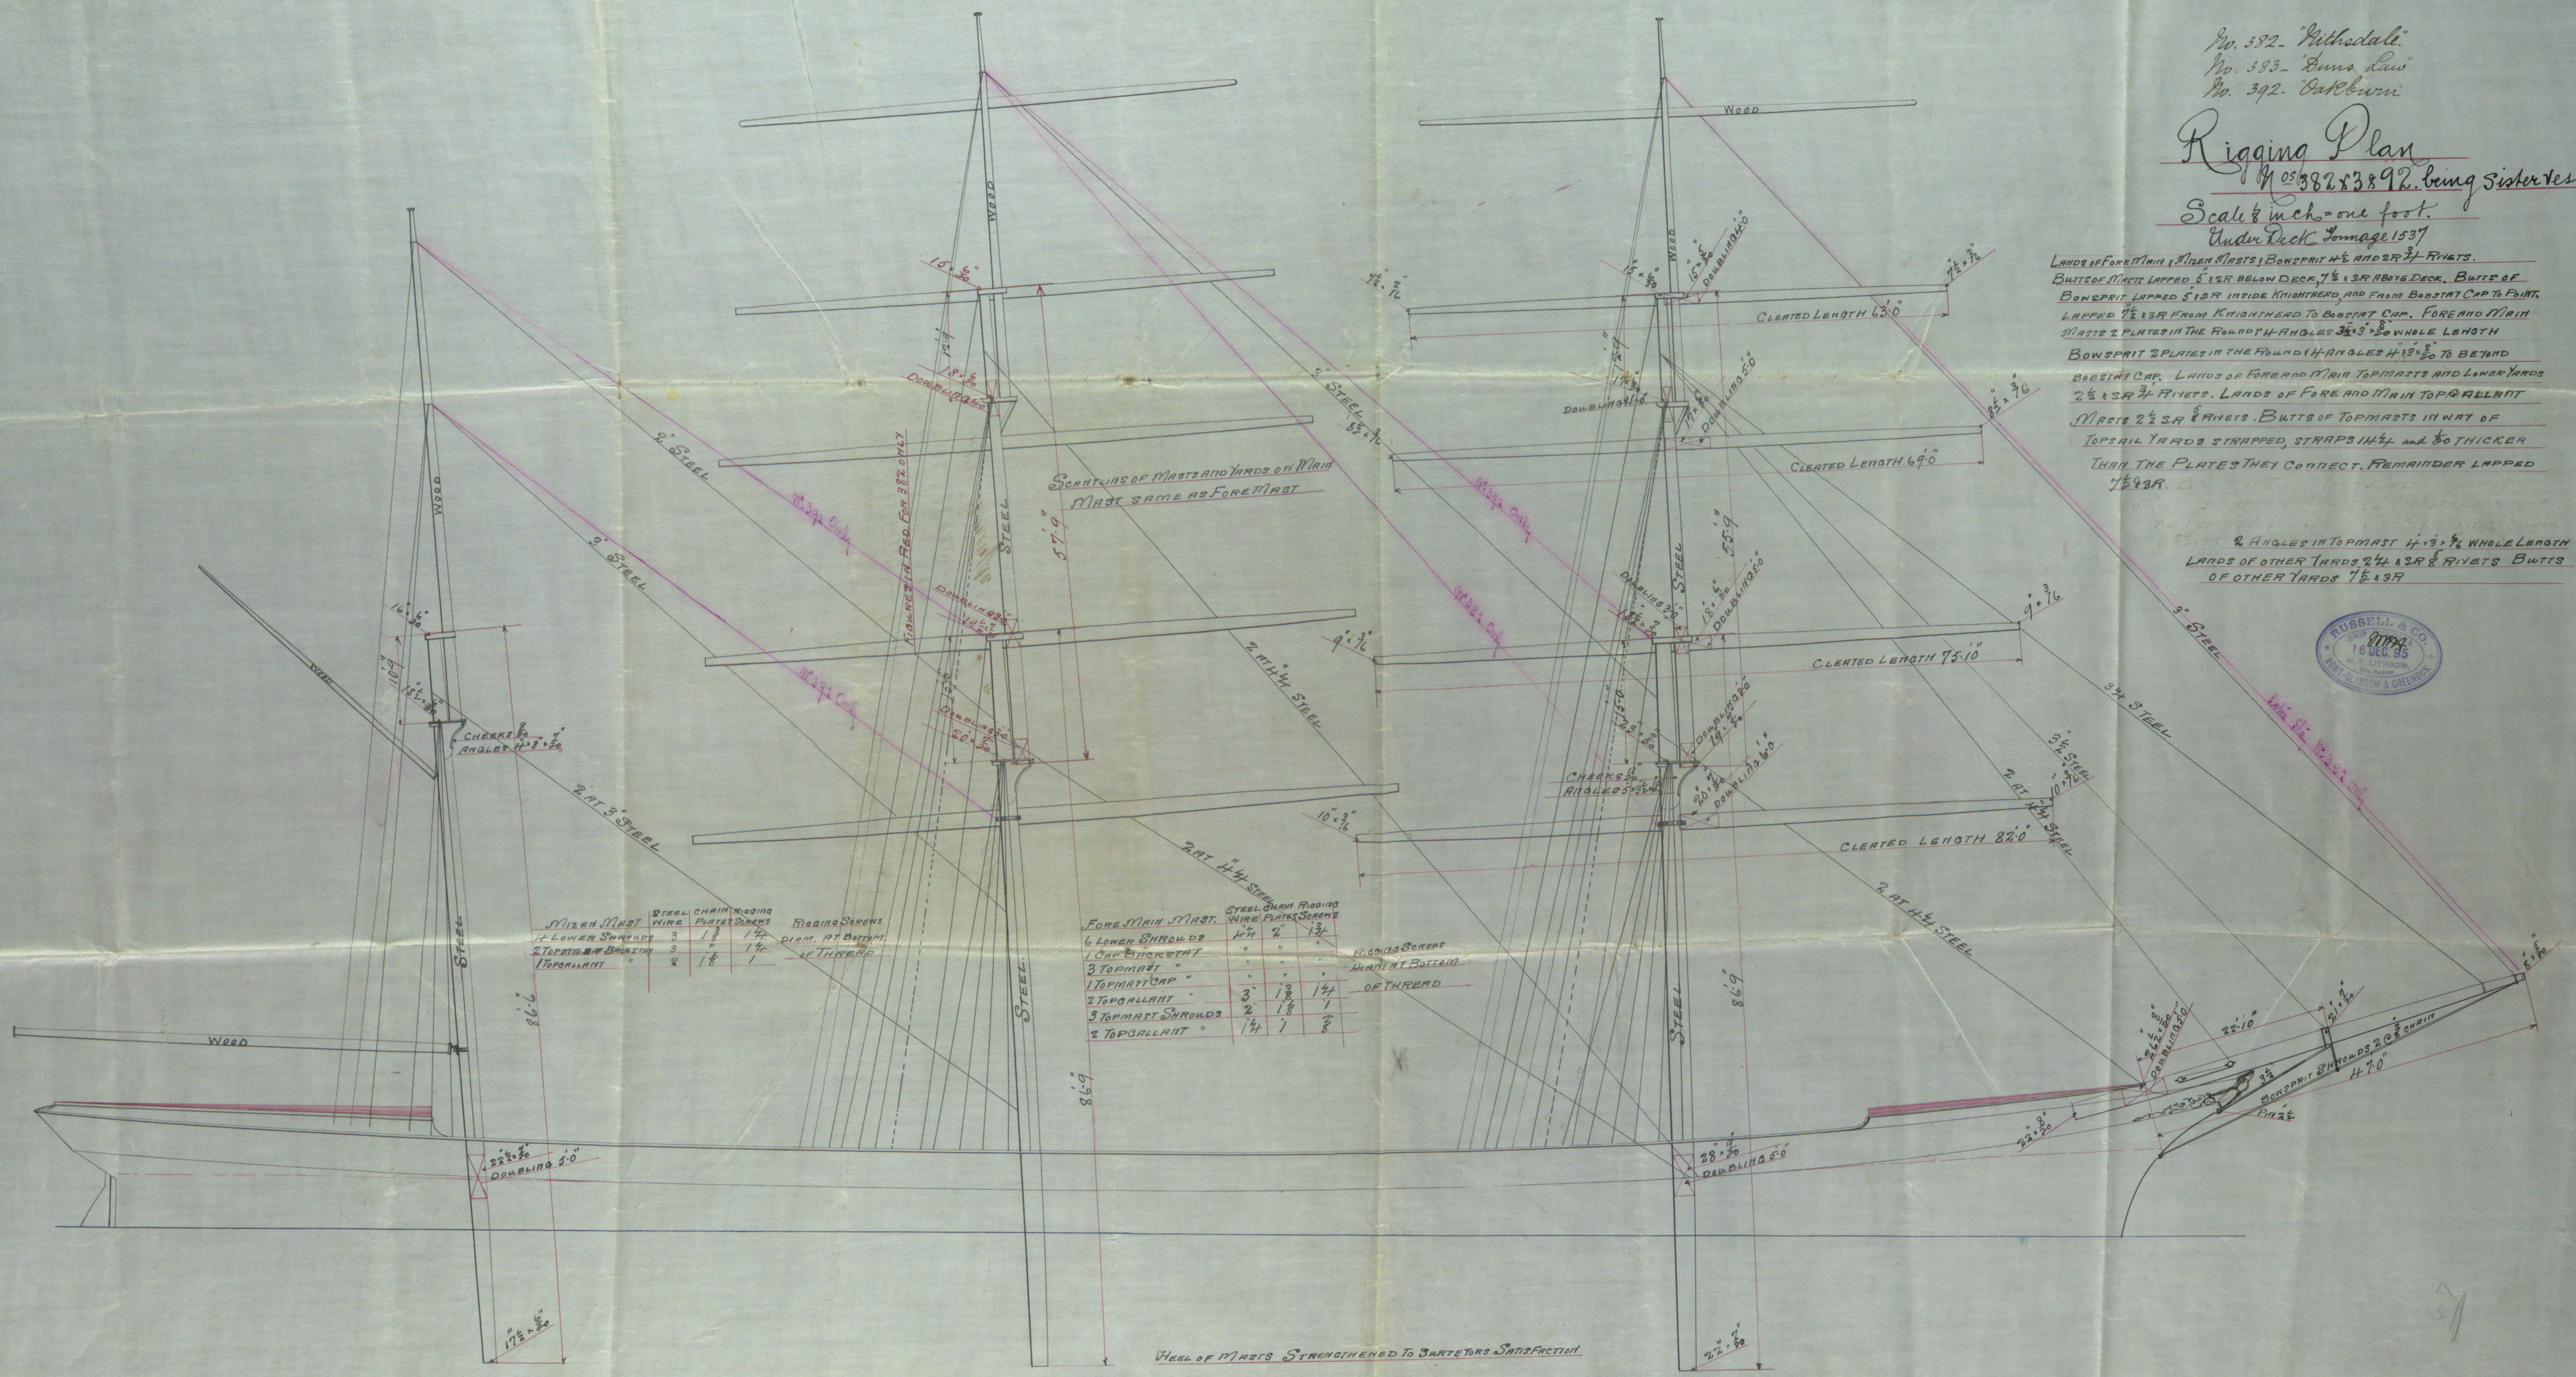



no. 382. "Nitarale" Greenock Report no. 11378.
 " 383 "Duns kow" " " 11594
 " 392 "Dankarn" " " 11655
 " 417 "Imerejide" " " 12048

GRH333-0047



© 2020

Lloyd's Register
Foundation