
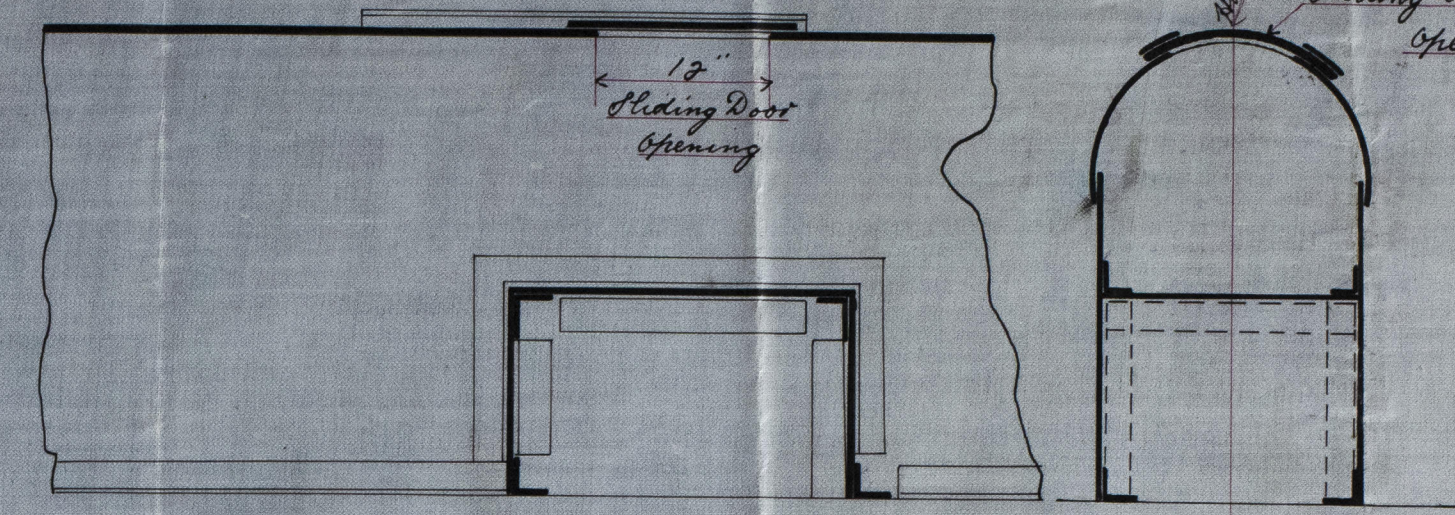


Means of access should be provided at couplings as well as at bearings
J.M. 24/10/95

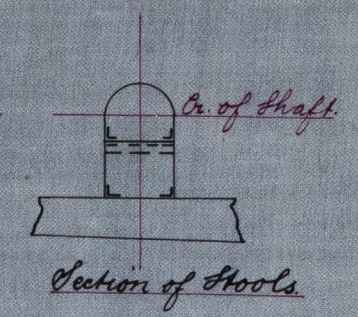

Section of Stools - 1" Scale

Shaft Casing J.S.S. No. 38798

Scale 1/2" = 1 foot.

No. 388 - "Laurp Sodré"
4 mensur Report No. 11292
No. 389 - "Prudente de Moraes"



Shaft Casen's
 Russell & Co
 No. 387 78




GRH553-6672



© 2019

Lloyd's Register
 Foundation

GRH553-6672