


Shell of boiler from The West Hartlepool Steel Co. & Furnace Steel  
 Tubes & Pipe from John Spencer & Sons, Glasgow  
 Firebricks from Glasgow  
 Notes in connection of Long's seam of shell drilled in position  
 All other holes punched to size & drilled to size in position  
 Plates annealed after punching & before bending

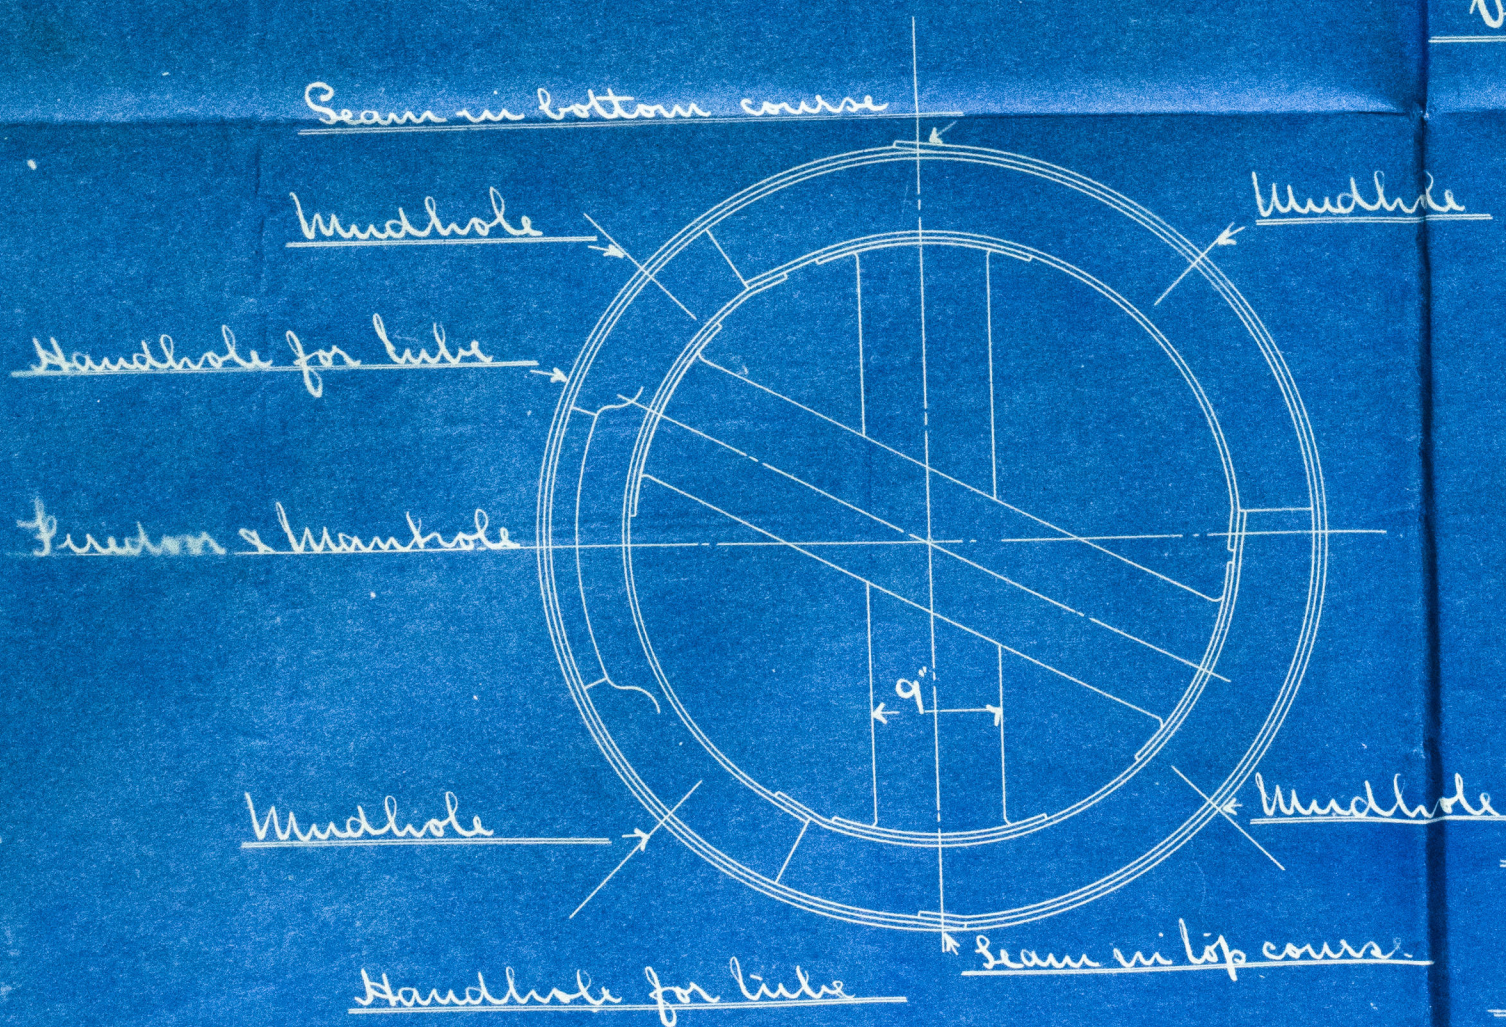

Bales No 24256  
 Vertical Boiler 9-0 x 4-6 dia

for Messrs Kincaid & Co. E 246

Working pressure 80 lbs. per sq. inch

Testing pressure 160 lbs. per sq. inch

Scale 1" = 1 foot

Lloyd's Survey



Long seams of shell double riveted 11/16 holes 3/4 pitch 3/8 lap 1 1/16 dia.

Circum seams of shell single riveted 11/16 holes 3/4 pitch 2 1/8 lap

Fuelbox seams single riveted 7/8 holes 2 1/8 pitch 2 5/8 lap



24256

$\frac{19}{26}$

No 4724  
Lloyd's List  
16000  
C.H.H. 11-12-95

"Lloyd's List" & Remembrance Report No. 11392

CPH333-0073

Baker's 24256



© 2019

Lloyd's Register  
Foundation