

# Lloyd's Register of British and Foreign Shipping.

(Report on Vessel No. 11292, Port Greenock)  
as "Hansa Lodge"

No. 5041 SHIP FORGINGS ~~OR CASTINGS.~~

The words FORGINGS or CASTINGS, IRON or STEEL, should be struck out as may be required.

I have to report that the undermentioned Iron ~~or Steel~~ Forgings ~~or Castings~~,  
manufactured by Messrs. Russell & Co.  
of Port-Glasgow for the Vessel No. 388, being built  
by Messrs. Russell & Co. of Port-Glasgow.  
have been inspected by me as set forth below, and found to be, so far as can be seen,  
Sound.

Forged by Messrs. Hunt & Sons of Irvine, smithed  
& finished by Messrs. Russell & Co. of Port-Glasgow.


Mark on Forgings.

Lloyd's  
No. 4051  
F.C

Frank Cook.  
Glasgow 4/12/95

	STERN FRAME.	RUDDER FRAME.	STEM.
Material* ...	<u>Scrap Iron</u>	<u>Scrap Iron</u>	<u>Scrap Iron</u>
How made ...	<u>Forged.</u>	<u>Forged.</u>	<u>Roller.</u>
Dimensions ...	<u>6x5 1/4</u>	<u>4 3/4 to 3x2 3/4</u>	<u>6x1 1/4</u>
Progress on Inspection	<u>Forged &amp; smithed</u>	<u>Forged &amp; smithed.</u>	<u>smithed.</u>
Date when Inspected	<u>28/9/95</u>	<u>11/10/95 to 27/11/95.</u>	<u>25/9/95</u>

SKETCHES OF FRAMES SHOWING POSITION AND DESCRIPTION OF WELDS OF FORGINGS, OR PARTICULARS OF TESTS APPLIED TO CASTINGS.

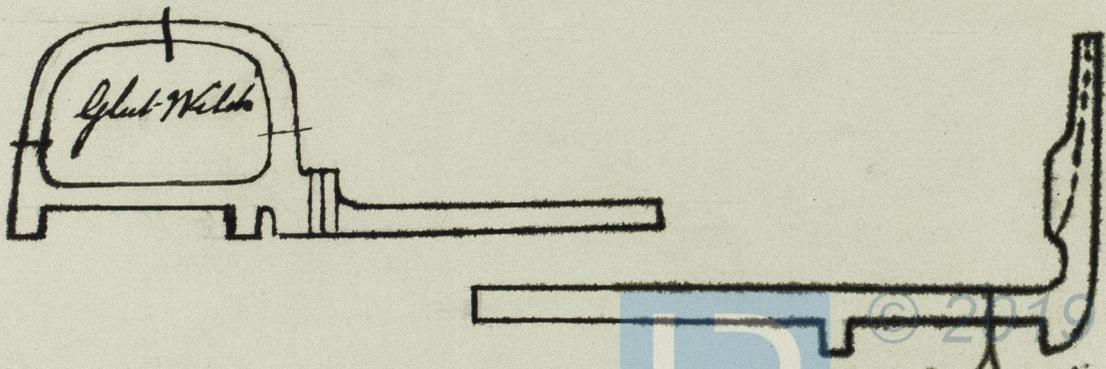

Fee (if any chargeable) £

To be paid at

Glenkiln

\* If of Iron, state whether scrap or puddled Iron.