




20. 8. 95
11. 10. 95
18. 10. 95

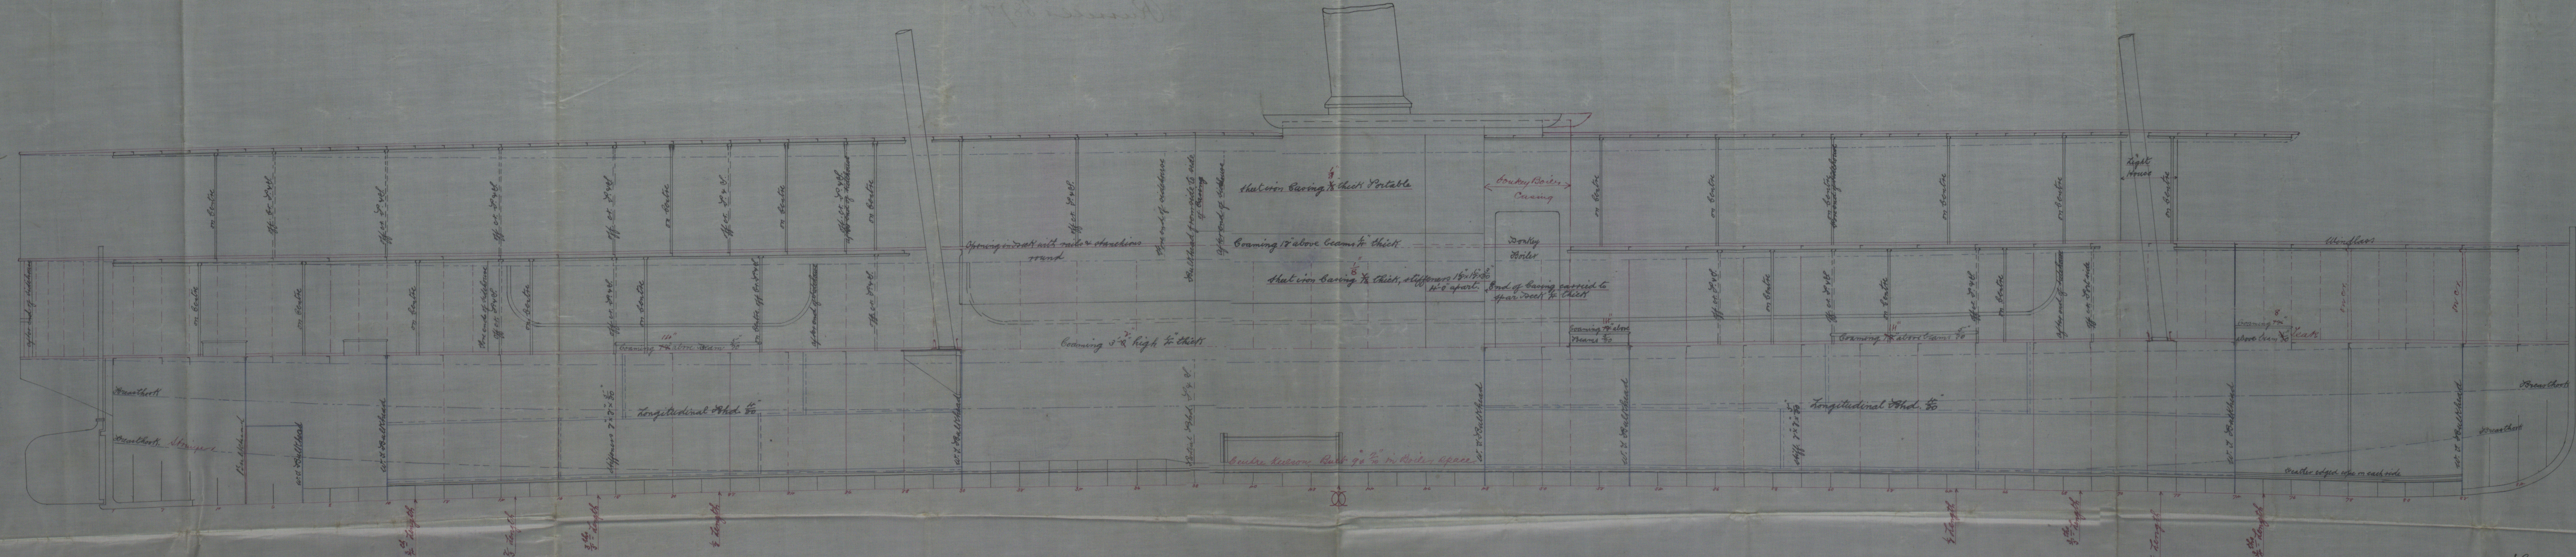

No. 388. "Lauro Sodré"
Jensen. Report No. 1198.
No. 509. Trudens de Flouzel.

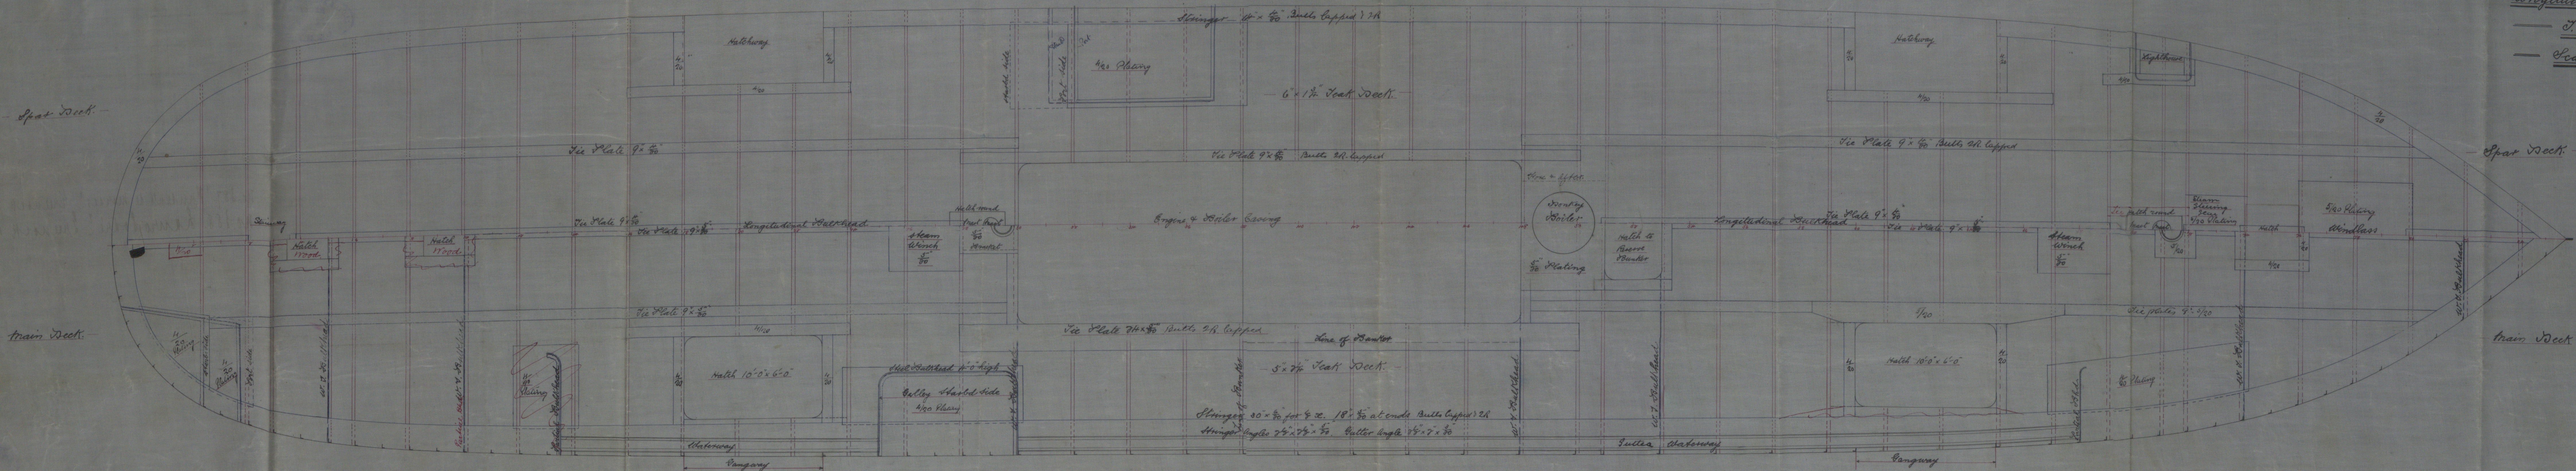



Longitudinal & Deck Plans
J. S. P. No. 387+8
Scale 1 inch = 1 foot.

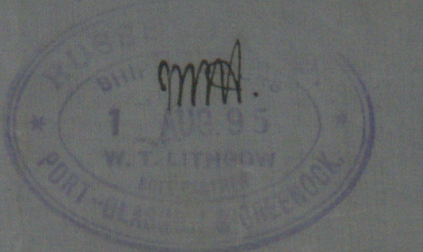

Longitudinal Plans

Russell's 387 & 8

GRH333-0080

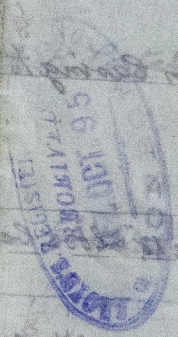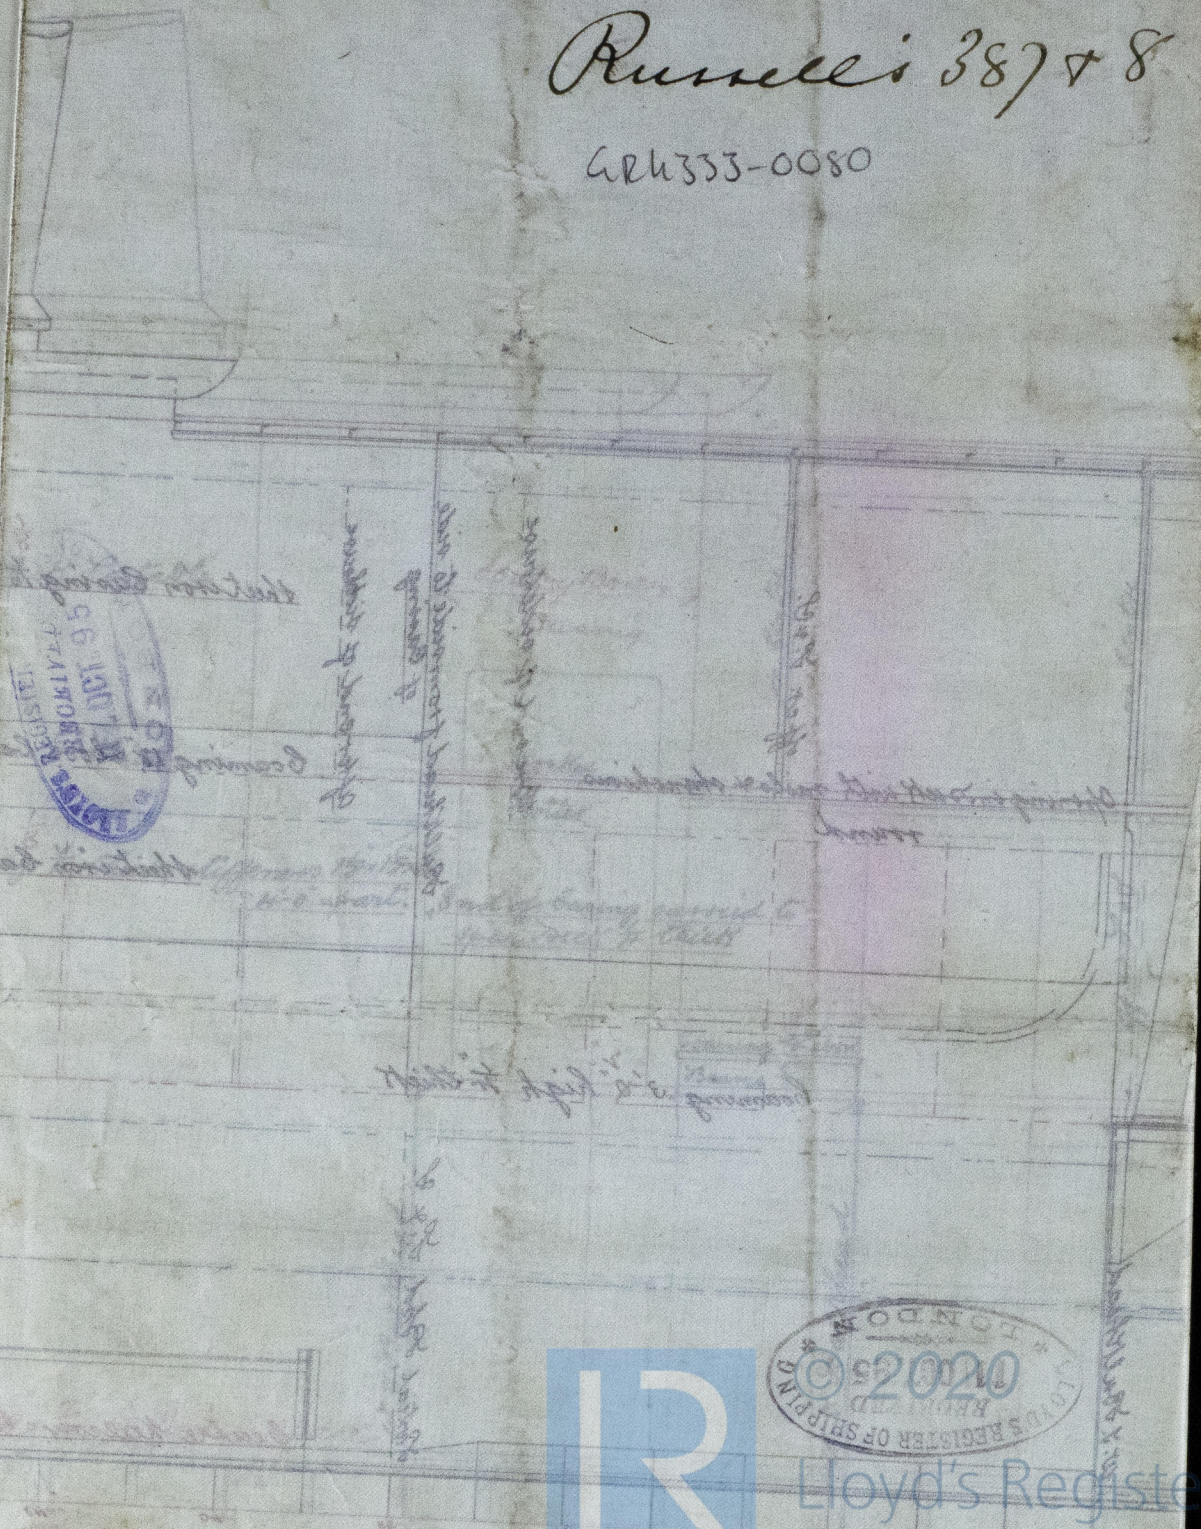

Lloyd's Register
Foundation