


Recd. 30.9.95
 16.1.96

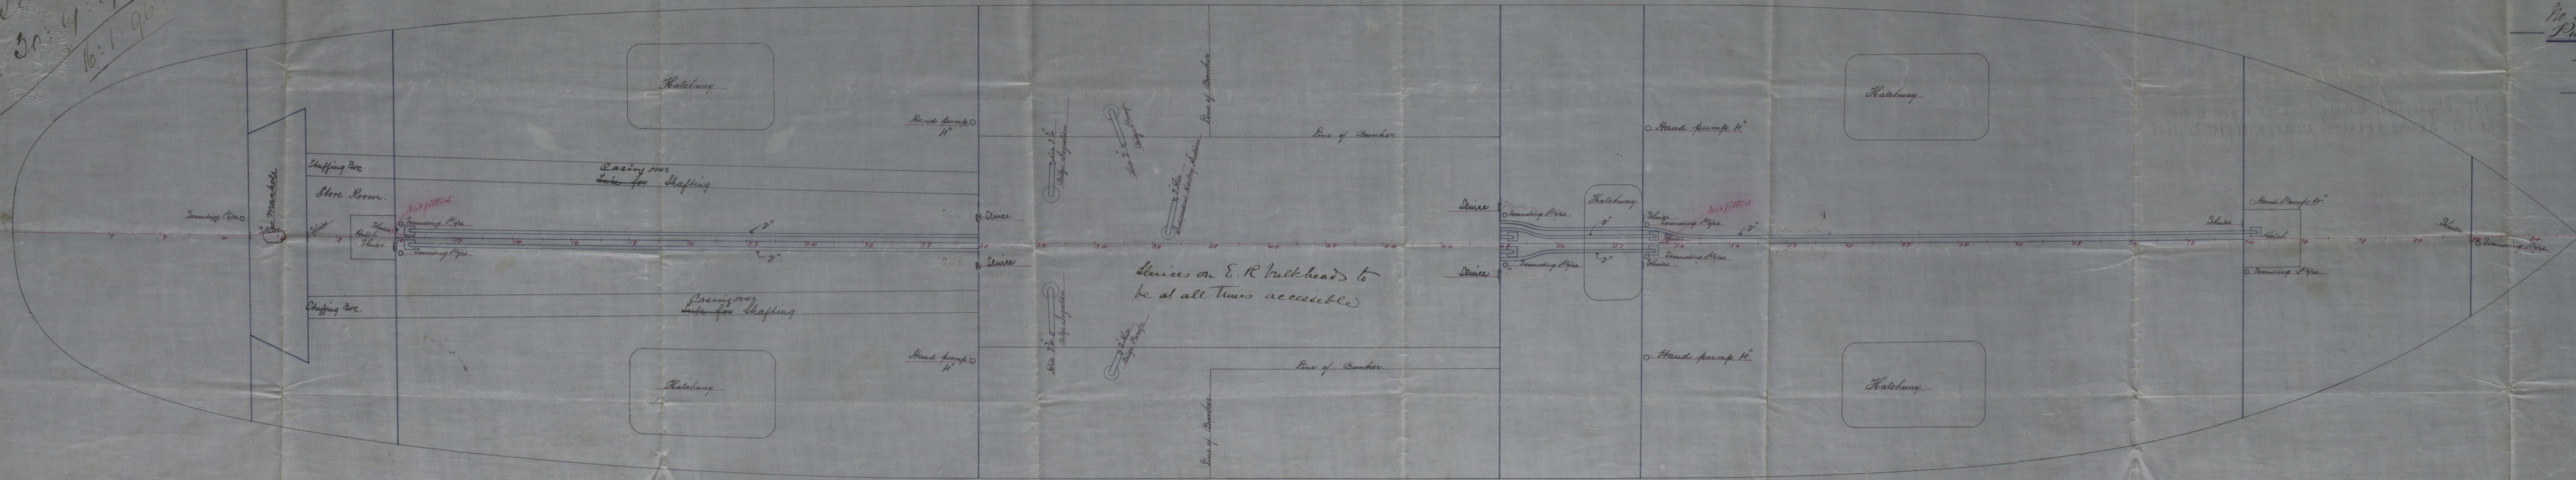

No. 388- "Lauro Sodre" - 8 gunner
 No. 389- "Fudende de Moraes"
Pumping Arrangement
 387
 T.S.S. N° 388
 Scale 1/2 inch = 1 Foot.
 W.D. Tonnage about 510 Tons.



JFM
 28/9/95

No. 387. *Memorie de Mr. de L'Enseigne* Report No. 11411.
No. 388 - *Lauro Sodre - & L'Enseigne* Report No. 11292

GR 6335-0082



© 2020

Lloyd's Register
Foundation