

Lloyd's Register of British and Foreign Shipping.

(Report on Vessel No. 11397 Port Greenock
Hand sound of hull.)

No. 5017 SHIP FORGINGS OR CASTINGS.

I have to report that the undermentioned Iron or Steel Forgings or Castings, manufactured by The Harbour Forge Co of Irvine for the Vessel No. 385, being built by Mess Russell & Co of Port Glasgow have been inspected by me as set forth below, and found to be, so far as can be seen, Sound & efficient

The words FORGINGS or CASTINGS, IRON or STEEL, should be struck out as may be required.


Mark on Forgings.

Lloyd's
No. 5017
W.H.

William Hamilton
Glasgow
24/8/95

	STERN FRAME.	RUDDER FRAME.	STEM.
Material*	<u>Scrap iron</u>		
How made	<u>Forged</u>		
Dimensions	<u>7 1/2 x 2 3/8</u>		
Progress on Inspection	<u>Forging & smithing</u>		
Date when Inspected	<u>29/7/95 to 23/8/95</u>		

SKETCHES OF FRAMES SHOWING POSITION AND DESCRIPTION OF WELDS OF FORGINGS, OR PARTICULARS OF TESTS APPLIED TO CASTINGS.

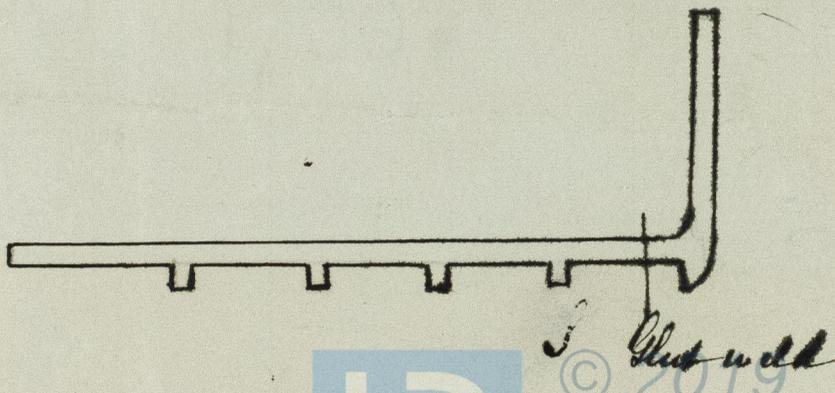

Fee (if any chargeable) £ : : ✓

To be paid at _____

* If of Iron, state whether scrap or puddled Iron.

