

Lloyd's Register of British and Foreign Shipping.

(Report on Vessel No. 11297 Port Glasgow
Harbour of London)No. 5017 SHIP FORGINGS OR CASTINGS.

I have to report that the undermentioned Iron or Steel Forgings or Castings,
 manufactured by The Harbour Forge Co
 of Trine for the Vessel No. 385, being built
 by Messrs Russell & Co of Port Glasgow
 have been inspected by me as set forth below, and found to be, so far as can be seen,
Sound & efficient

Mark on Forgings.

Lloyd's

No. 5017


WH

William Hamilton

Glasgow
13/12/95

	STERN FRAME.	RUDDER FRAME.	STEM.
Material* ...		Scrap iron	
How made ...		Forged	
Dimensions ...		5 1/2 x 4 5/8 x 3	
Progress on Inspection		Forging & smithing	
Date when Inspected		25/9/95 to 13/12/95	

SKETCHES OF FRAMES SHOWING POSITION AND DESCRIPTION OF WELDS OF FORGINGS, OR PARTICULARS OF
 TESTS APPLIED TO CASTINGS.

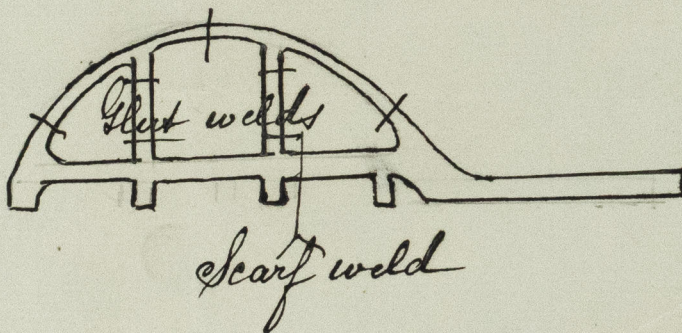

Fee (if any chargeable) £ : :

To be paid at

* If of Iron, state whether scrap or puddled Iron.