

← Web flanged on
face, spaced as per profile

PROPOSED W

PROPOSED WASH PLATE FOR WHALE
S.S. SOUND OF JURA OIL TANKS

SCALE 1" = 1 FOOT.


12. Channel horizontal.
Stiffener in line with
horizontal stiffeners or
transverse bulkheads.
7 side stringers.

Intercoastal.

C.B.
18.3.11

© 2019
Hoyd's Reader
Foundation
444351-0106

Plan showing alteration
to middle line bulkhead
Bkn "Sound of Jura".
ARL 331-0106

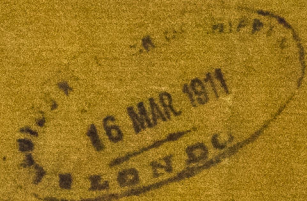

© 2019

Lloyd's Register
Foundation