

"FELICINA" & "Westfield" Greenock Report


# Midship Section

of barquentine

31° 39'

Scale 1/2 inch = one foot

REGISTERED DIMS 210' 0" 35' 6" 19' 6"

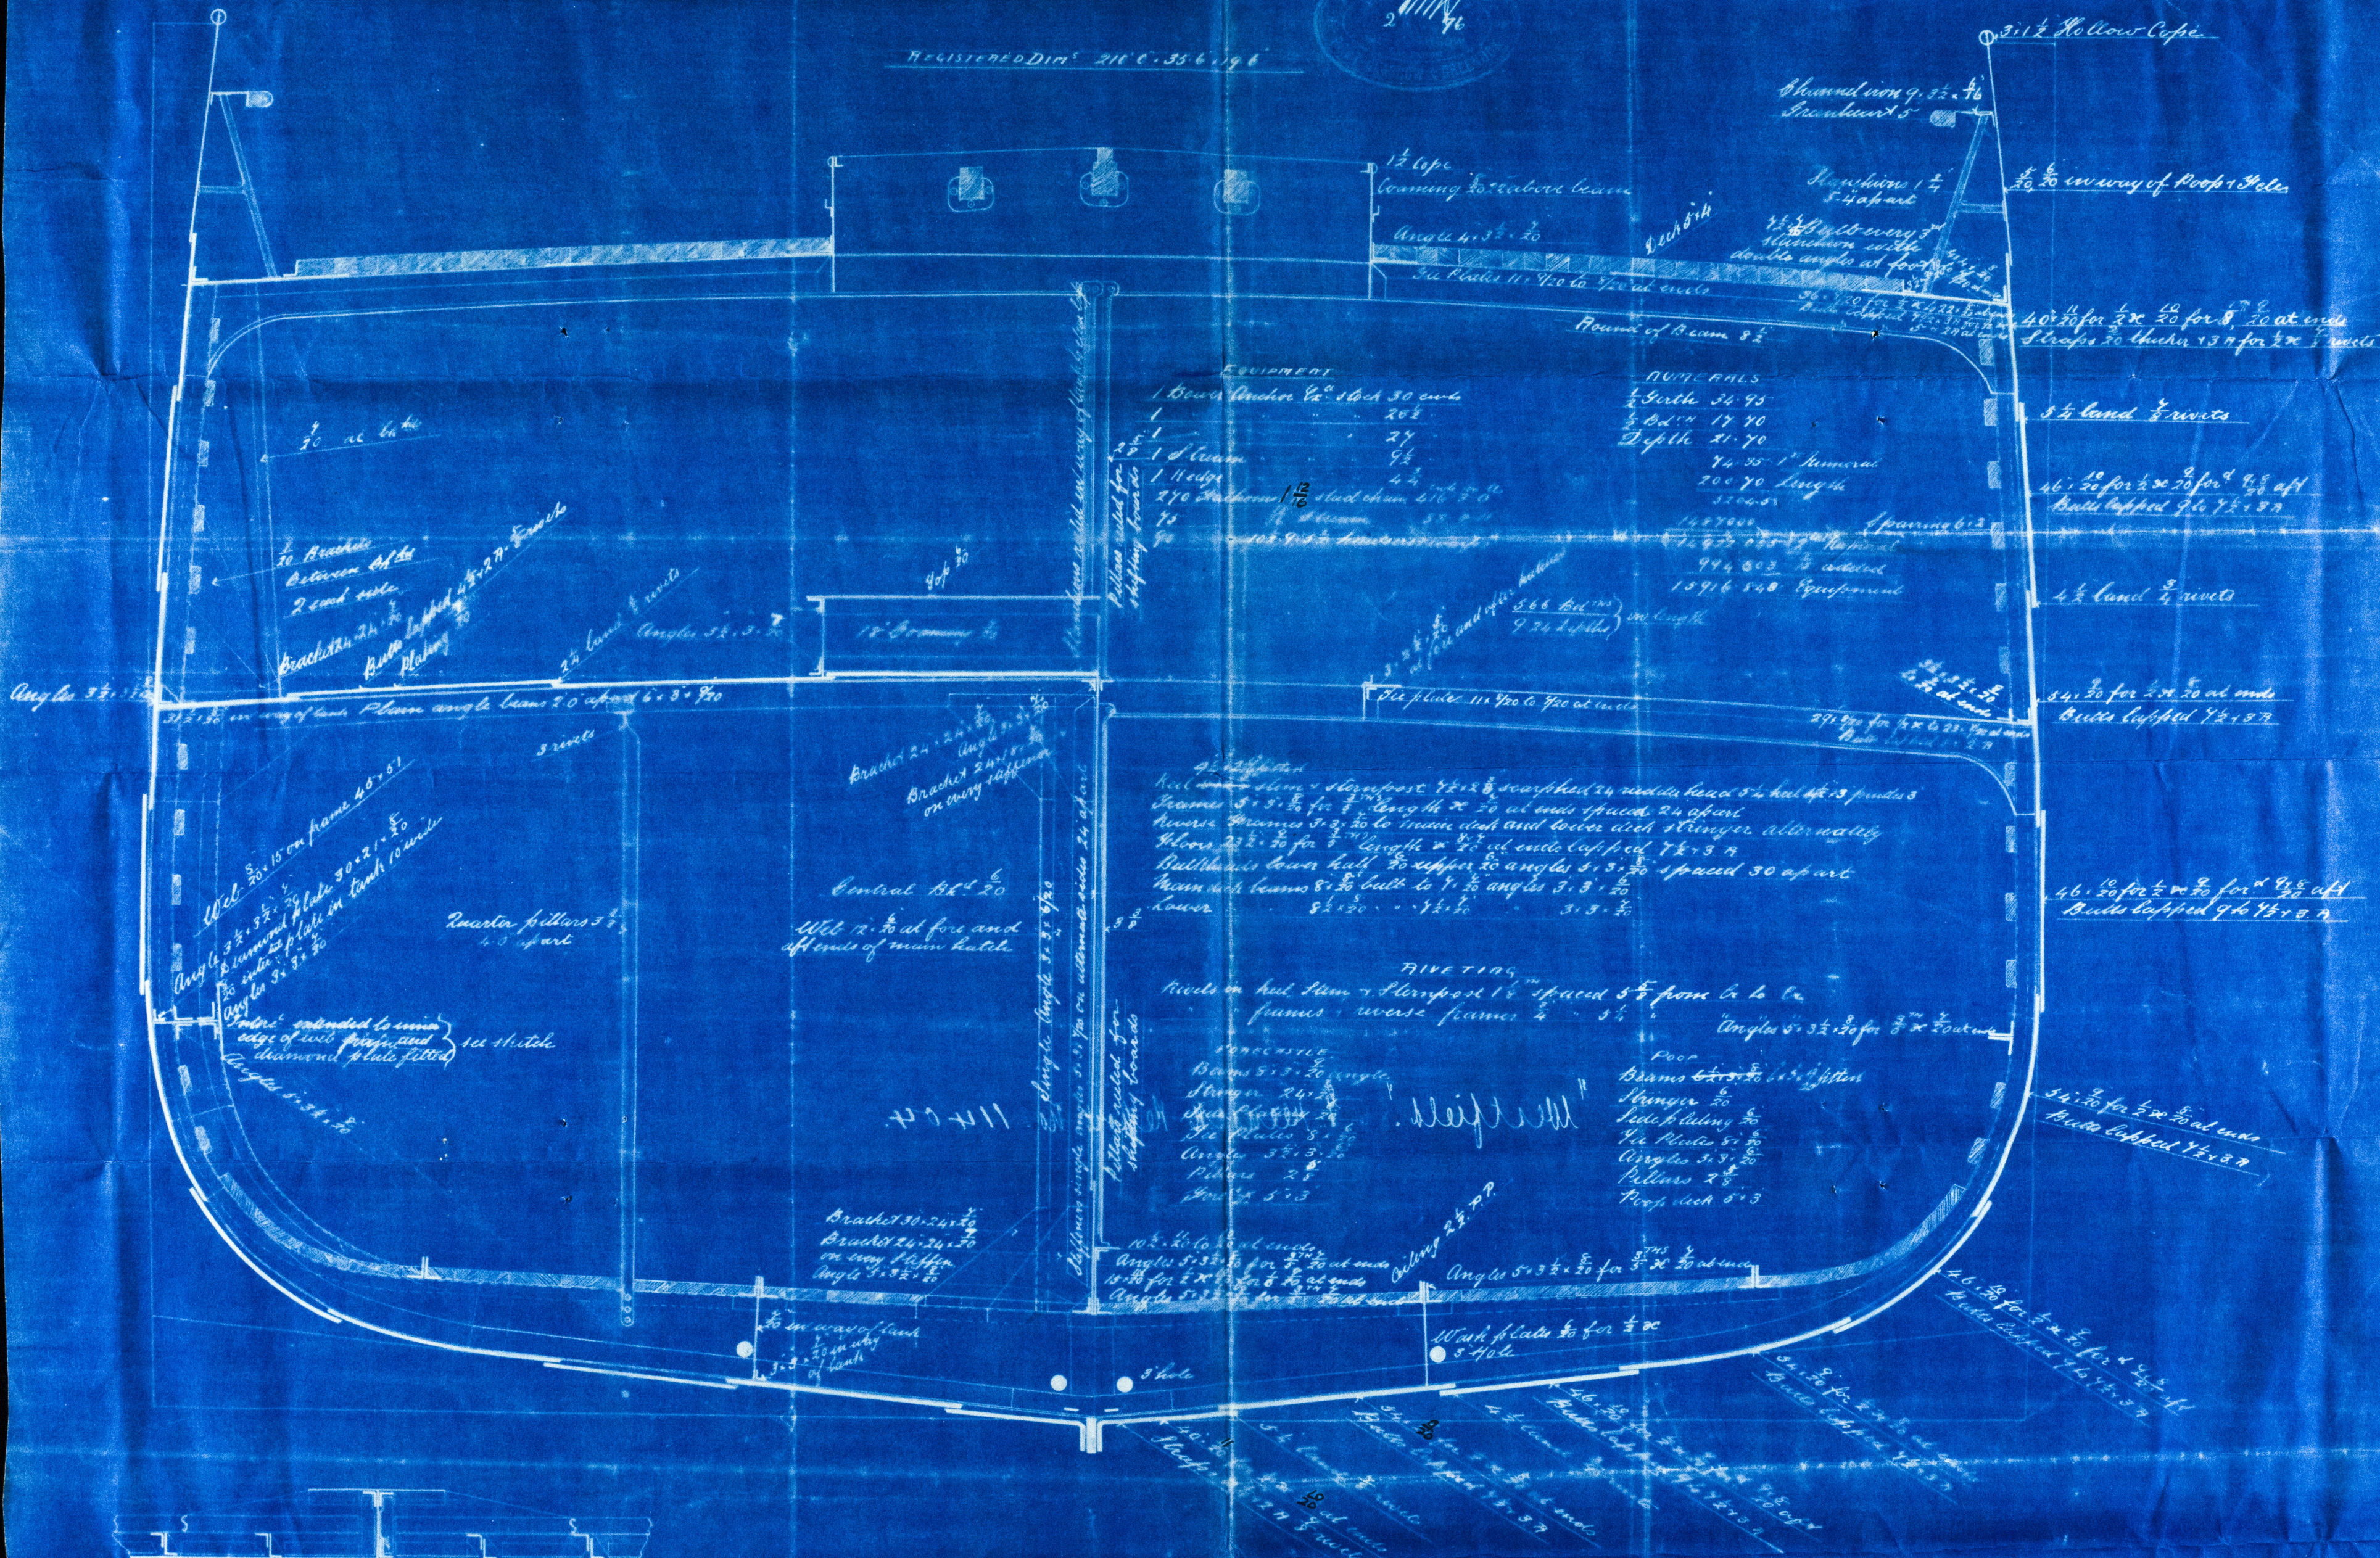

## EQUIPMENT

- 1 Bow Anchor 16" 16" 30 lb
- 1 20 lb
- 1 27 lb
- 1 9 lb
- 1 11 lb
- 270 1/2 lb
- 70 1/2 lb
- 70 1/2 lb

## NUMERICALS

- 1/2 30 95
- 1/2 17 40
- Depth 21 70
- 7 1/2 35 1 1/2
- 200 70 Length
- 3204 57
- 1457 000
- 14 525 000
- 994 503
- 10916 540

Plan of side stringer at web frames in tank



WMS-0-051



S/S. "WESTFIELD" Now FELICIANA.

F.E. RPT N<sup>o</sup> GRK 11404.

BUILT 1896-3.

GRK 333-0131



© 2019

Lloyd's Register  
Foundation