

Lloyd's Register of British and Foreign Shipping.

(Report on Vessel No. 11404 Port Inverness
Westfield)

No. 5125 SHIP FORGINGS OR ~~CASTINGS~~.

The words FORGINGS or CASTINGS, IRON or STEEL, should be struck out as may be required.

I have to report that the undermentioned Iron ~~or Steel~~ Forgings ~~or Castings~~,
manufactured by The Harbour Forge Coy
of Irvine for the Vessel No. 390, being built
by Messrs Russell & Coy of Port Glasgow
have been inspected by me as set forth below, and found to be, so far as can be seen,
Sound & efficient


Mark on Forgings.

Lloyd's
No. 5125
WH.

William Hamilton
Glasgow 24/2/96

| | STERN FRAME. | RUDDER FRAME. | STEM. |
|------------------------|--------------|----------------------------|-------|
| Material* | | <u>Scrap iron</u> | |
| How made | | <u>Forged</u> | |
| Dimensions | | <u>5 1/4 to 4 1/2 x 3</u> | |
| Progress on Inspection | | <u>Forgings mending</u> | |
| Date when Inspected | | <u>14/11/95 to 10/2/96</u> | |

SKETCHES OF FRAMES SHOWING POSITION AND DESCRIPTION OF WELDS OF FORGINGS, OR PARTICULARS OF TESTS APPLIED TO CASTINGS.

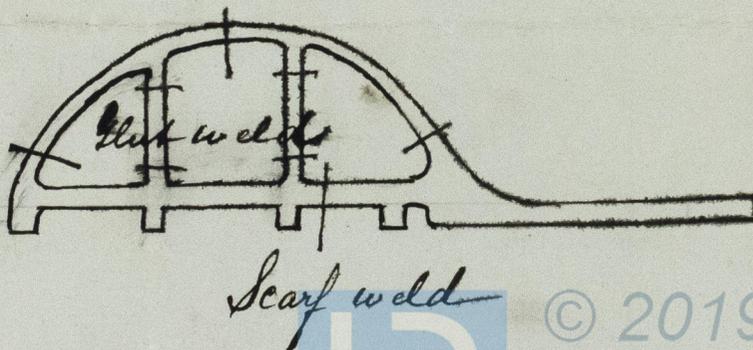

Fee (if any chargeable) £ : :

To be paid at



© 2019

Lloyd's Register
Foundation

J. J. J.
ARH333-0143