

Lloyd's Register of British and Foreign Shipping.

(Report on Vessel No. *11493* Port *Glenbrook*.)No. *5126* SHIP FORGINGS OR CASTINGS.

I have to report that the undermentioned Iron or Steel Forgings or Castings, manufactured by *Messrs Robt Kerr & Sons* of *Irvine* for the Vessel No. *319*, being built by *Messrs A Rodger & Co* of *Port Glasgow* have been inspected by me as set forth below, and found to be, so far as can be seen, *Sound & efficient*

Mark on Forgings.

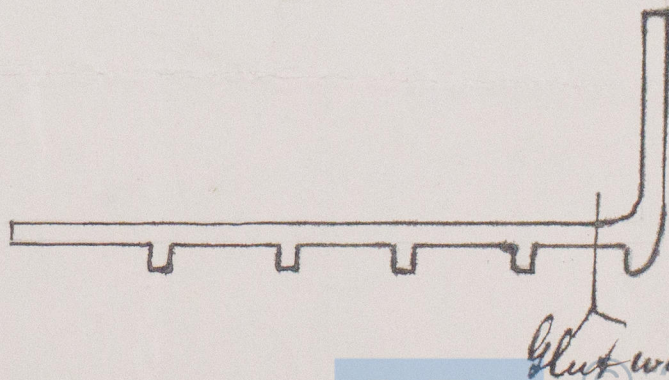
Lloyd's
No. *5126*
W.H

William Hamilton
Glasgow

13/12/95

	STERN FRAME.	RUDDER FRAME.	STEM.
Material*	<i>Scrap iron</i>		<i>Scrap iron</i>
How made	<i>Forged</i>		<i>Forged</i>
Dimensions	<i>10 1/2 x 2 1/2</i>		<i>10 1/2 x 2 1/2</i>
Progress on Inspection	<i>Forging & smithing</i>		<i>Forging</i>
Date when Inspected	<i>12/11/95 to 13/12/95</i>		<i>7. 13/12/95</i>

SKETCHES OF FRAMES SHOWING POSITION AND DESCRIPTION OF WELDS OF FORGINGS, OR PARTICULARS OF TESTS APPLIED TO CASTINGS.

*Butt weld*

Fee (if any chargeable) £ : :

To be paid at